DELHI MRTS PROJECT PHASE III LINE 7

TRAIN CONTROL & SIGNALLING SYSTEM CONTRACT CS03

TRACK AND SIGNALLING PLAN
SIR VISHWESHWARAIAH MOTI BAGH STATION TO HAZRAT NIZAMUDDIN STATION
SECTION-DH

DELHI METRO RAIL CORPORATION LTD.
Metro Bhawan, Fire Brigade Lane, Barakhamba Road, New Delhi-110001

ORIGINATOR:
BOMBARDIER
the evolution of mobility

© 2019, Bombardier Inc.
All rights reserved.

AS-BUILT DRAWING

REV	DATE	DESCRIPTION
8.0	26-JUN-19	AS-BUILT DRAWING

	NAME	DATE
DESIGNED	IRSHAD A.	25-JUN-19
CHECKED	ASHOK K.	26-JUN-19
APPROVED	ROHIT T.	26-JUN-19

DRAWING TITLE: DELHI MRTS PROJECT PHASE III LINE 7
TRAIN CONTROL & SIGNALLING SYSTEM CONTRACT CS03
TRACK AND SIGNALLING PLAN LINE 7
SIR VISHWESHWARAIAH MOTI BAGH STATION TO HAZRAT NIZAMUDDIN STATION
SECTION-DH

DRAWING No:	COST CENTRE:	SCALE	SHEET	CONT.	REV.
100241842	A PRELIMINARIES AND GENERAL REQUIREMENTS	N/S	1	2	8.0

REV.	REVISION INFORMATION	DESIGNED	CHECKED	DATE
8.0	AS-BUILT RELEASED	IRSHAD A.	ASHOK K.	26-JUN-19
7.4	UPDATED AS PER REVIEWER COMMENTS DATED 12-APR-2019	IRSHAD A.	ASHOK K.	25-JUN-19
	-UPDATED WNRA & CCTV CHAINAGES			
	-UPDATED POINT MACHINE POSITION P0301 FROM LH TO RH & P0302 FROM RH TO LH SIDE AT SHEET 17			
	-ADDED WNRA03080 AT SHEET 26			
7.3	ADDED WNRA & CCTV AS PER RF SCHEMATIC DOCUMENT NO. 100246694	IRSHAD A.	ASHOK K.	04-APR-19
7.2	-UPDATED NSZ CHAINAGES AS PER THE ATS-TVS ICD	KULDEEP M.	ASHOK K.	08-FEB-18
	-UPDATED FOLLOWING AS PER THE REVIEWER'S COMMENTS BASED ON MoR DATED 08-FEB-18			
	UPDATED THE LAYOUT SETTINGS TO REMOVE REPITION OF SIGNALLING AREAS.			
	UPDATED THE PAGE NUMBERING			
	ADDED NOTES AT CROSSOVER PROFILE SHEETS AND ASHRAM STATION.			
7.1	-UPDATED FOLLOWING AS PER THE CBTC MAP SURVEY REPORT.	KULDEEP M.	ASHOK K.	01-FEB-18
	ADDED NORMING POINT DATA INTO THE SIGNALLING PLAN			
	UPDATED CHAINAGES OF SIGNALS, AX COUNTERS, PLATFORM CENTER, BUFFER STOP AND TRACK SECTION LENGTHS.			
	UPDATED THE FOULING MARK CHAINAGES.			
	REMOVED THE FIXED RED LIGHTS & BUFFER STOPS AND EOT AT LJPN			
7.0	RELEASED	KULDEEP M.	ASHOK K.	30-JUL-18
6.1	AS PER FCO-DL7-2018-055 & NCR bkk_067#1697, ADDED TWO FIXED LED LIGHTS AT THE END OF LJPN STATION ON BOTH	KULDEEP M.	ASHOK K.	30-JUL-18
	UP AND DOWN LINES.			
6.0	RELEASED	KULDEEP M.	ASHOK K.	10-MAY-18
5.2	UPDATED AS PER NCR bkk_067#1143	KULDEEP M.	ASHOK K.	10-MAY-18
	UPDATE PSD SYMBOL FOR PF03617			
	CURVE SIGN UPDATED FOR CURVE R=480.015, CL=32.300 AT UP TRACK.			

REVISION INFORMATION

DELHI METRO RAIL CORPORATION LTD.
Metro Bhawan, Fire Brigade Lane, Barakhamba Road, New Delhi-110001

ORIGINATOR:
BOMBARDIER
the evolution of mobility

© 2019, Bombardier Inc.
All rights reserved.

AS-BUILT DRAWING

REV	DATE	DESCRIPTION
8.0	26-JUN-19	AS-BUILT DRAWING

	NAME	DATE
DESIGNED	IRSHAD A.	25-JUN-19
CHECKED	ASHOK K.	26-JUN-19
APPROVED	ROHIT T.	26-JUN-19

DRAWING TITLE: DELHI MRTS PROJECT PHASE III LINE 7
TRAIN CONTROL & SIGNALLING SYSTEM CONTRACT CS03
TRACK AND SIGNALLING PLAN LINE 7
SIR VISHWESHWARAIAH MOTI BAGH STATION TO HAZRAT NIZAMUDDIN STATION
SECTION-DH

DRAWING No:	COST CENTRE:	SCALE	SHEET	CONT.	REV.
100241842	A PRELIMINARIES AND GENERAL REQUIREMENTS	N/S	2	3	8.0

REV.	REVISION INFORMATION	DESIGNED	CHECKED	DATE
5.1	UPDATED TRACK PROFILES AS PER THE TRACK AS-BUILT RECEIVED EMAIL DATED 25TH & 30TH APRIL 18.	KULDEEP M.	ASHOK K.	04-MAY-18
	ADDED PROFILES FOR NIZAMUDDIN CROSS-OVERS AND DOWN LOOP.			
	ADDED PROFILE FOR LAJPAT NAGAR CROSSOVER.			
5.0	RELEASED	KULDEEP M.	ASHOK K.	27-MAR-18
4.3	UPDATED AS PER CUSTOMER REQUIREMENT AND NCR bkk_067#1487	KULDEEP M.	ASHOK K.	26-MAR-18
	ALL CHANGES ARE DONE IN LAYER "REV 4.3" AND MARKED IN COLOUR RED.			
	ADDED A VIRTUAL SIGNAL VS03367 ON TRACK T03075 IN DOWN DIRECTION AT HAZRAT NIZAMUDDIN.			
	ADDED A VIRTUAL SIGNAL VS03368 ON TRACK T03064 IN UP DIRECTION AT HAZRAT NIZAMUDDIN.			
4.2	UPDATED AS PER REVIEWER'S COMMENTS DATED:- 25-JUL-17	ASHOK K.	JAYA S.	04-AUG-17
	UPDATED AS NCR_bkk_067#854			
	-UPDATED AX COUNTER NUMBER FROM T02091/T03001 TO T02089/T03001 FOR DN LINE AT REGION BOUNDRY			
	-UPDATED AX COUNTER NUMBER FROM T02090/T03002 TO T02086/T03002 FOR UP LINE AT REGION BOUNDRY			
4.1	ALL CHANGES ARE DONE IN "AS-BUILT4.1" LAYER IN ORDER TO HAVE A CLEAR VIEW	ASHOK K.	JAYA S.	26-JUL-17
	UPDATED SPEED AND CURVE PROFILES FROM SVMB TO SOEN PLATFORM (SEE INPUT DRAWINGS IN REFERENCE SHEET)			
4.0	RELEASED	JAYA S.	VARUN C.	07-MAR-17
3.6	UPDATED AS PER REVIEWER'S COMMENTS	JAYA S.	VARUN C.	06-MAR-17
3.5	ALL THE CHANGES ARE REFELCTED IN RED CLOUD IN SEPARATE LAYER "CHANGE":-	JAYA S.	VARUN C.	16-FEB-17
	A) UPDATED CHAINAGES AND PROFILES AS PER LATEST GAD OF CC-24 (MENTIONED IN REFERENCE SHEET)			
	B) UPDATED PSEUDO PLATFORM AT NIZM SIDING (REFER DMRC BKK VISIT MoM-Dec 13th to 16th, 2016)			
	C) ADJUSTED CHAINAGES TO ONE DECIMAL PLACE			
	D) UPDATED NOTES ON LONG SHEET			
	E) UPDATED TURNOUT SPEEDS ON LONG SHEET			
	F) UPDATED BOTH PLATFORM TRACK LENGTH AT LJPN TO 180M			
3.4	UPDATED POSITIVE AND ZERO GRADE CHAINAGES AND STRAIGHT LINE SPEED OF 95KMPH	RUNA S.	VARUN C.	07-OCT-16
3.3	UPDATED GRADIENT AT CC24 & CC-26R AS PER EMAIL FROM INTERFACE DATED 12.09.2016	JAYA S.	VARUN C.	22-SEP-16
	--UPDATED COMMENTS AS PER CUSTOMER COMMENTS DATED 04/05/2015			
	OVERLAP AT NIZM REDUCED TO 32m			
3.2	-UPDATED CHAINGE OF T03026/T03028,T03032/T03034,VS03359,VS03357	JAYA S.	VARUN C.	12-FEB-16
	-UPDATED NSZ LOCATIONS BASED ON TVS SCHEMATIC DIAGRAM REV 1 DATED 10.08.201 RECVD ON 02/11/2015			
3.1	-UPDATED NEUTRAL SECTION CHAINAGE AS PER LETTER DMRC/134/14/RS9/INTERFACE/2520 DATED 13.04.2015	JAYA S.	VARUN C.	03-SEP-15
	-UPDATED NSZ LOCATIONS BASED ON TVS SCHEMATIC DIAGRAM REV 1 DATED 10.08.2015			
3.0	-RELEASED	SANDEEP T.	VARUN C.	04-MAY-15
2.2	-UPDATED GRADIENT UP LINE PROFILE	SANDEEP T.	VARUN C.	22-APR-15
	-ADD 1 NO AXLE COUNTER HEAD AT HAZRAT NIZAMUDDIN STATION			
2.1	-UPDATED AS PER NEW GAD CC-24 R-13	SANDEEP T.	VARUN C.	27-JAN-15
2.0	-RELEASED	SANDEEP T.	VARUN C.	29-AUG-14
1.2	-UPDATED AS PER MOR REV0.1 DATED: 29-AUG-14	SANDEEP T.	VARUN C.	29-AUG-14
1.1	-UPDATED AS PER DMRC/S&T/CS03/PH-III/BT-SUB/11/482	SANDEEP T.	VARUN C.	26-AUG-14
1.0	-RELEASED	SANDEEP T.	DHRUVESH B.	16-JUN-14
0.3	-UPDATED AS PER NUMBERING SCHEME Rev 6.0	SANDEEP T.	DHRUVESH B.	12-JUN-2014
0.2	-UPDATED AS PER MOR0.1 DATED:21-APR-14	SANDEEP T.	JAYA S.	21-APR-2014
0.1	-FIRST DRAFT	SANDEEP T.	JAYA S.	18-APR-2014

REVISION INFORMATION

DELHI METRO RAIL CORPORATION LTD.
Metro Bhawan, Fire Brigade Lane, Barakhamba Road, New Delhi-110001

ORIGINATOR:
BOMBARDIER
the evolution of mobility

© 2019, Bombardier Inc.
All rights reserved.

AS-BUILT DRAWING

REV	DATE	DESCRIPTION
8.0	26-JUN-19	AS-BUILT DRAWING

	NAME	DATE
DESIGNED	IRSHAD A.	25-JUN-19
CHECKED	ASHOK K.	26-JUN-19
APPROVED	ROHIT T.	26-JUN-19

DRAWING TITLE: DELHI MRTS PROJECT PHASE III LINE 7
TRAIN CONTROL & SIGNALLING SYSTEM CONTRACT CS03
TRACK AND SIGNALLING PLAN LINE 7
SIR VISHWESHWARAIAH MOTI BAGH STATION TO HAZRAT NIZAMUDDIN STATION
SECTION-DH

DRAWING No:	COST CENTRE:	SCALE	SHEET	CONT.	REV.
100241842	A PRELIMINARIES AND GENERAL REQUIREMENTS	N/S	3	4	8.0

SHEET NO.	DOCUMENT NUMBER	REV.	LIST OF REFERENCE DOCUMENT
		7.0	RF SCHEMATIC REGION 3
17	100246694	9.2	ATS-TUNNEL VENTILATION SYSTEM INTERFACE DOCUMENT
16	100244698	9.2	ATS-TUNNEL VENTILATION SYSTEM INTERFACE DOCUMENT
15	100335378	3.0	CBTC DATA SUMMARY (SITE SURVEY REPORT) REGION-4 (MVPI-IPE)
14	20-04-2018 LAJPAT NAGAR TO SHIV VIHAR-AS-BUILT-PP-r2	-	DETAILS OF NEUTRAL SECTIONS IN LINE 7 (MUKUNDPUR - SHIV VIHAR) (SIDING RAKE NIZAMUDDIN PROFILE RECEIVED VIA EMAIL DATED 30-04-2018)
13	20-04-2018 LAJPAT NAGAR TO SHIV VIHAR-AS-BUILT-PP-r2	-	DETAILS OF PROFILES FROM LAJPAT NAGAR TO SHIV VIHAR (UP AND DOWN LINE) (RECEIVED 25-04-2018)
12	DMRC\MUKUND PUR TO LAJPAT NAGAR\IRCON\CT-1A\AS-BUILT\DN LINE\DWG-MTS-17 SHEET 8 TO 21	-	PLAN & PROFILES OF DN LINE FROM SOUTH EXTENSION TO LAJPAT NAGAR (RECEIVED 05-OCT-2017)
11	DMRC/ELECT/RC-1/TR/CE-7/LOT-1/OHE/876 DATED 07.07.2015	-	DETAILS OF NEUTRAL SECTIONS IN LINE 7 (MUKUNDPUR - SHIV VIHAR)
10	DMRC/S&T/CS03/Ph-III/56-D/II/1206 DATED 19.5.2016	-	CONTRACT CS03-SPEEDS OF TRAINS IN LINE 7
09	EMAIL FROM INTERFACE REGARDING GRADIENT AT CC-24 & CC-26R BOUNDARY FOR UP & DN LINE(DATED 12.09.2016)	-	
08	VL-L7-TVS-NSZ-01	R1	TVS SCHEMATIC DIAGRAM FOR NON STOPPING ZONE (BHIKAJI CAMA PLACE TO HAZRAT NIZAMUDDIN STATION)
07	H.Y./MP-SV/ELEV/GA/0001 (SHEET 1 & 2)	R3	GENERAL ALIGNMENT PLAN H. NIZAMUDDIN TO SHIV VIHAR (UP LINE & DN LINE)
06	CC-24/GAD/AP/1/U (SHEET 1 TO 7)	R14	UPLINE TRACK ALIGNMENT PLAN AND PROFILE (LAJPAT NAGAR TO HAZRAT NIZAMUDDIN CORRIDOR OF DELHI MRTS)
05	CC-24/GAD/AP/1/D (SHEET 1 TO 7)	R14	DOWNLINE TRACK ALIGNMENT PLAN AND PROFILE (LAJPAT NAGAR TO HAZRAT NIZAMUDDIN CORRIDOR OF DELHI MRTS)
04	18-C-AL-GAD-002 (SHEET 1 TO 6)	R4	TUNNEL ALIGNMENT PLAN & LONGITUDINAL SECTION MOTI BAGH TO LAJPAT NAGAR(UP LINE)
03	18-C-AL-GAD-001 (SHEET 1 TO 6)	R4	TUNNEL ALIGNMENT PLAN & LONGITUDINAL SECTION MOTI BAGH TO LAJPAT NAGAR(DOWN LINE)
02	DMRC/PH-III/CPM-2/GAD/CC17 (SHEET 5 & 6)	R12	UP LINE GENERAL ALIGNMENT PLAN DELHI CANTT. TO BHIKAJI CAMA
01	DMRC/PH-III/CPM-2/GAD/CC17 (SHEET 5 AND 6)	R3	DOWN LINE GENERAL ALIGNMENT PLAN DELHI CANTT. TO BHIKAJI CAMA

REFERENCE DOCUMENT

DELHI METRO RAIL CORPORATION LTD.
Metro Bhawan, Fire Brigade Lane, Barakhamba Road, New Delhi-110001

ORIGINATOR:
BOMBARDIER
the evolution of mobility

© 2019, Bombardier Inc.
All rights reserved.

AS-BUILT DRAWING

REV	DATE	DESCRIPTION
8.0	26-JUN-19	AS-BUILT DRAWING

	NAME	DATE
DESIGNED	IRSHAD A.	25-JUN-19
CHECKED	ASHOK K.	26-JUN-19
APPROVED	ROHIT T.	26-JUN-19

DRAWING TITLE:
DELHI MRTS PROJECT PHASE III LINE 7
TRAIN CONTROL & SIGNALLING SYSTEM CONTRACT CS03
TRACK AND SIGNALLING PLAN LINE 7
SIR VISHWESHWARAIAH MOTI BAGH STATION TO HAZRAT NIZAMUDDIN STATION
SECTION-DH

DRAWING No:	COST CENTRE:	SCALE	SHEET	CONT.	REV.
100241842	A PRELIMINARIES AND GENERAL REQUIREMENTS	N/S	4	5	8.0

SYMBOLS USED IN THE TRACK AND SIGNALLING PLAN

SYMBOL	DESCRIPTION
1 SXXYYY M.D.S.T FOR ELEVATED SXXYYY SXXYYY M.D.S.T FOR UNDERGROUND (WALL MOUNT) SXXYYY	ROUTE INDICATOR — M FOR MAIN LINE GREEN ASPECT — D FOR FIRST DIVERSION VIOLET ASPECT — S FOR SECOND DIVERSION RED ASPECT — T FOR THIRD DIVERSION 3 – ASPECT SIGNAL "XX" = REGION NO. "YYY" = OBJECT NUMBERING (201–300)
2 SXXXXY SAABBB M.D.S.T	POINT PROTECTION SIGNAL "XXXX" = POINT NO. "Y" = DIRECTION OF TRAVEL "AA" = REGION NO. "BBB" = OBJECT NUMBERING (201–300)
3 SXXYYY	SHUNT SIGNAL "XX" = REGION NO. "YYY" = OBJECT NUMBERING (301–500)
4 SXXYYY	DEPENDENT SHUNT SIGNAL "XX" = REGION NO. "YYY" = OBJECT NUMBERING (301–500)
5 SXXYYY FOR ELEVATED/GROUND SXXYYY FOR UNDERGROUND (WALL MOUNT)	BUFFER STOP SIGNAL "XX" = REGION NO. "YYY" = OBJECT NUMBERING (301–350) FOR MAINLINE "YYY" = OBJECT NUMBERING (501–600) FOR DEPOT
6 VSXXYYY	VIRTUAL SIGNAL "XX" = REGION NO. "YYY" = OBJECT NUMBERING (351–400) FOR MAINLINE "YYY" = OBJECT NUMBERING (601–700) FOR DEPOT
7 PXXYY	POINT MACHINE "XX" = REGION NO. "YY" = OBJECT NUMBERING (01–99) = EEA–5 (MAIN LINE) = RDL2 (DEPOT)
8	FOULING POINT (POSITION SHALL BE CONFIRMED AT SITE)
9	ELECTRICAL KEY TRANSMITTER "X" = EKT GROUP NUMBER (I.E. EKT#1 FOR GROUP NO.1) NOTE: STARTING NUMBER "1" IN EVERY STATION
10 TXXYYY	AXLE COUNTER SECTION "XX" = REGION NO. "YYY" = OBJECT NUMBERING (001–200) FOR MAINLINE "YYY" = OBJECT NUMBERING (001–300) FOR DEPOT
11 TXXYYY TXXYYY	AXLE COUNTER AXLE COUNTER LOCATED WITHIN FOULING AREA

SYMBOL	DESCRIPTION
12	NEUTRAL SECTION
13	NON STOPPING ZONE
14	BUFFER STOP AND END OF TRACK
15 85 km/h CIVIL SPEED	FROM CIVIL ENGINEERING POINT OF VIEW THE LIMITATION SPEED IS 85 km/h
16 1.500% L=100m	GRADIENT 1.5 GRADIENT LENGTH IS 100 (m)
17 R= 400.000 m L= 800.000 m	CURVE RADIUS IS 400 m CURVE LENGTH IS 800 m
18 KM. 9+911	MILEAGE IS 9911 (m)
19 ITI & OCB	ITI : INTERLOCKING TO INTERLOCKING BORDER (REGION BORDER) & OBJECT CONTROLLER TO OBJECT CONTROLLER BOUNDARY
20 DOWN UP	NORMAL DIRECTION OF TRAFFIC
21	STATION WITH CBI AND OC
22	STATION WITH OC
23 ESPXXYYY	EMERGENCY STOP PLUNGER (ESP) "XX" = REGION NO. "YYY" = OBJECT NUMBERING (501–600) FOR MAINLINE "YYY" = OBJECT NUMBERING (701–750) FOR DEPOT
24 PLATFORM PFXXYYY	PLATFORM "XX" = REGION NO. "YYY" = OBJECT NUMBERING (601–650) FOR MAINLINE "YYY" = OBJECT NUMBERING (751–800) FOR DEPOT
25 PSEUDO PPXXYYY	PSEUDO PLATFORM "XX" = REGION NO. "YYY" = OBJECT NUMBERING (651–700) FOR MAINLINE "YYY" = OBJECT NUMBERING (801–850) FOR DEPOT

SYMBOL	DESCRIPTION
26 NPXXYYY	NORMING POINT "XX" = REGION No. "YYY" = OBJECT NUMBERING (001–999)
27 WNRAXXYYY	PAIR OF WAYSIDE NETWORK RADIO ASSEMBLY (WNRA) "XX" = REGION NO. "YYY" = OBJECT NUMBERING (001–200) FOR MAINLINE "YYY" = OBJECT NUMBERING (701–900) FOR DEPOT
28 CCTVXXYYY	PAIR OF CLOSED CIRCUIT TELEVISION (CCTV) "XX" = REGION NO. "YYY" = OBJECT NUMBERING (001–200) FOR MAINLINE "YYY" = OBJECT NUMBERING (701–900) FOR DEPOT
29	SINGLE OF LINE–OF–SIGHT (LOS) ANTENNA
30	PAIR OF LINE–OF–SIGHT (LOS) ANTENNA
31	LEAKY FEEDER CABLE
32 AE	ATC ENDS MARKER BOARD
33 AB	ATC BEGINS MARKER BOARD
34 XC	NORMAL STOPPING MARKER BOARD XC = NUMBER OF CAR
35 SR XC FOR MAINLINE	SR = STOPPING REVERSE MARKER BOARD XC = NUMBER OF CAR
36 STOP	STOP BOARD
37	TRAP POINT
38 OCB	OCB : OBJECT CONTROLLER TO OBJECT CONTROLLER (BOUNDARY)
39 PSDXXYYY FOR MAINLINE PSDXXYYY FOR DEPOT	PLATFORM SCREEN DOOR "XX" = REGION NO. "YYY" = OBJECT NUMBERING (601–650) FOR MAINLINE "YYY" = OBJECT NUMBERING (801–850) FOR DEPOT

DELHI METRO RAIL CORPORATION LTD.
Metro Bhawan, Fire Brigade Lane, Barakhamba Road, New Delhi-110001

ORIGINATOR:
BOMBARDIER
the evolution of mobility

© 2019, Bombardier Inc. All rights reserved.

AS-BUILT DRAWING

REV	DATE	DESCRIPTION
8.0	26–JUN–19	AS–BUILT DRAWING

	NAME	DATE
DESIGNED	IRSHAD A.	25–JUN–19
CHECKED	ASHOK K.	26–JUN–19
APPROVED	ROHIT T.	26–JUN–19

DRAWING TITLE: DELHI MRTS PROJECT PHASE III LINE 7
TRAIN CONTROL & SIGNALLING SYSTEM CONTRACT CS03
TRACK AND SIGNALLING PLAN LINE 7
SIR VISHWESHWARAIAH MOTI BAGH STATION TO HAZRAT NIZAMUDDIN STATION
SECTION-DH

DRAWING No:	COST CENTRE:	SCALE	SHEET	CONT.	REV.
100241842	A PRELIMINARIES AND GENERAL REQUIREMENTS	N/S	5	6	8.0

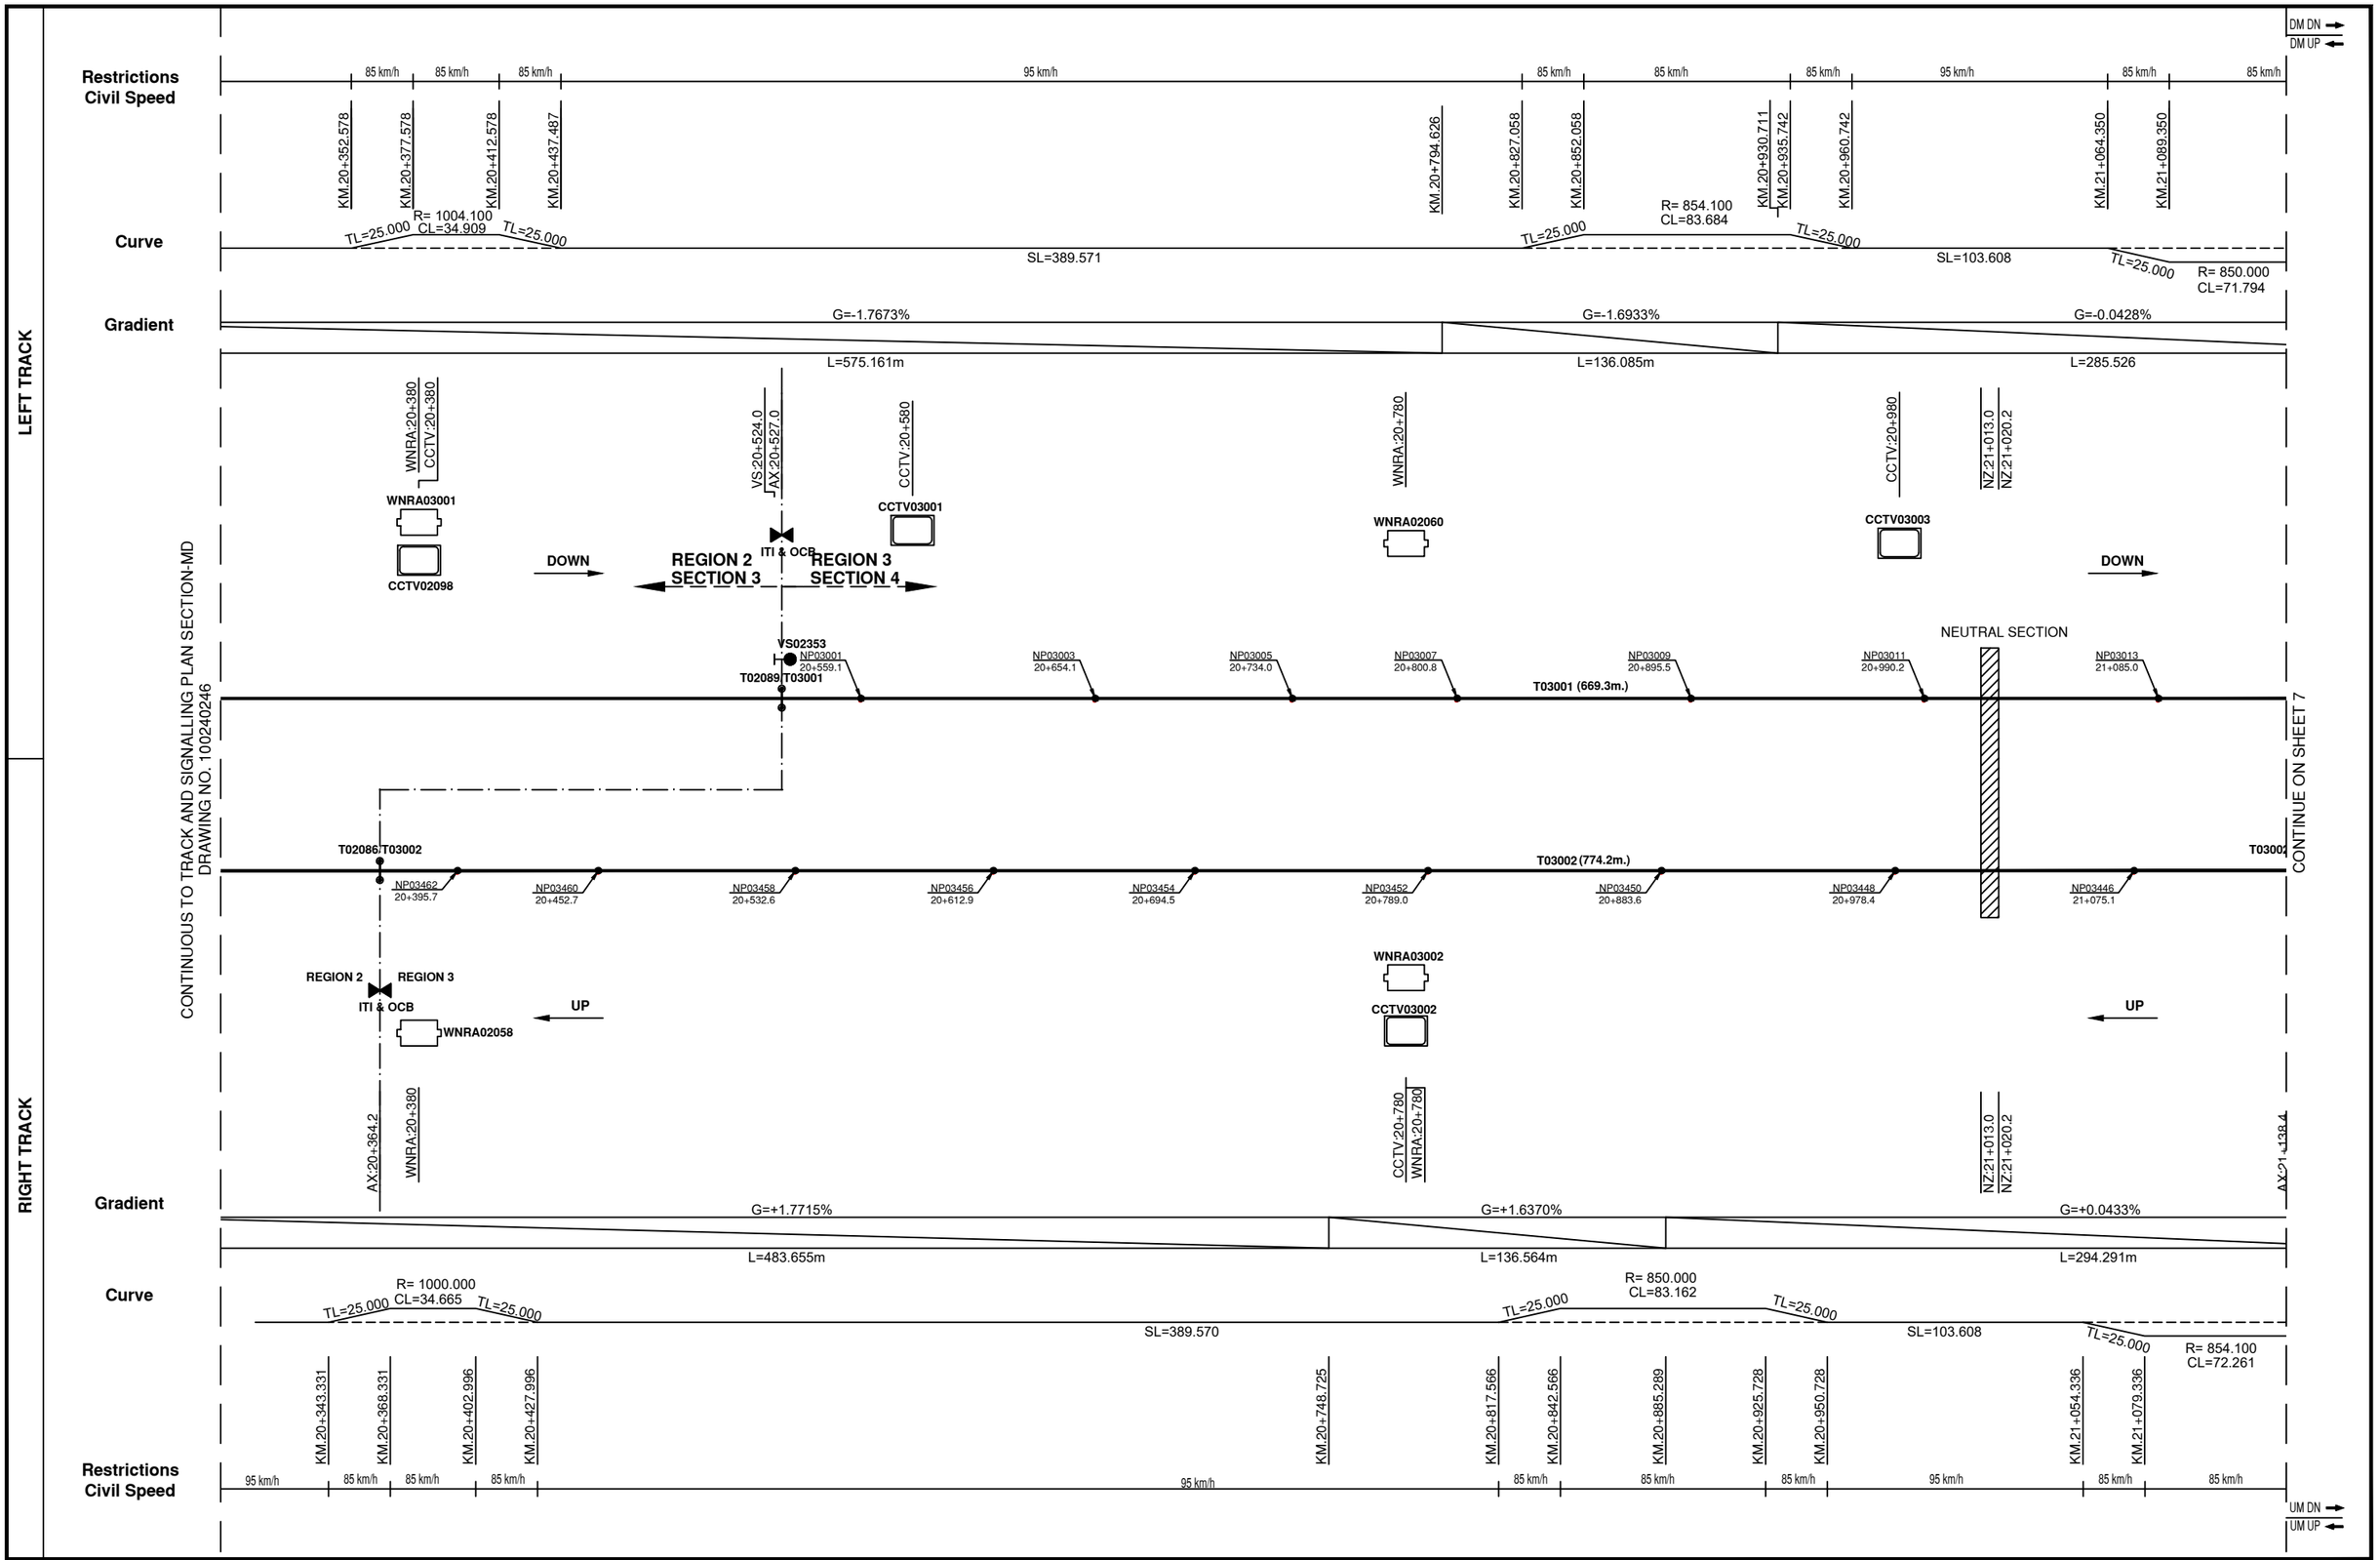

DELHI METRO RAIL CORPORATION LTD.
Metro Bhawan, Fire Brigade Lane, Barakhamba Road, New Delhi-110001

ORIGINATOR:
BOMBARDIER
the evolution of mobility

© 2019, Bombardier Inc.
All rights reserved.

AS-BUILT DRAWING

REV	DATE	DESCRIPTION
8.0	26-JUN-19	AS-BUILT DRAWING

	NAME	DATE
DESIGNED	IRSHAD A.	25-JUN-19
CHECKED	ASHOK K.	26-JUN-19
APPROVED	ROHIT T.	26-JUN-19

DRAWING TITLE: DELHI MRTS PROJECT PHASE III LINE 7
TRAIN CONTROL & SIGNALLING SYSTEM CONTRACT CS03
TRACK AND SIGNALLING PLAN LINE 7
SIR VISHWESHWARAIAH MOTI BAGH STATION TO HAZRAT NIZAMUDDIN STATION
SECTION-DH

DRAWING No:	COST CENTRE:	SCALE	SHEET	CONT.	REV.
100241842	A PRELIMINARIES AND GENERAL REQUIREMENTS	N/S	6	7	8.0

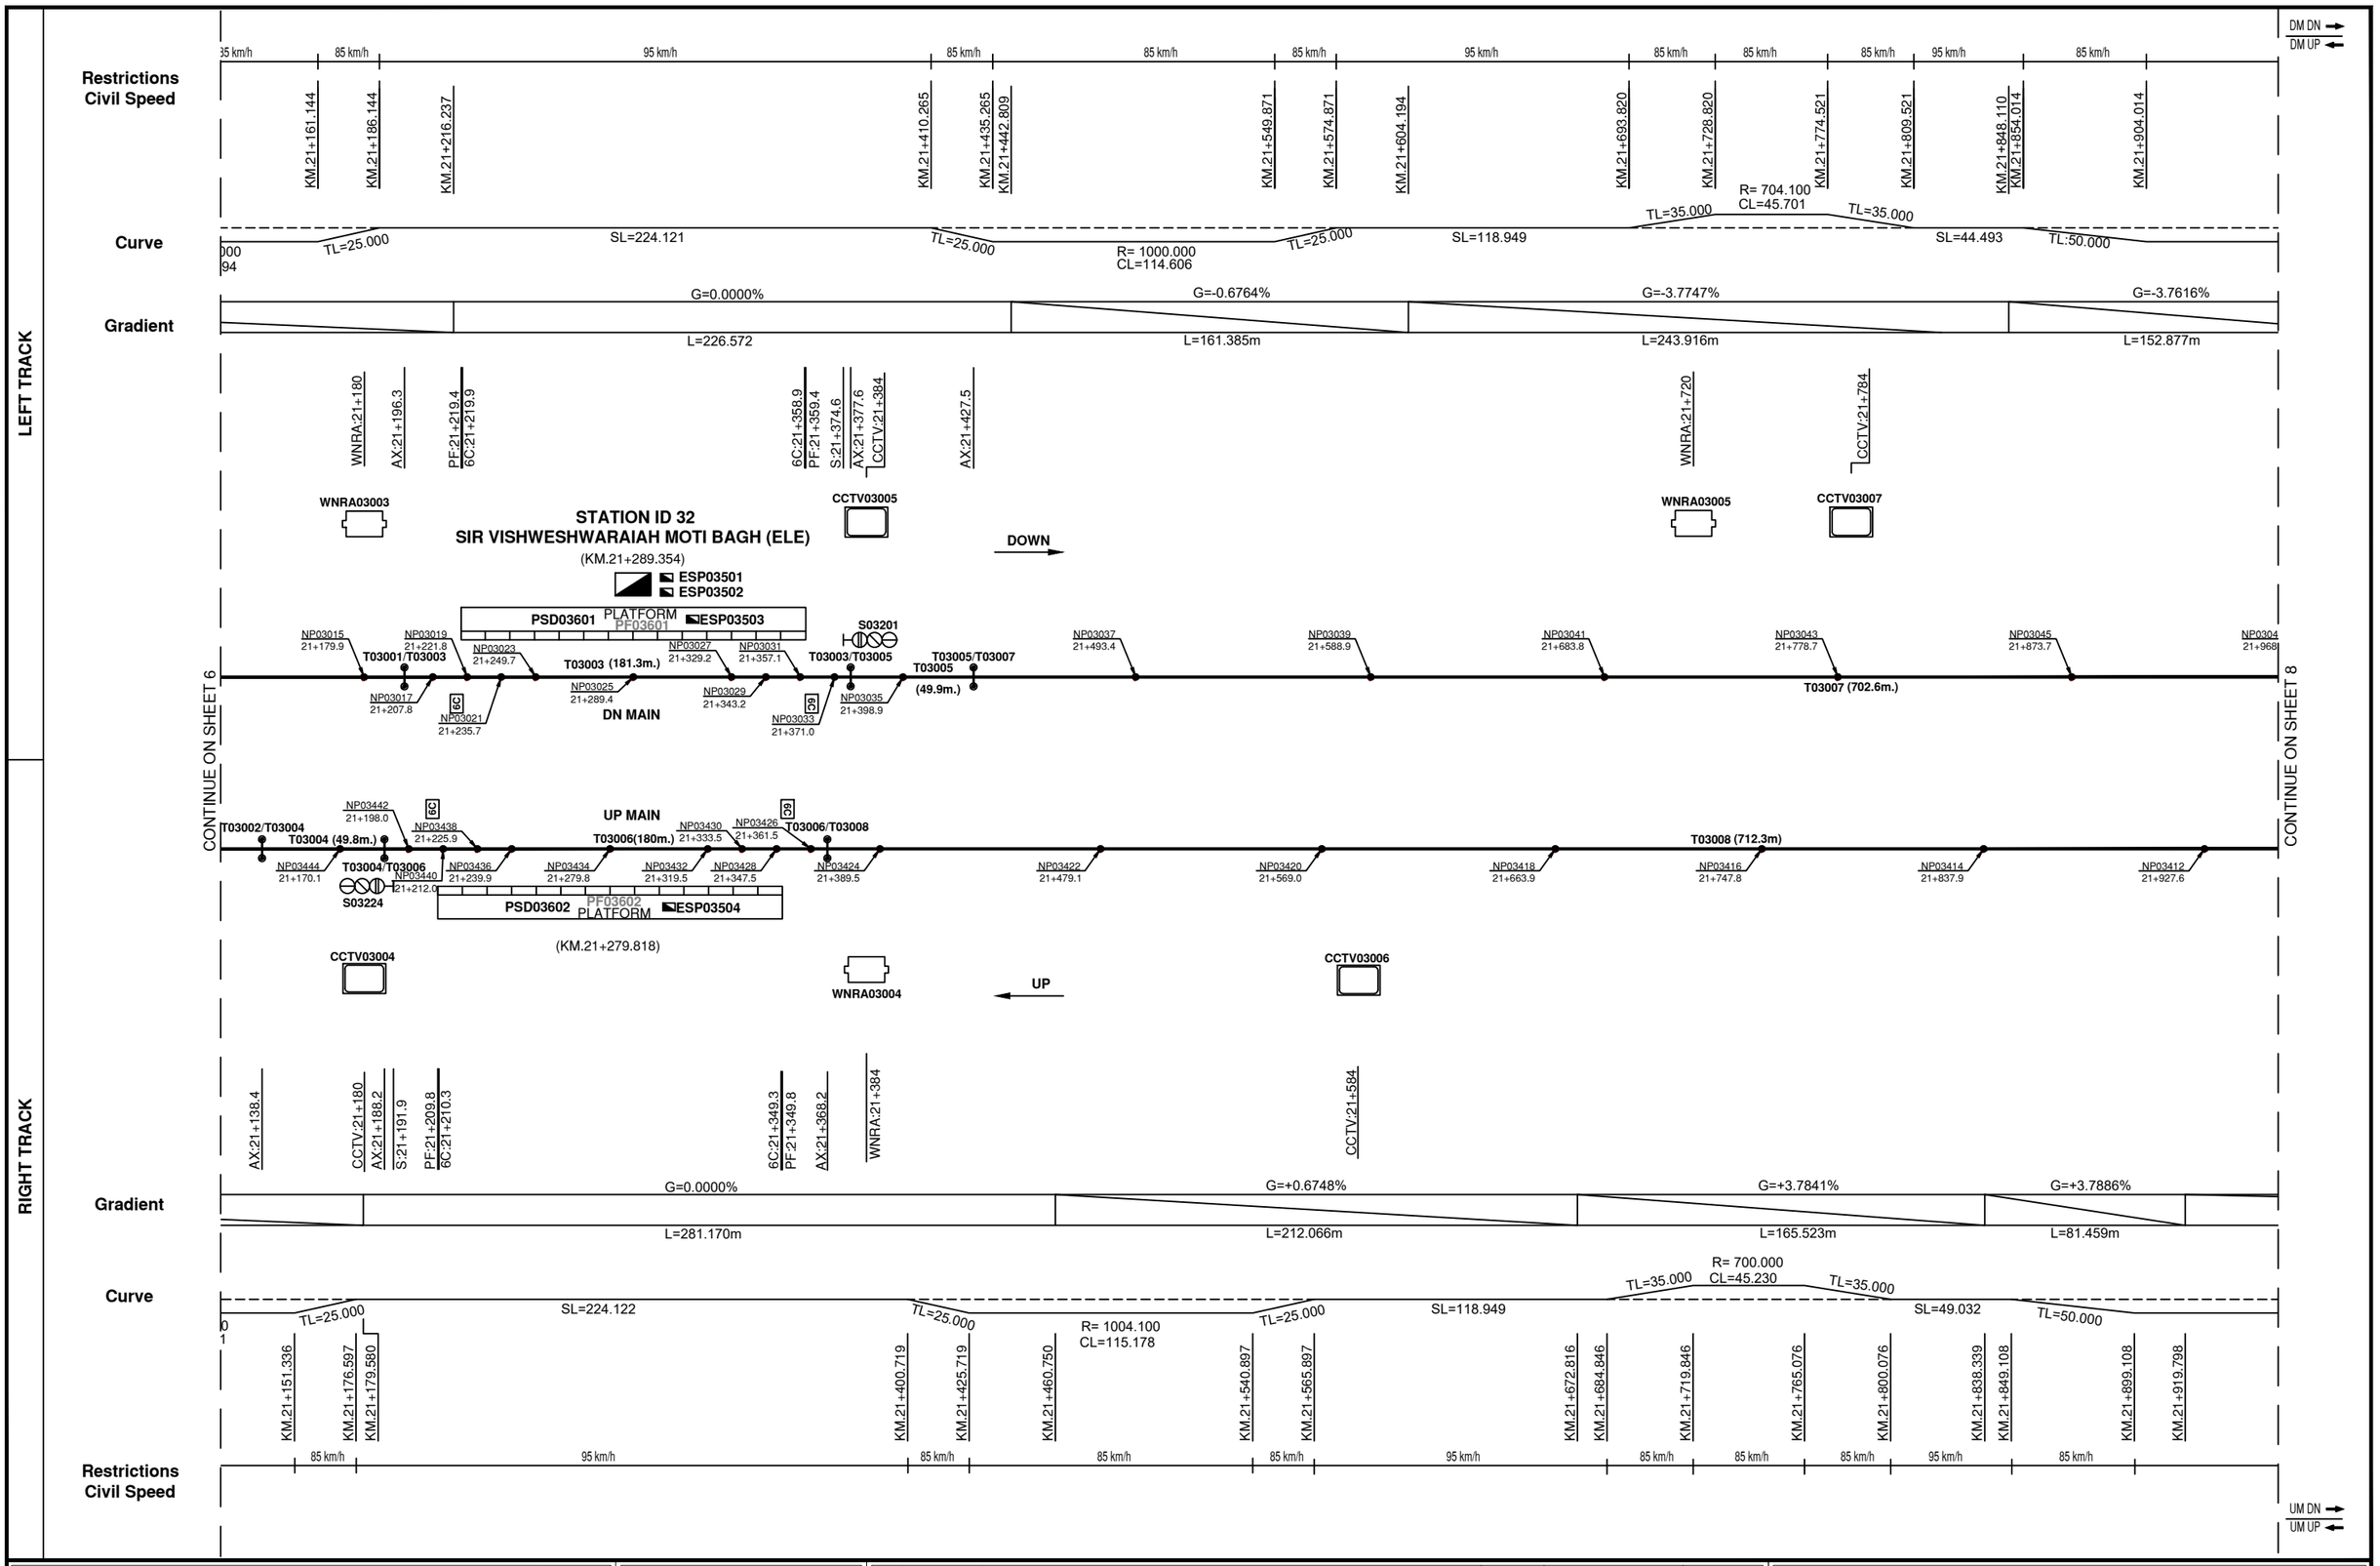

DELHI METRO RAIL CORPORATION LTD.
Metro Bhawan, Fire Brigade Lane, Barakhamba Road, New Delhi-110001

ORIGINATOR:
BOMBARDIER
the evolution of mobility

© 2019, Bombardier Inc.
All rights reserved.

AS-BUILT DRAWING

REV	DATE	DESCRIPTION
8.0	26–JUN–19	AS–BUILT DRAWING

	NAME	DATE
DESIGNED	IRSHAD A.	25–JUN–19
CHECKED	ASHOK K.	26–JUN–19
APPROVED	ROHIT T.	26–JUN–19

DRAWING TITLE: DELHI MRTS PROJECT PHASE III LINE 7
TRAIN CONTROL & SIGNALLING SYSTEM CONTRACT CS03
TRACK AND SIGNALLING PLAN LINE 7
SIR VISHWESHWARAIAH MOTI BAGH STATION TO HAZRAT NIZAMUDDIN STATION
SECTION-DH

DRAWING No:	COST CENTRE:	SCALE	SHEET	CONT.	REV.
100241842	A PRELIMINARIES AND GENERAL REQUIREMENTS	N/S	7	8	8.0

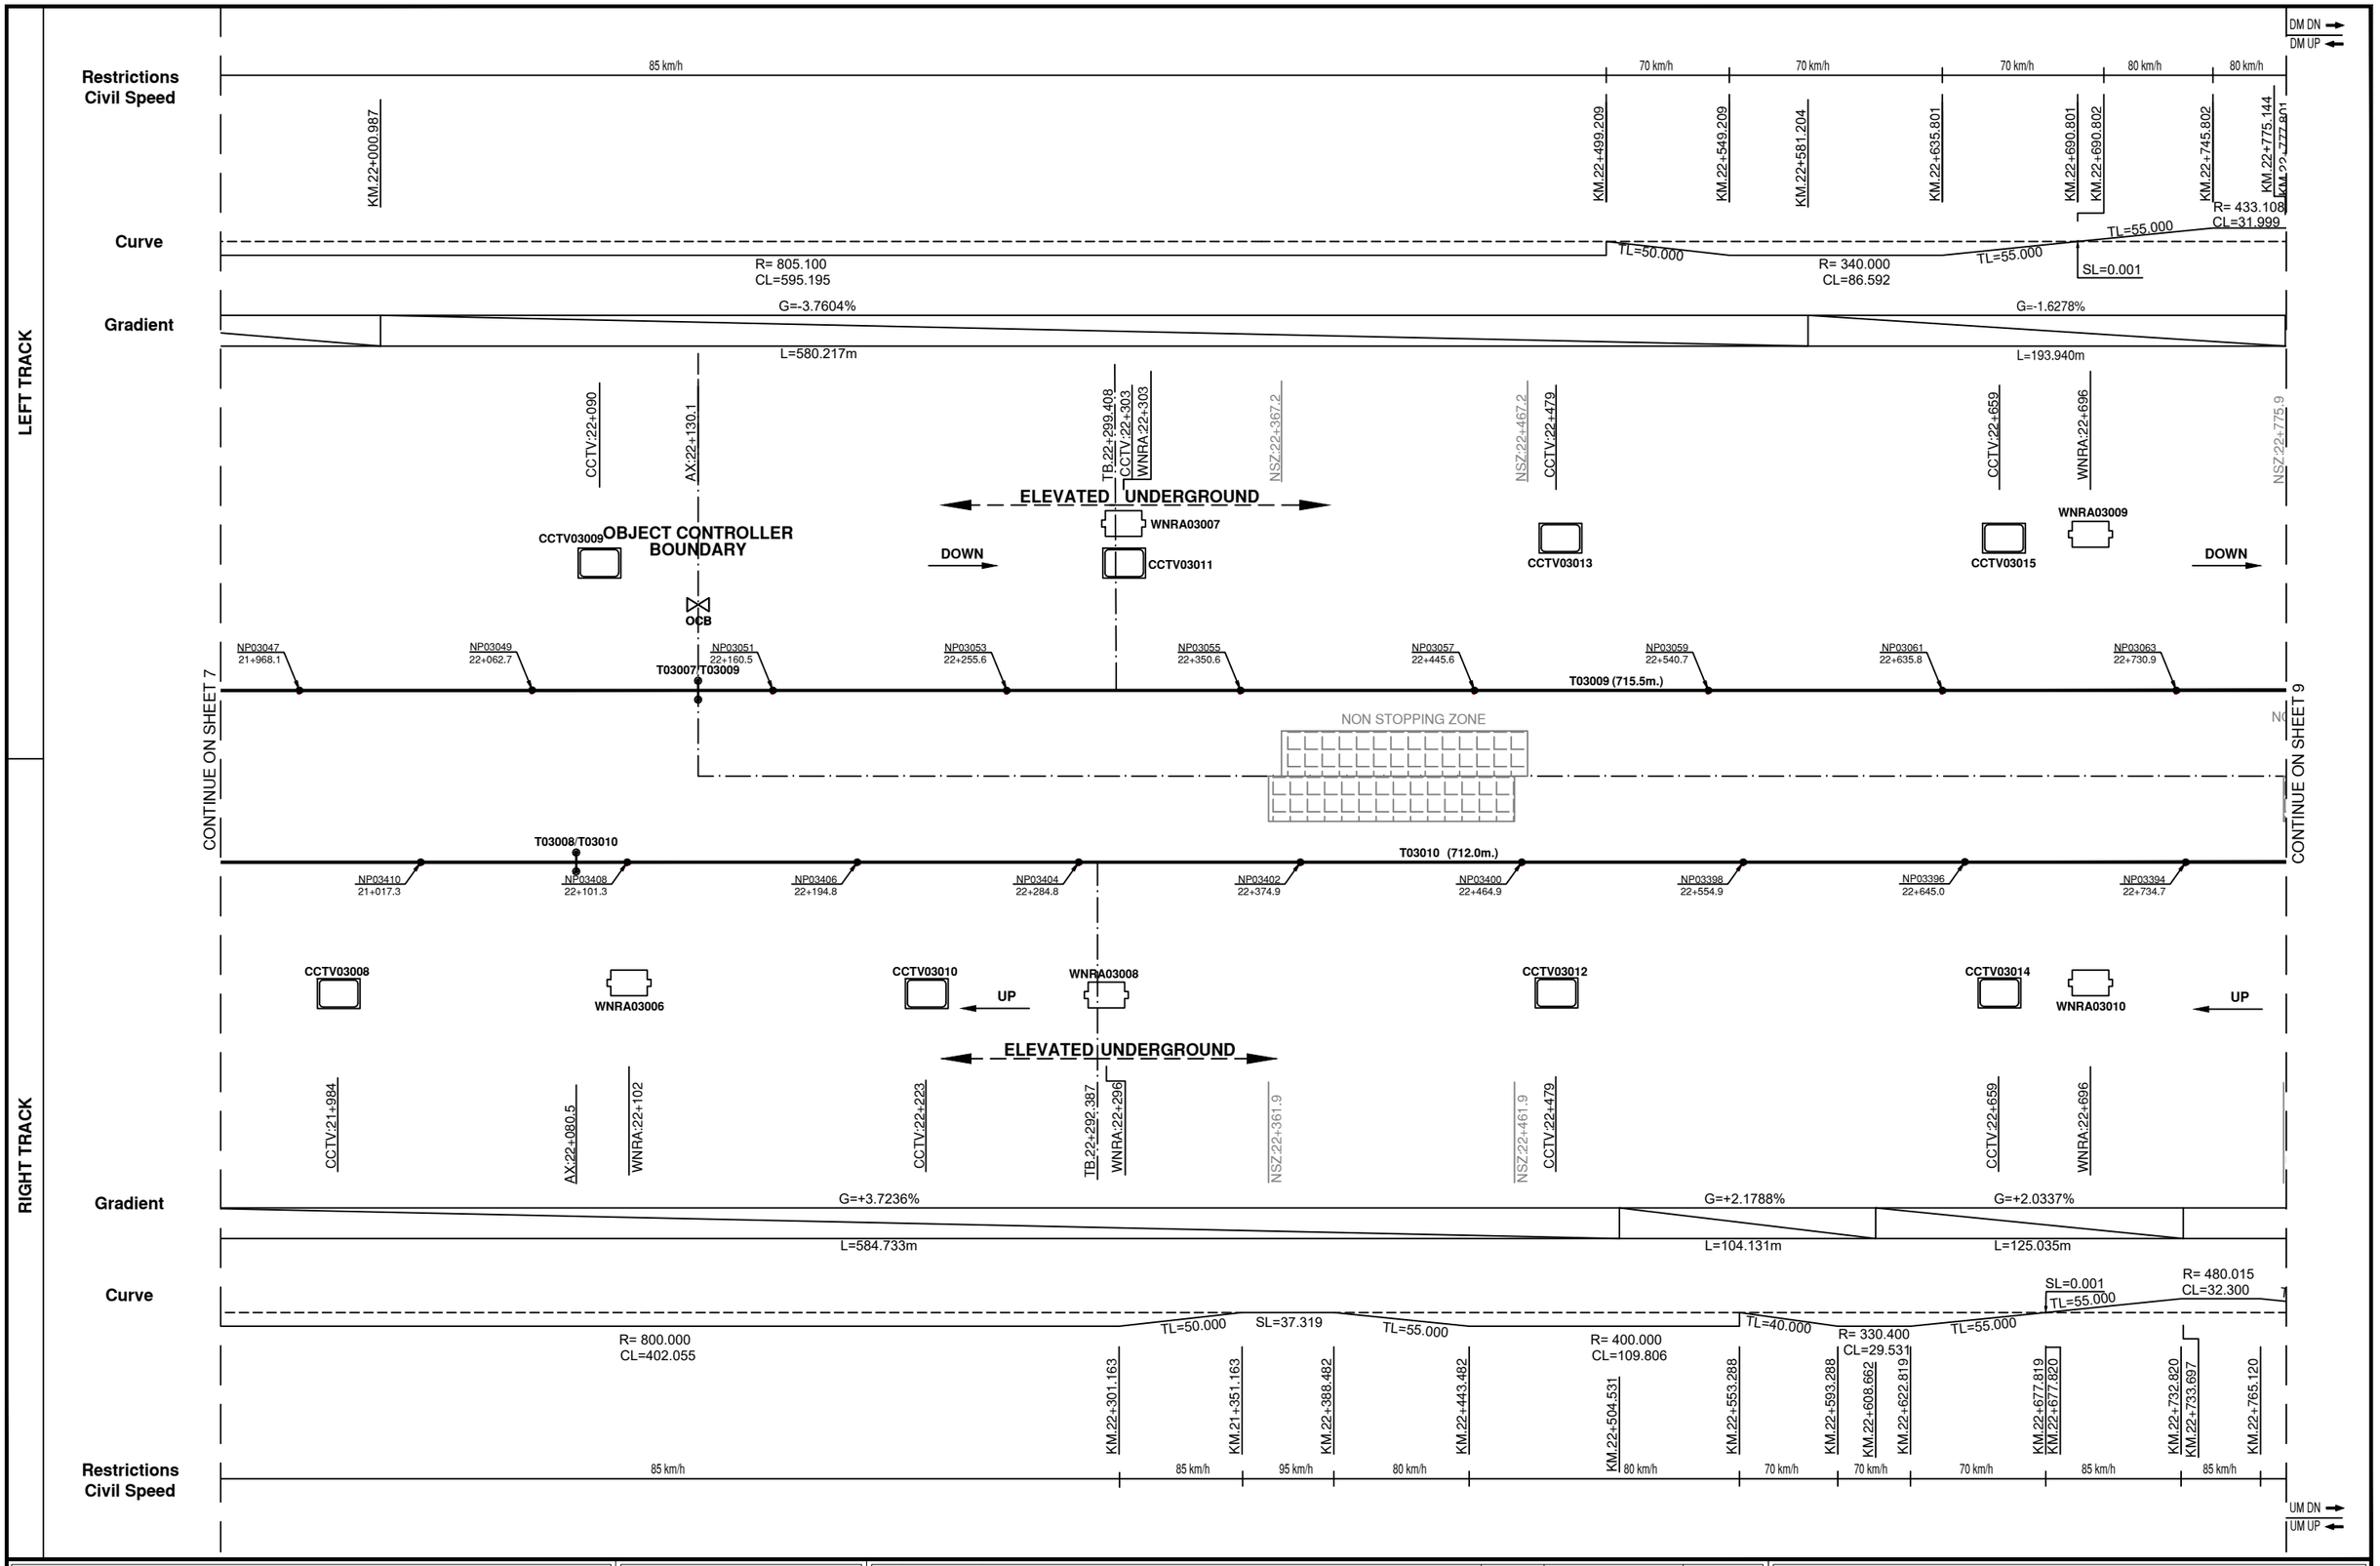

DELHI METRO RAIL CORPORATION LTD.
Metro Bhawan, Fire Brigade Lane, Barakhamba Road, New Delhi-110001

ORIGINATOR:
BOMBARDIER
the evolution of mobility

© 2019, Bombardier Inc.
All rights reserved.

AS-BUILT DRAWING

REV	DATE	DESCRIPTION
8.0	26-JUN-19	AS-BUILT DRAWING

	NAME	DATE
DESIGNED	IRSHAD A.	25-JUN-19
CHECKED	ASHOK K.	26-JUN-19
APPROVED	ROHIT T.	26-JUN-19

DRAWING TITLE: DELHI MRTS PROJECT PHASE III LINE 7
TRAIN CONTROL & SIGNALLING SYSTEM CONTRACT CS03
TRACK AND SIGNALLING PLAN LINE 7
SIR VISHWESHWARAIAH MOTI BAGH STATION TO HAZRAT NIZAMUDDIN STATION
SECTION-DH

DRAWING No:	COST CENTRE:	SCALE	SHEET	CONT.	REV.
100241842	A PRELIMINARIES AND GENERAL REQUIREMENTS	N/S	8	9	8.0

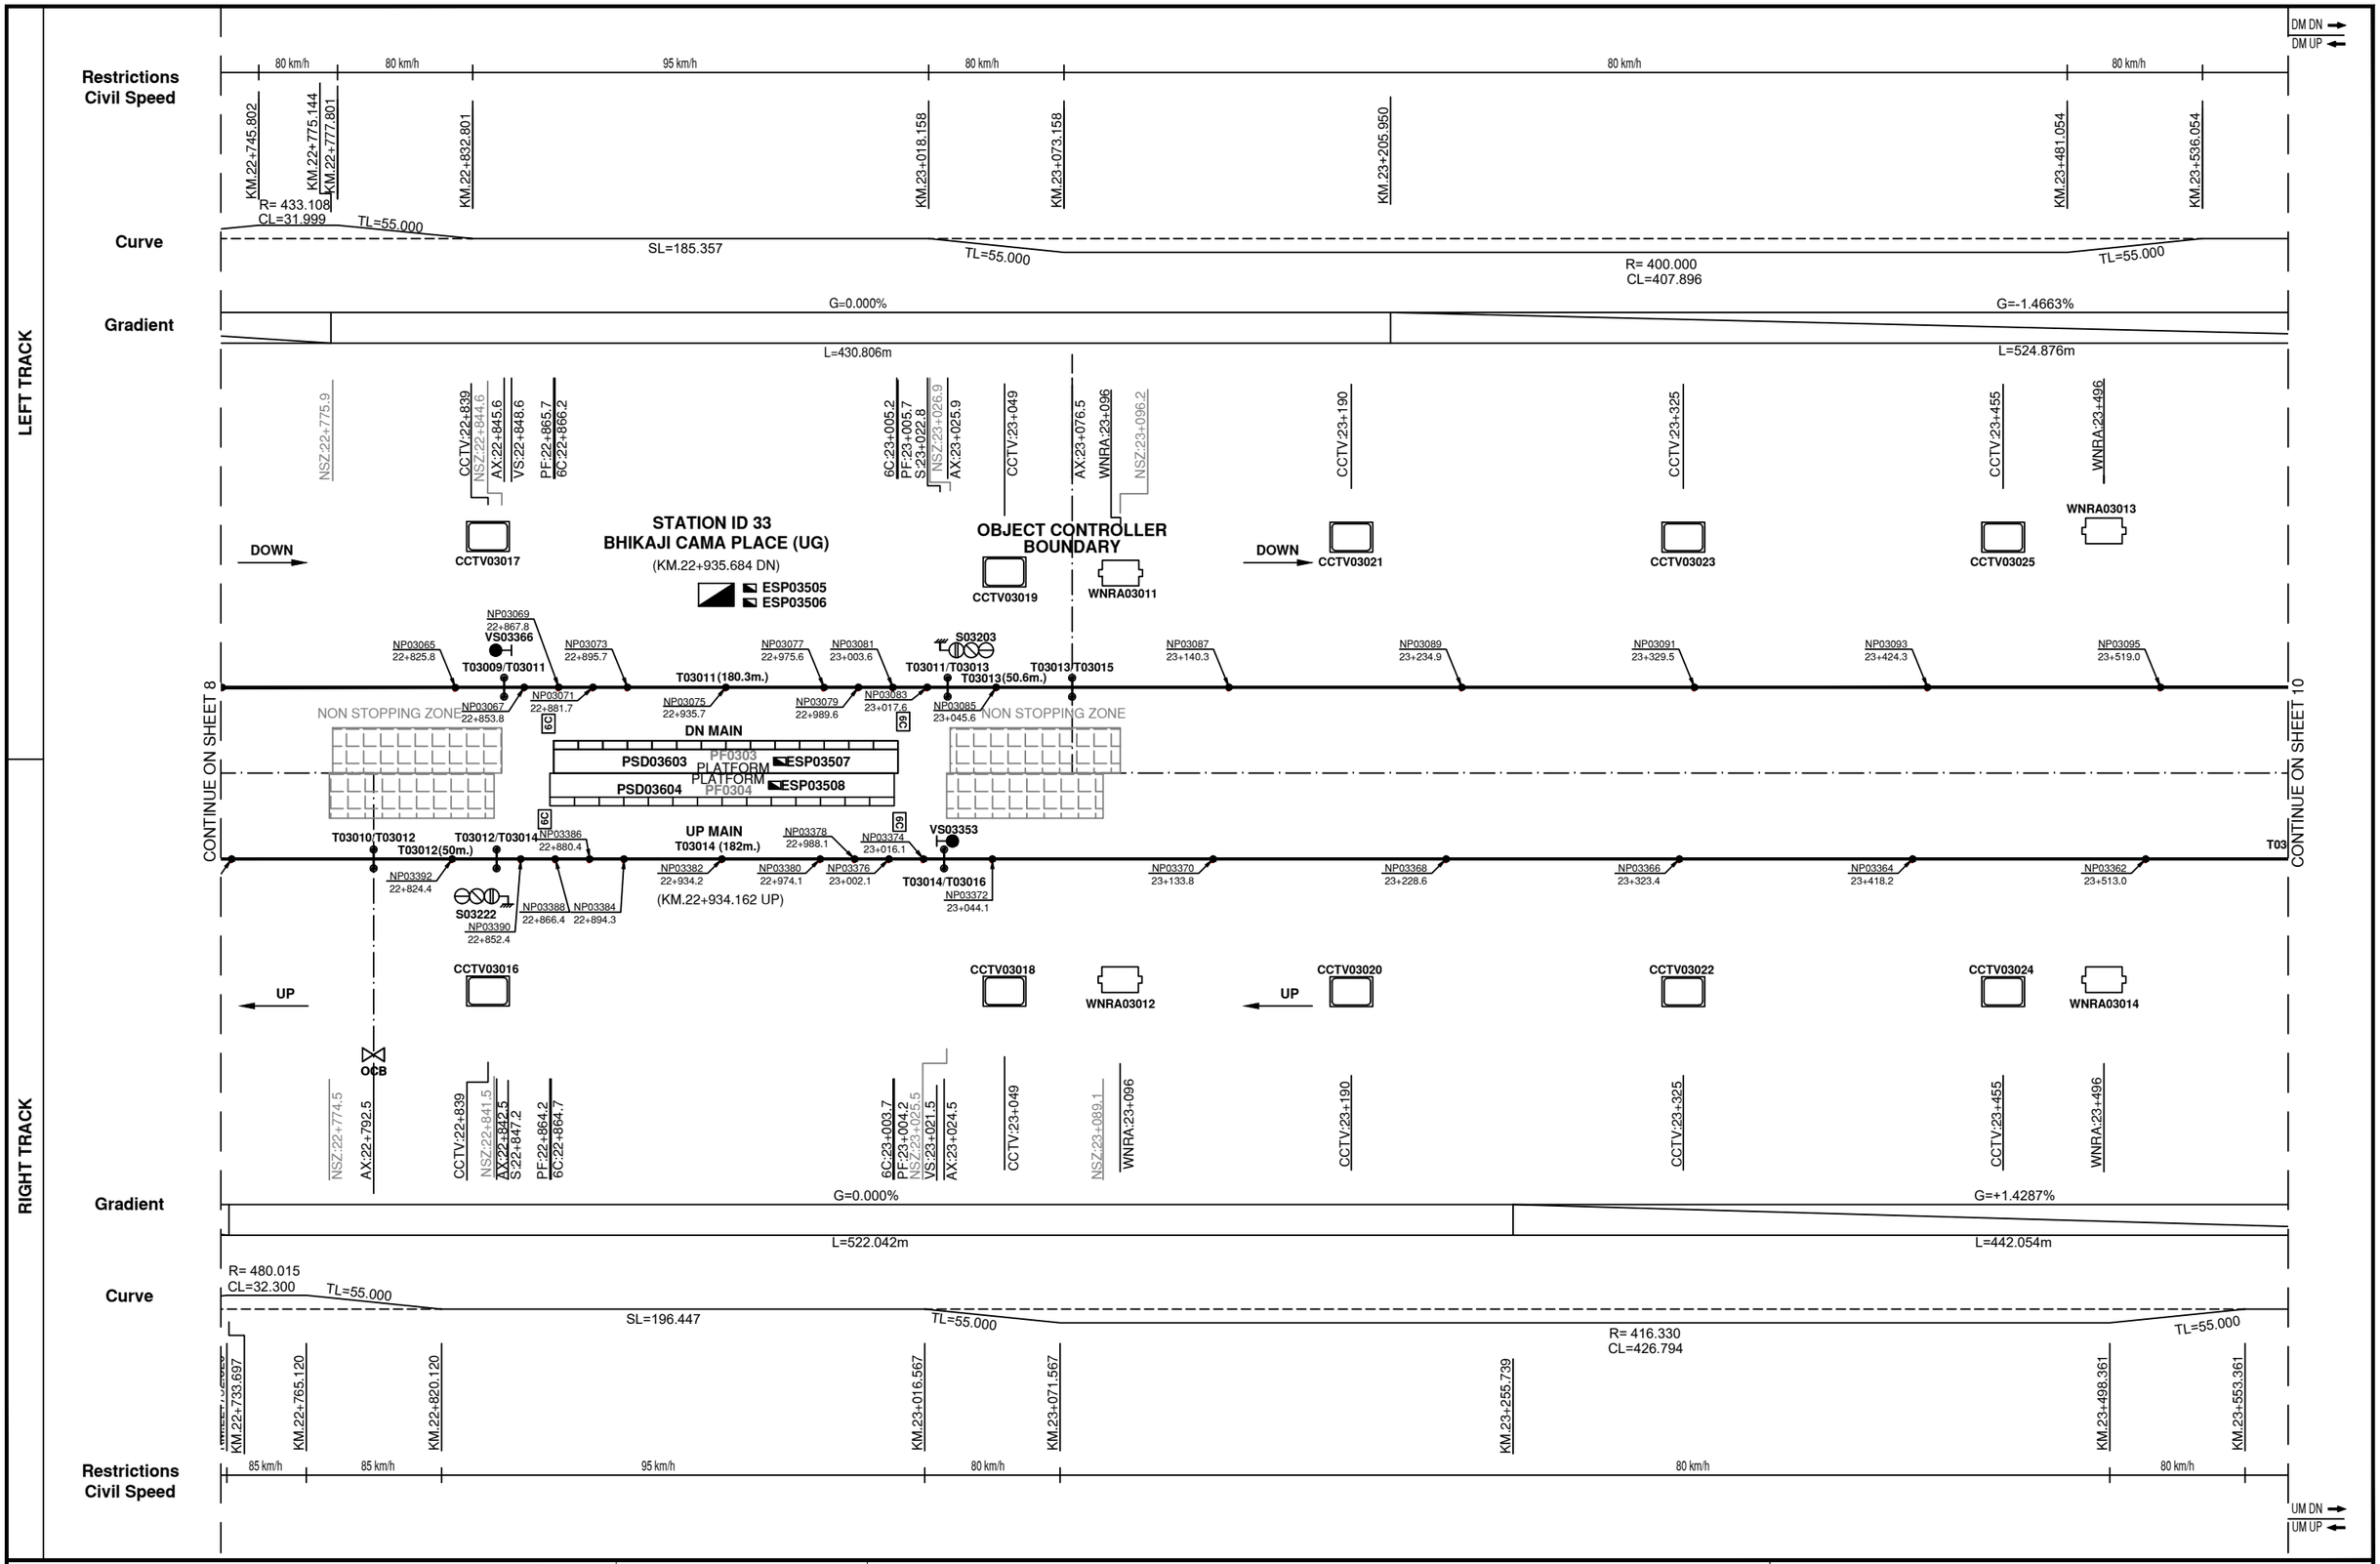

DELHI METRO RAIL CORPORATION LTD.
Metro Bhawan, Fire Brigade Lane, Barakhamba Road, New Delhi-110001

ORIGINATOR:
BOMBARDIER
the evolution of mobility

© 2019, Bombardier Inc.
All rights reserved.

AS-BUILT DRAWING

REV	DATE	DESCRIPTION
8.0	26-JUN-19	AS-BUILT DRAWING

	NAME	DATE
DESIGNED	IRSHAD A.	25-JUN-19
CHECKED	ASHOK K.	26-JUN-19
APPROVED	ROHIT T.	26-JUN-19

DRAWING TITLE:
DELHI MRTS PROJECT PHASE III LINE 7
TRAIN CONTROL & SIGNALLING SYSTEM CONTRACT CS03
TRACK AND SIGNALLING PLAN LINE 7
SIR VISHWESHWARAIAH MOTI BAGH STATION TO HAZRAT NIZAMUDDIN STATION
SECTION-DH

DRAWING No:	COST CENTRE:	SCALE	SHEET	CONT.	REV.
100241842	A PRELIMINARIES AND GENERAL REQUIREMENTS	N/S	9	10	8.0

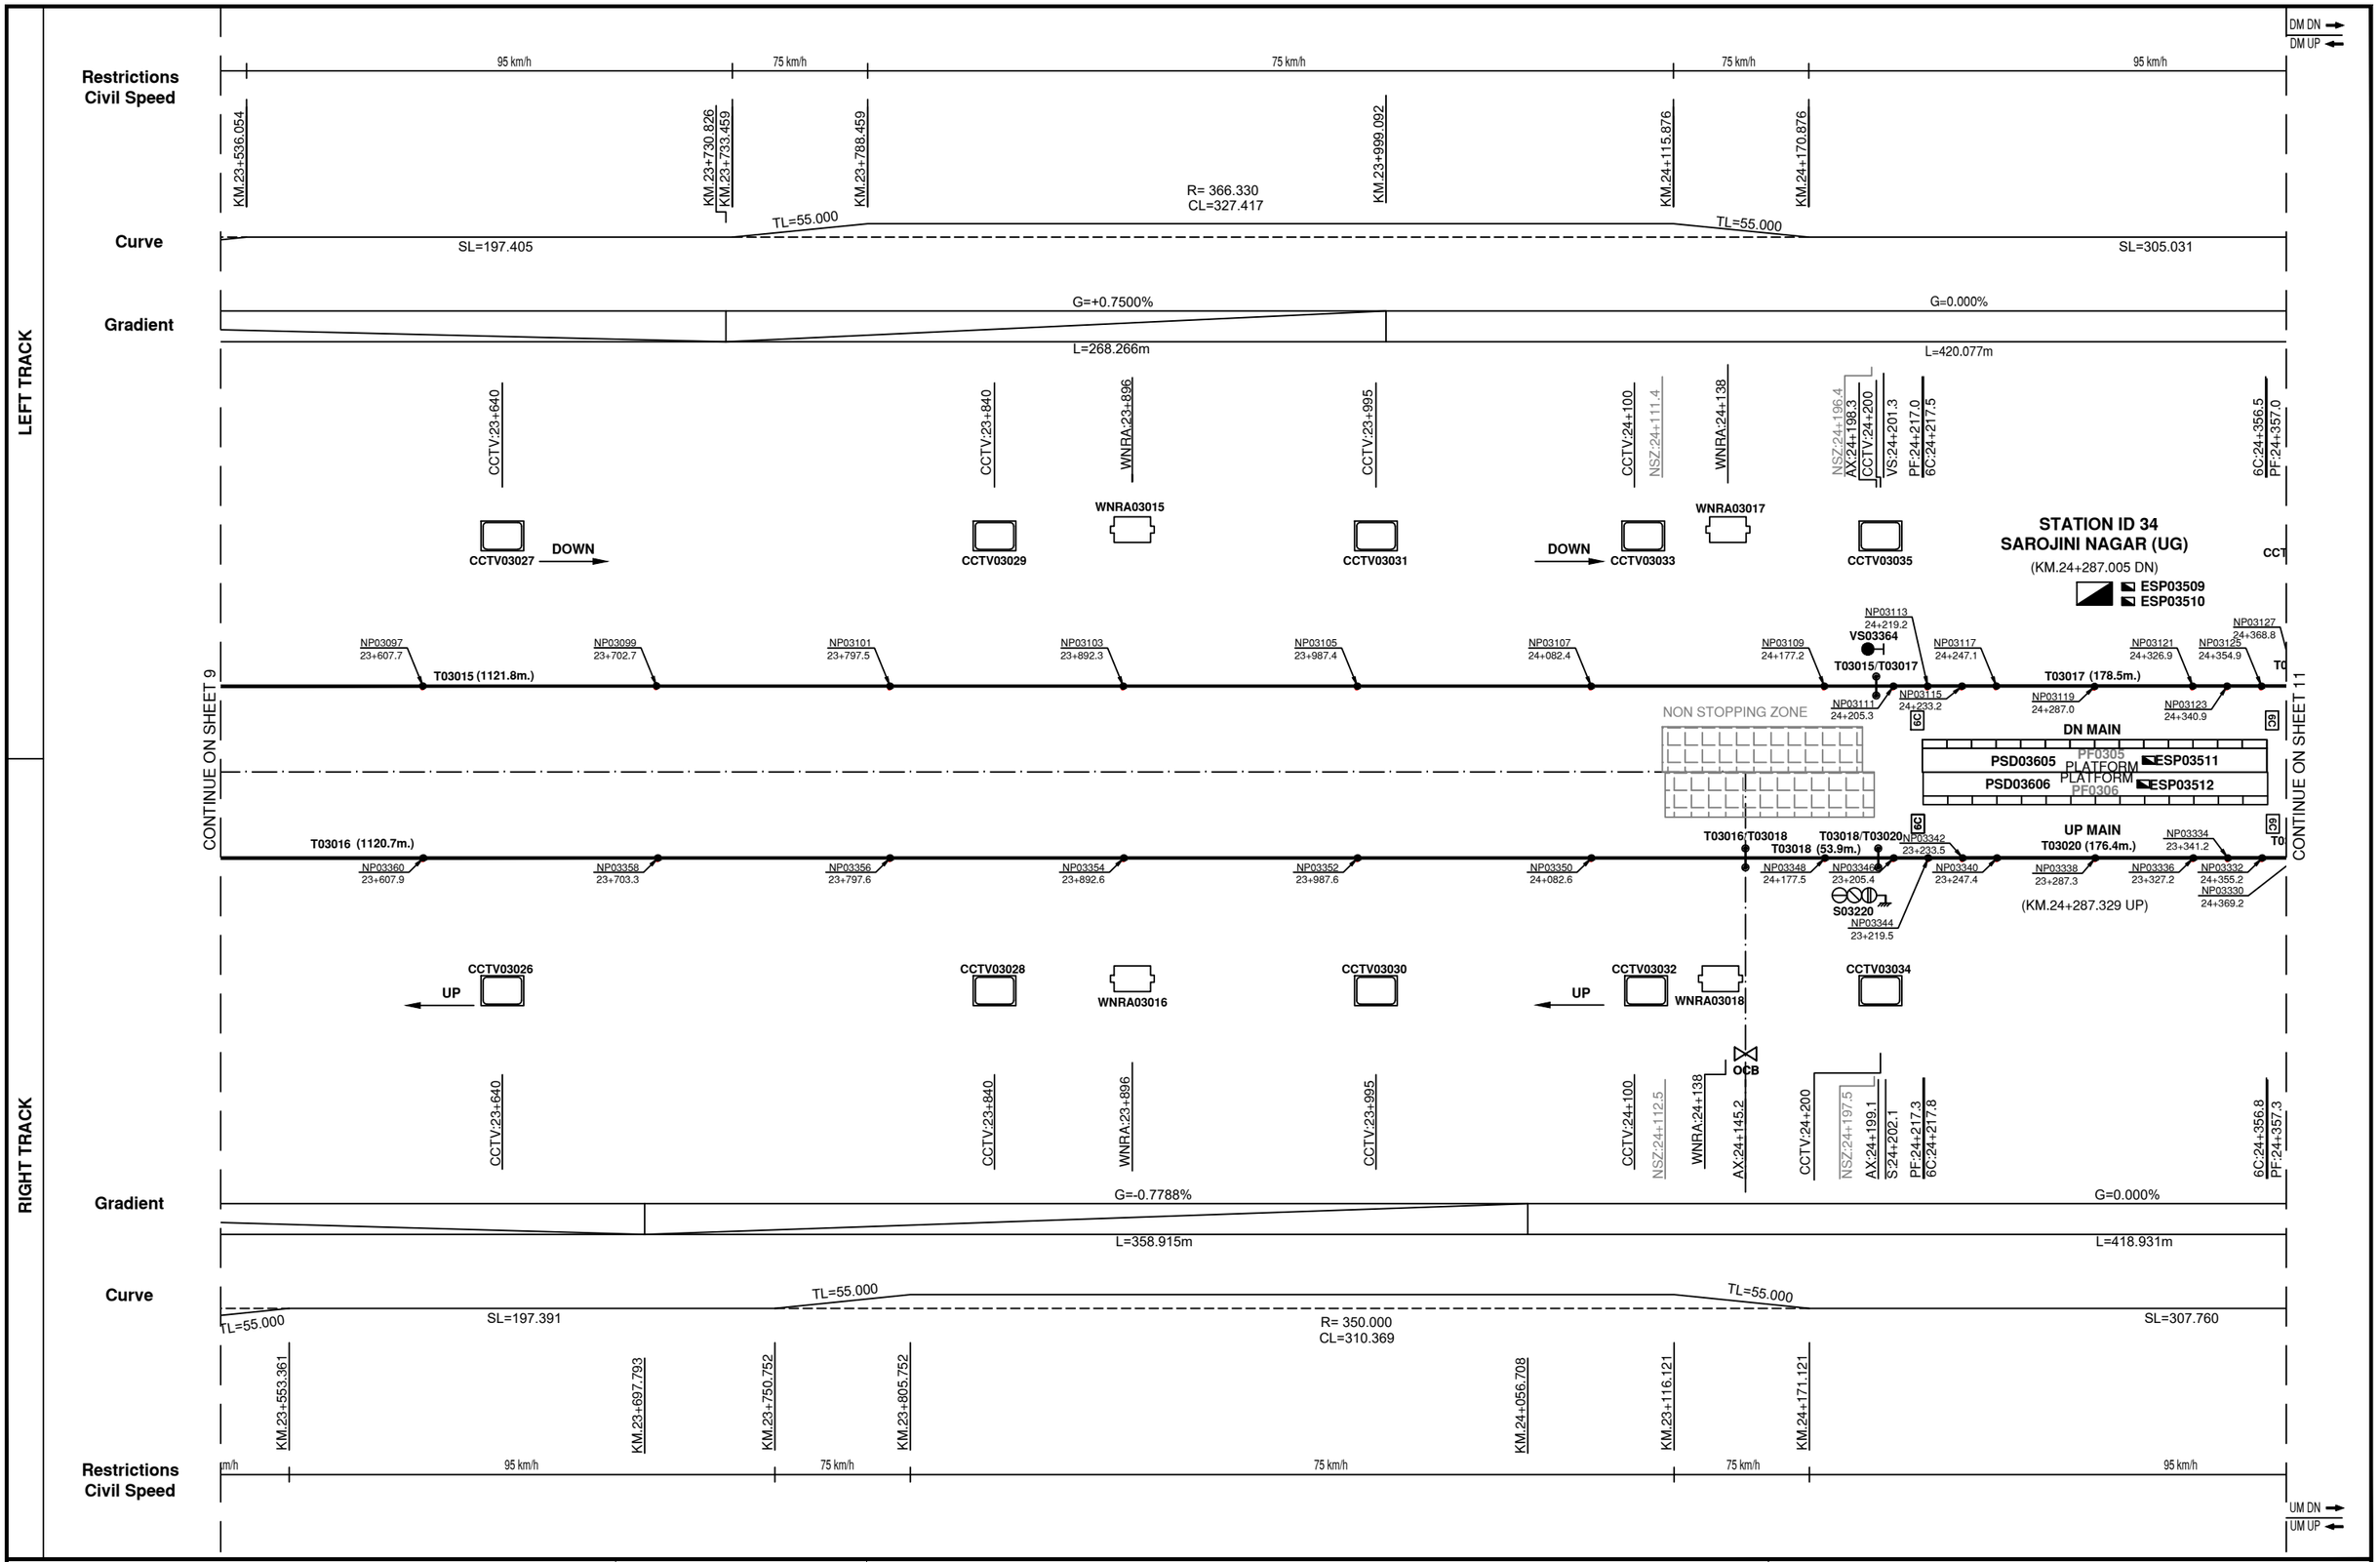

DELHI METRO RAIL CORPORATION LTD.
Metro Bhawan, Fire Brigade Lane, Barakhamba Road, New Delhi-110001

ORIGINATOR:
BOMBARDIER
the evolution of mobility

© 2019, Bombardier Inc.
All rights reserved.

AS-BUILT DRAWING

REV	DATE	DESCRIPTION
8.0	26–JUN–19	AS–BUILT DRAWING

	NAME	DATE
DESIGNED	IRSHAD A.	25–JUN–19
CHECKED	ASHOK K.	26–JUN–19
APPROVED	ROHIT T.	26–JUN–19

DRAWING TITLE:
DELHI MRTS PROJECT PHASE III LINE 7
TRAIN CONTROL & SIGNALLING SYSTEM CONTRACT CS03
TRACK AND SIGNALLING PLAN LINE 7
SIR VISHWESHWARAIAH MOTI BAGH STATION TO HAZRAT NIZAMUDDIN STATION
SECTION-DH

DRAWING No:	COST CENTRE:	SCALE	SHEET	CONT.	REV.
100241842	A PRELIMINARIES AND GENERAL REQUIREMENTS	N/S	10	11	8.0

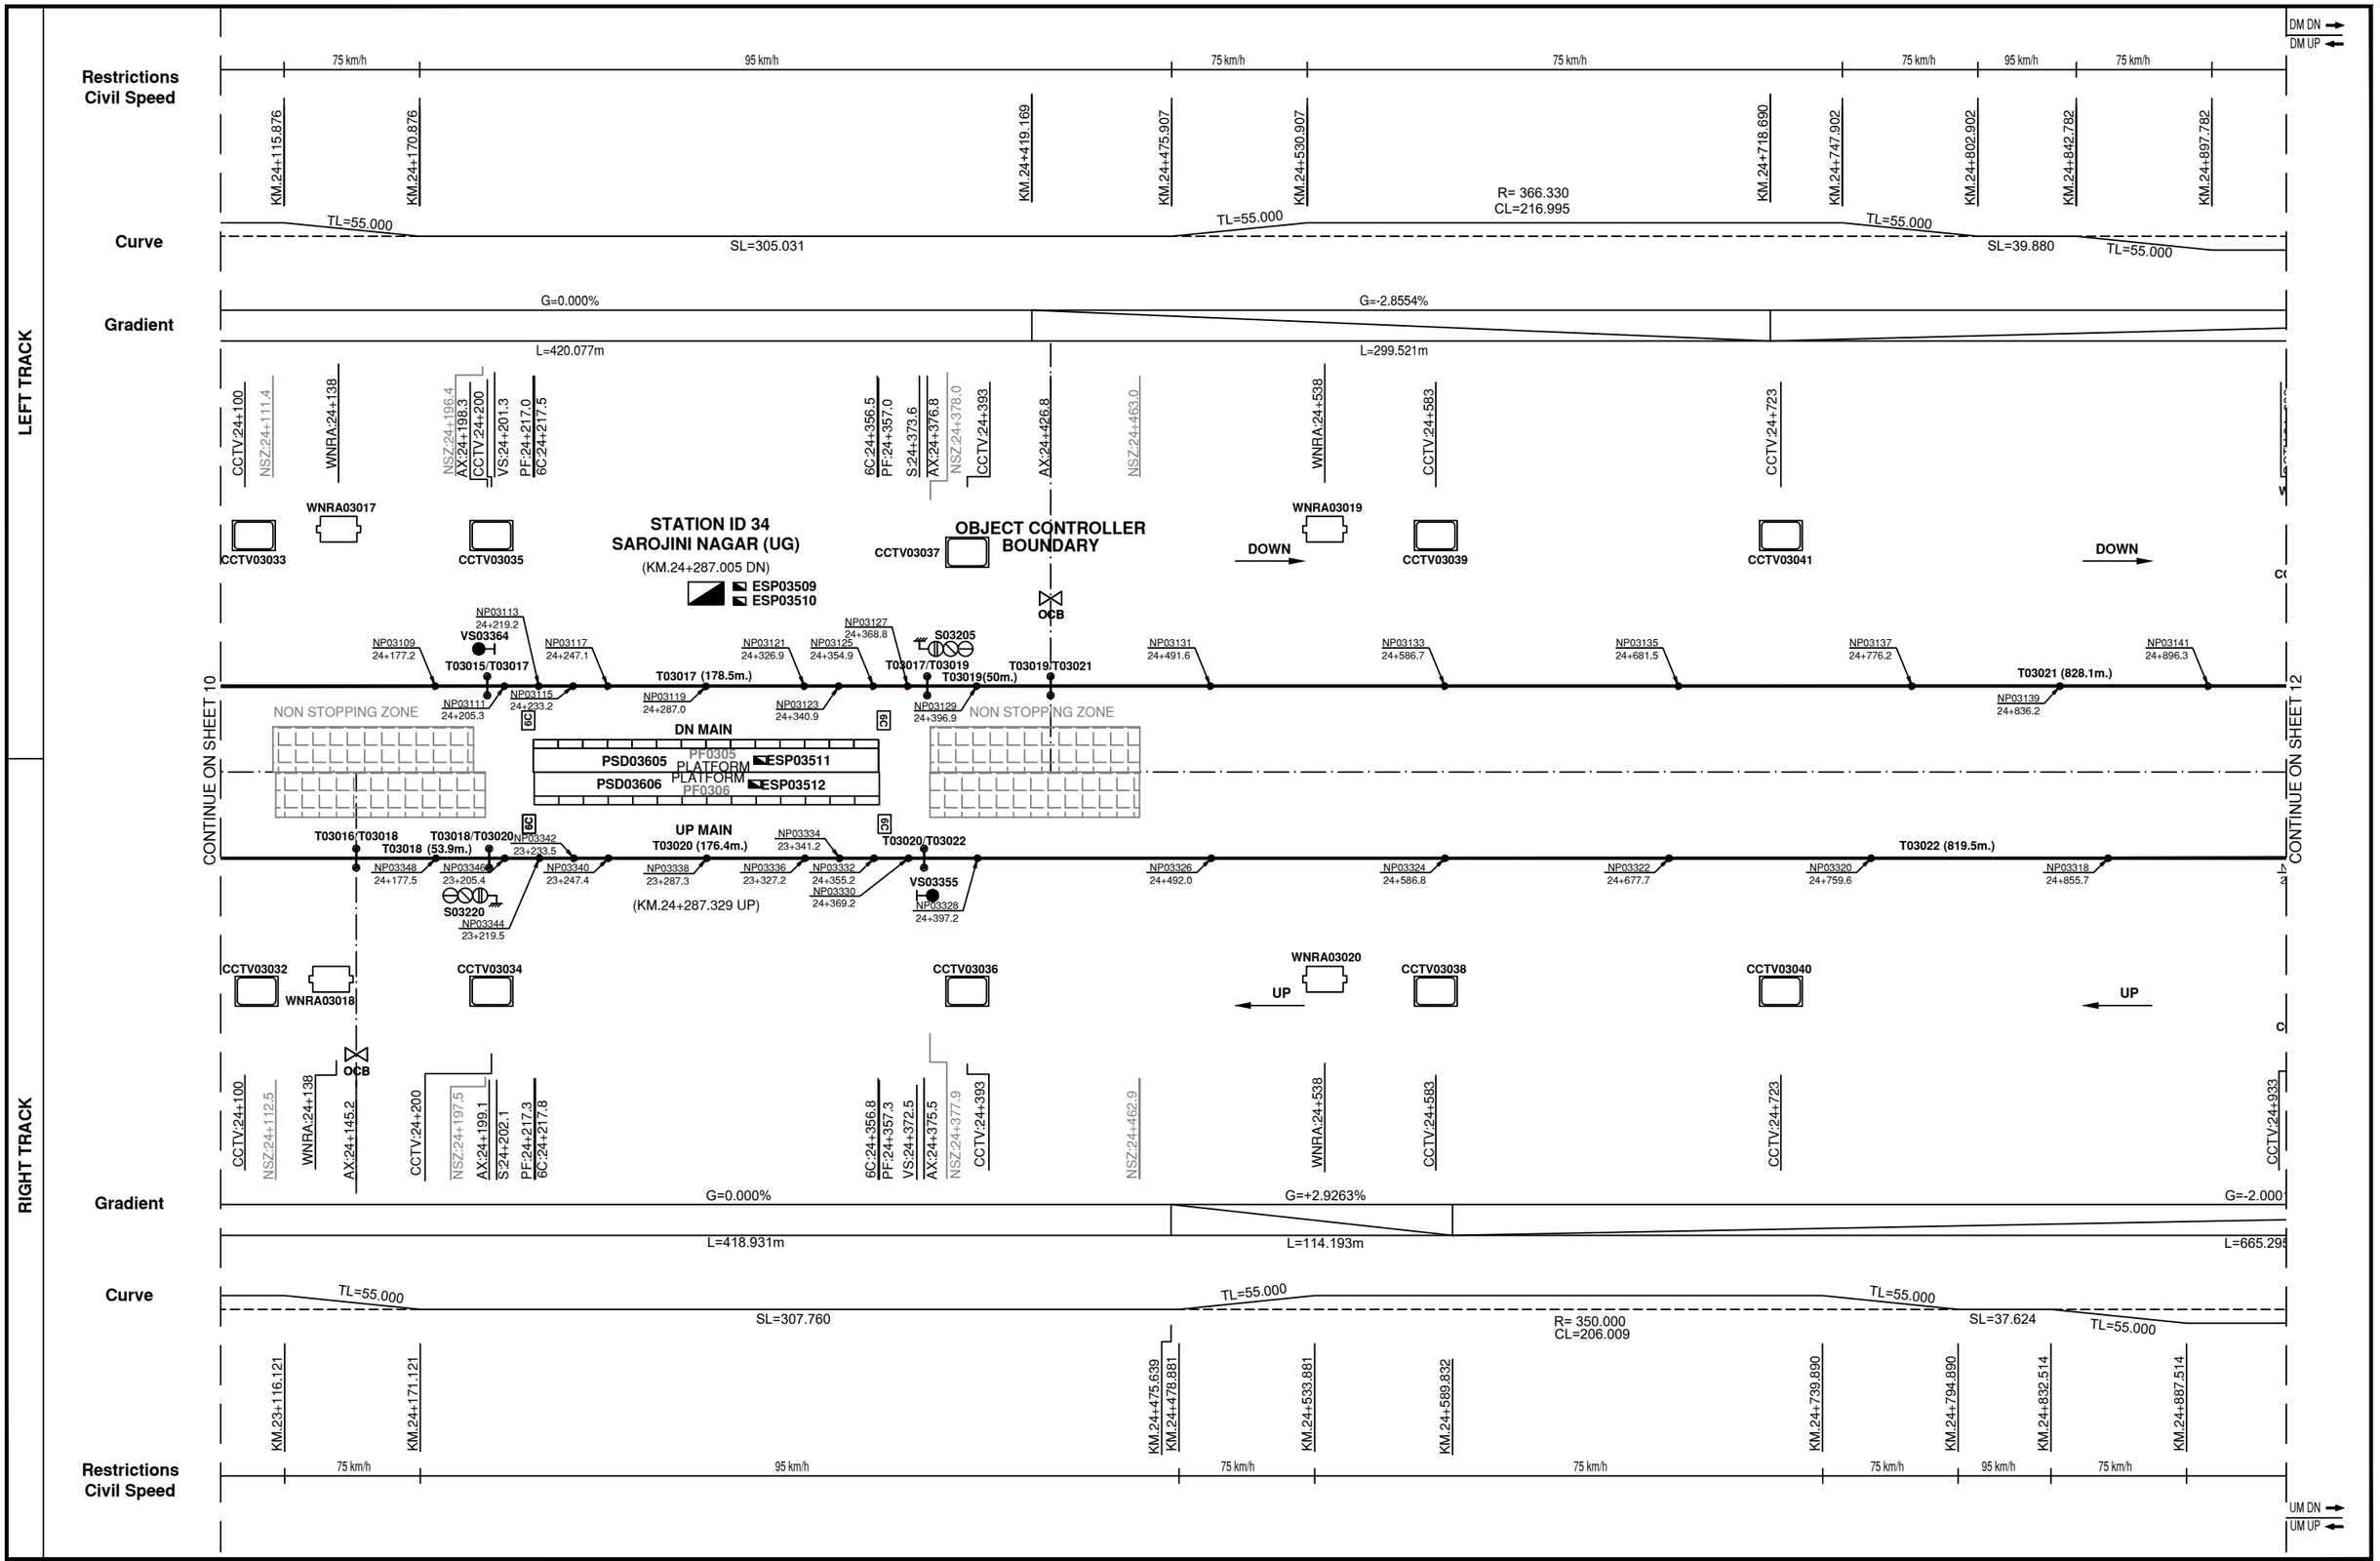

DELHI METRO RAIL CORPORATION LTD.
Metro Bhawan, Fire Brigade Lane, Barakhamba Road, New Delhi-110001

ORIGINATOR:
BOMBARDIER
the evolution of mobility

© 2019, Bombardier Inc.
All rights reserved.

AS-BUILT DRAWING

REV	DATE	DESCRIPTION
8.0	26-JUN-19	AS-BUILT DRAWING

	NAME	DATE
DESIGNED	IRSHAD A.	25-JUN-19
CHECKED	ASHOK K.	26-JUN-19
APPROVED	ROHIT T.	26-JUN-19

DRAWING TITLE:
DELHI MRTS PROJECT PHASE III LINE 7
TRAIN CONTROL & SIGNALLING SYSTEM CONTRACT CS03
TRACK AND SIGNALLING PLAN LINE 7
SIR VISHWESHWARAIAH MOTI BAGH STATION TO HAZRAT NIZAMUDDIN STATION
SECTION-DH

DRAWING No:	COST CENTRE:	SCALE	SHEET	CONT.	REV.
100241842	A PRELIMINARIES AND GENERAL REQUIREMENTS	N/S	11	12	8.0

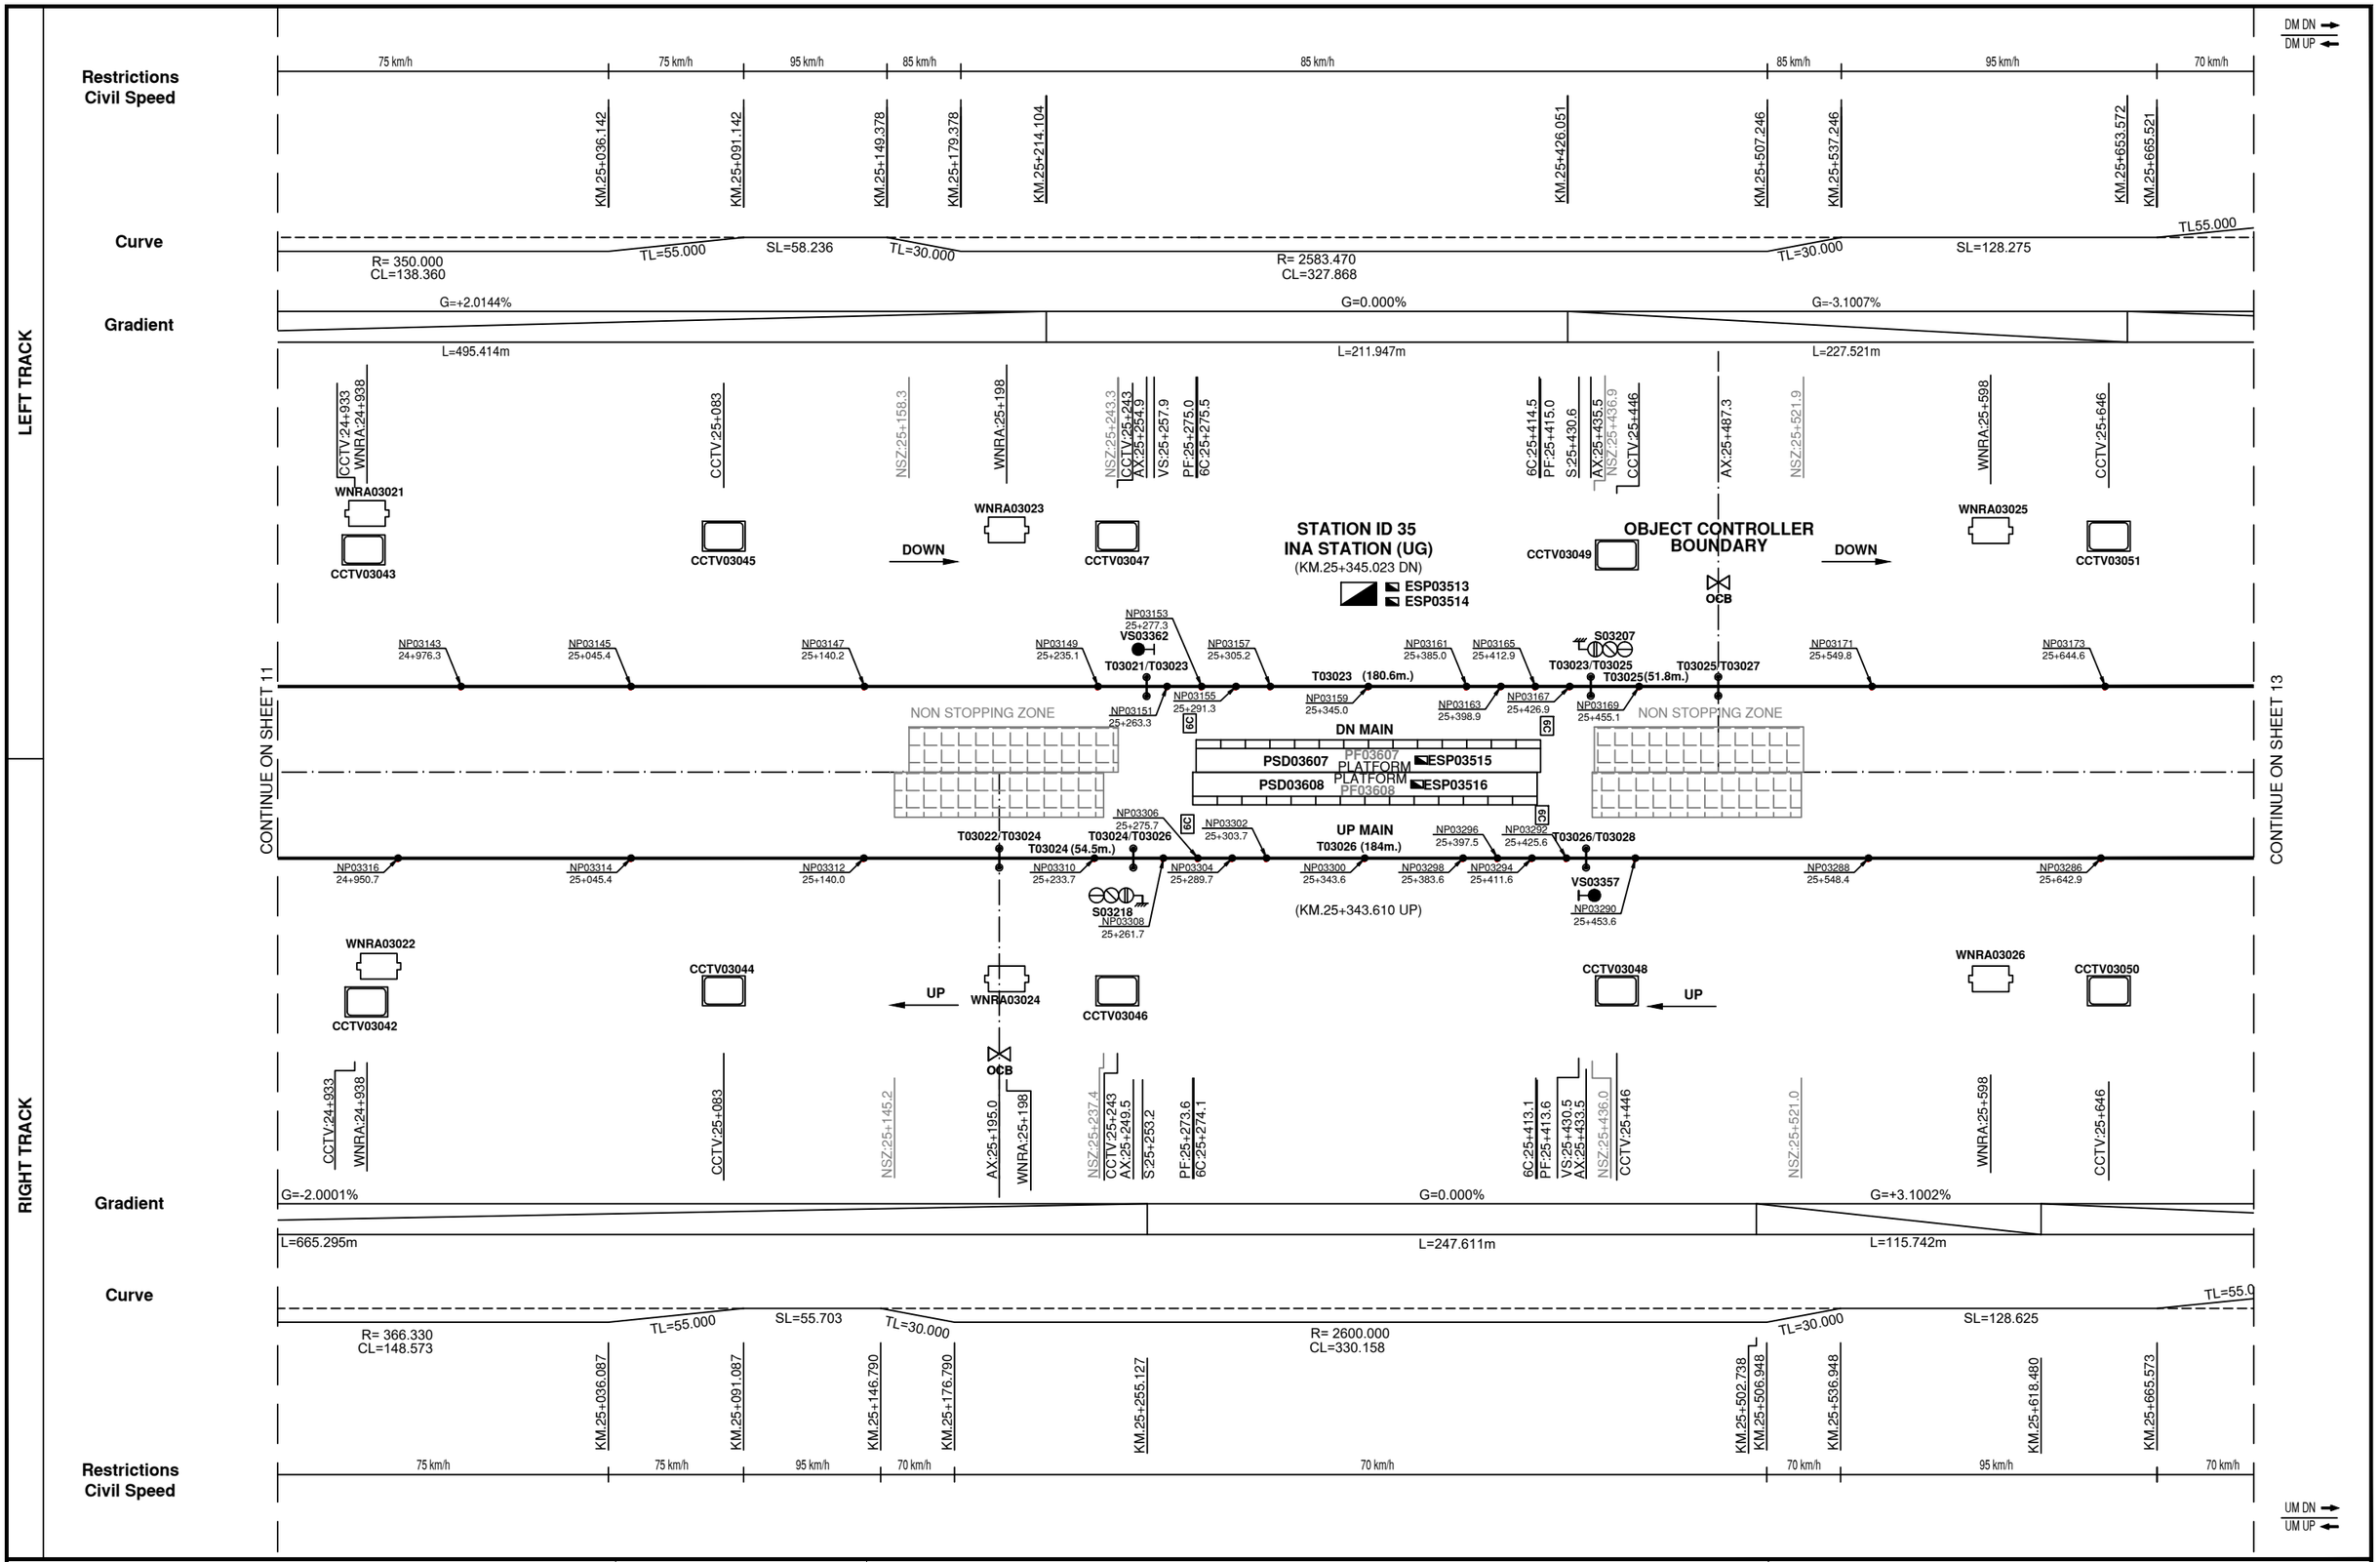

DELHI METRO RAIL CORPORATION LTD.
Metro Bhawan, Fire Brigade Lane, Barakhamba Road, New Delhi-110001

ORIGINATOR:
BOMBARDIER
the evolution of mobility

© 2019, Bombardier Inc.
All rights reserved.

AS-BUILT DRAWING

REV	DATE	DESCRIPTION
8.0	26–JUN–19	AS–BUILT DRAWING

	NAME	DATE
DESIGNED	IRSHAD A.	25–JUN–19
CHECKED	ASHOK K.	26–JUN–19
APPROVED	ROHIT T.	26–JUN–19

DRAWING TITLE: DELHI MRTS PROJECT PHASE III LINE 7
TRAIN CONTROL & SIGNALLING SYSTEM CONTRACT CS03
TRACK AND SIGNALLING PLAN LINE 7
SIR VISHWESHWARAIAH MOTI BAGH STATION TO HAZRAT NIZAMUDDIN STATION
SECTION-DH

DRAWING No:	COST CENTRE:	SCALE	SHEET	CONT.	REV.
100241842	A PRELIMINARIES AND GENERAL REQUIREMENTS	N/S	12	13	8.0

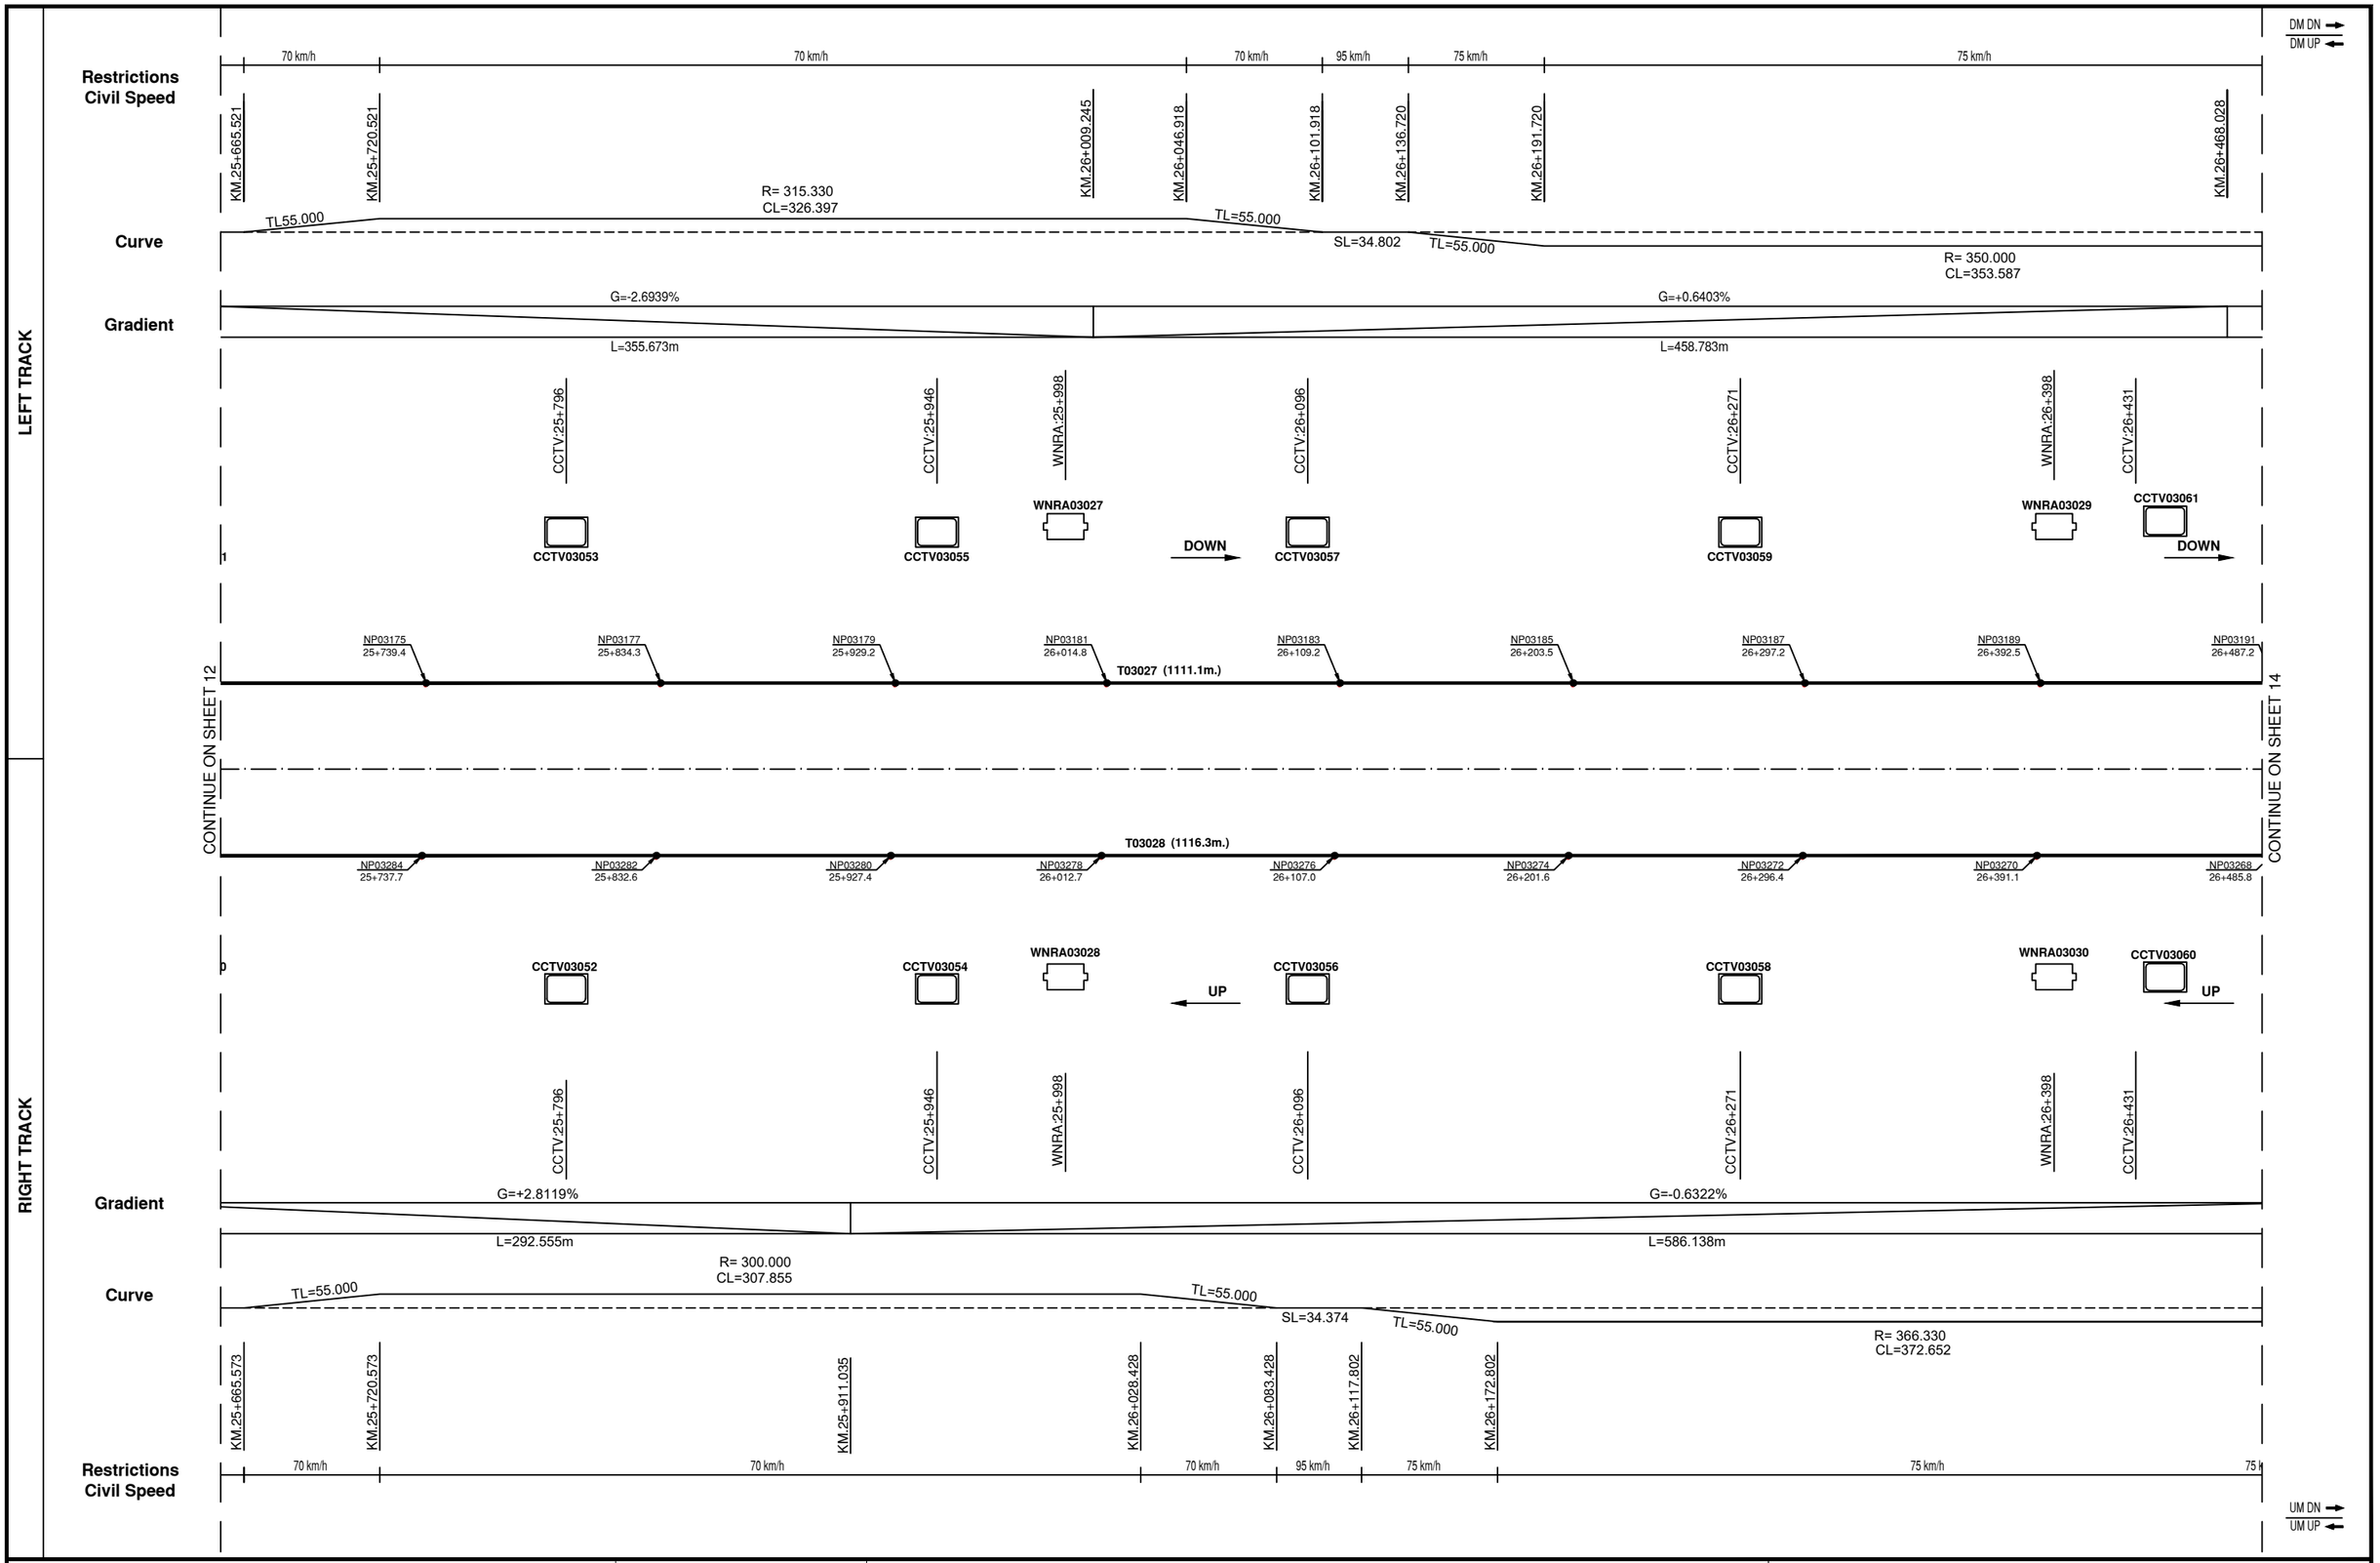

DELHI METRO RAIL CORPORATION LTD.
Metro Bhawan, Fire Brigade Lane, Barakhamba Road, New Delhi-110001

ORIGINATOR:
BOMBARDIER
the evolution of mobility

© 2019, Bombardier Inc. All rights reserved.

AS-BUILT DRAWING

REV	DATE	DESCRIPTION
8.0	26-JUN-19	AS-BUILT DRAWING

	NAME	DATE
DESIGNED	IRSHAD A.	25-JUN-19
CHECKED	ASHOK K.	26-JUN-19
APPROVED	ROHIT T.	26-JUN-19

DRAWING TITLE:
DELHI MRTS PROJECT PHASE III LINE 7
TRAIN CONTROL & SIGNALLING SYSTEM CONTRACT CS03
TRACK AND SIGNALLING PLAN LINE 7
SIR VISHWESHWARAIAH MOTI BAGH STATION TO HAZRAT NIZAMUDDIN STATION
SECTION-DH

DRAWING No:	COST CENTRE:	SCALE	SHEET	CONT.	REV.
100241842	A PRELIMINARIES AND GENERAL REQUIREMENTS	N/S	13	14	8.0

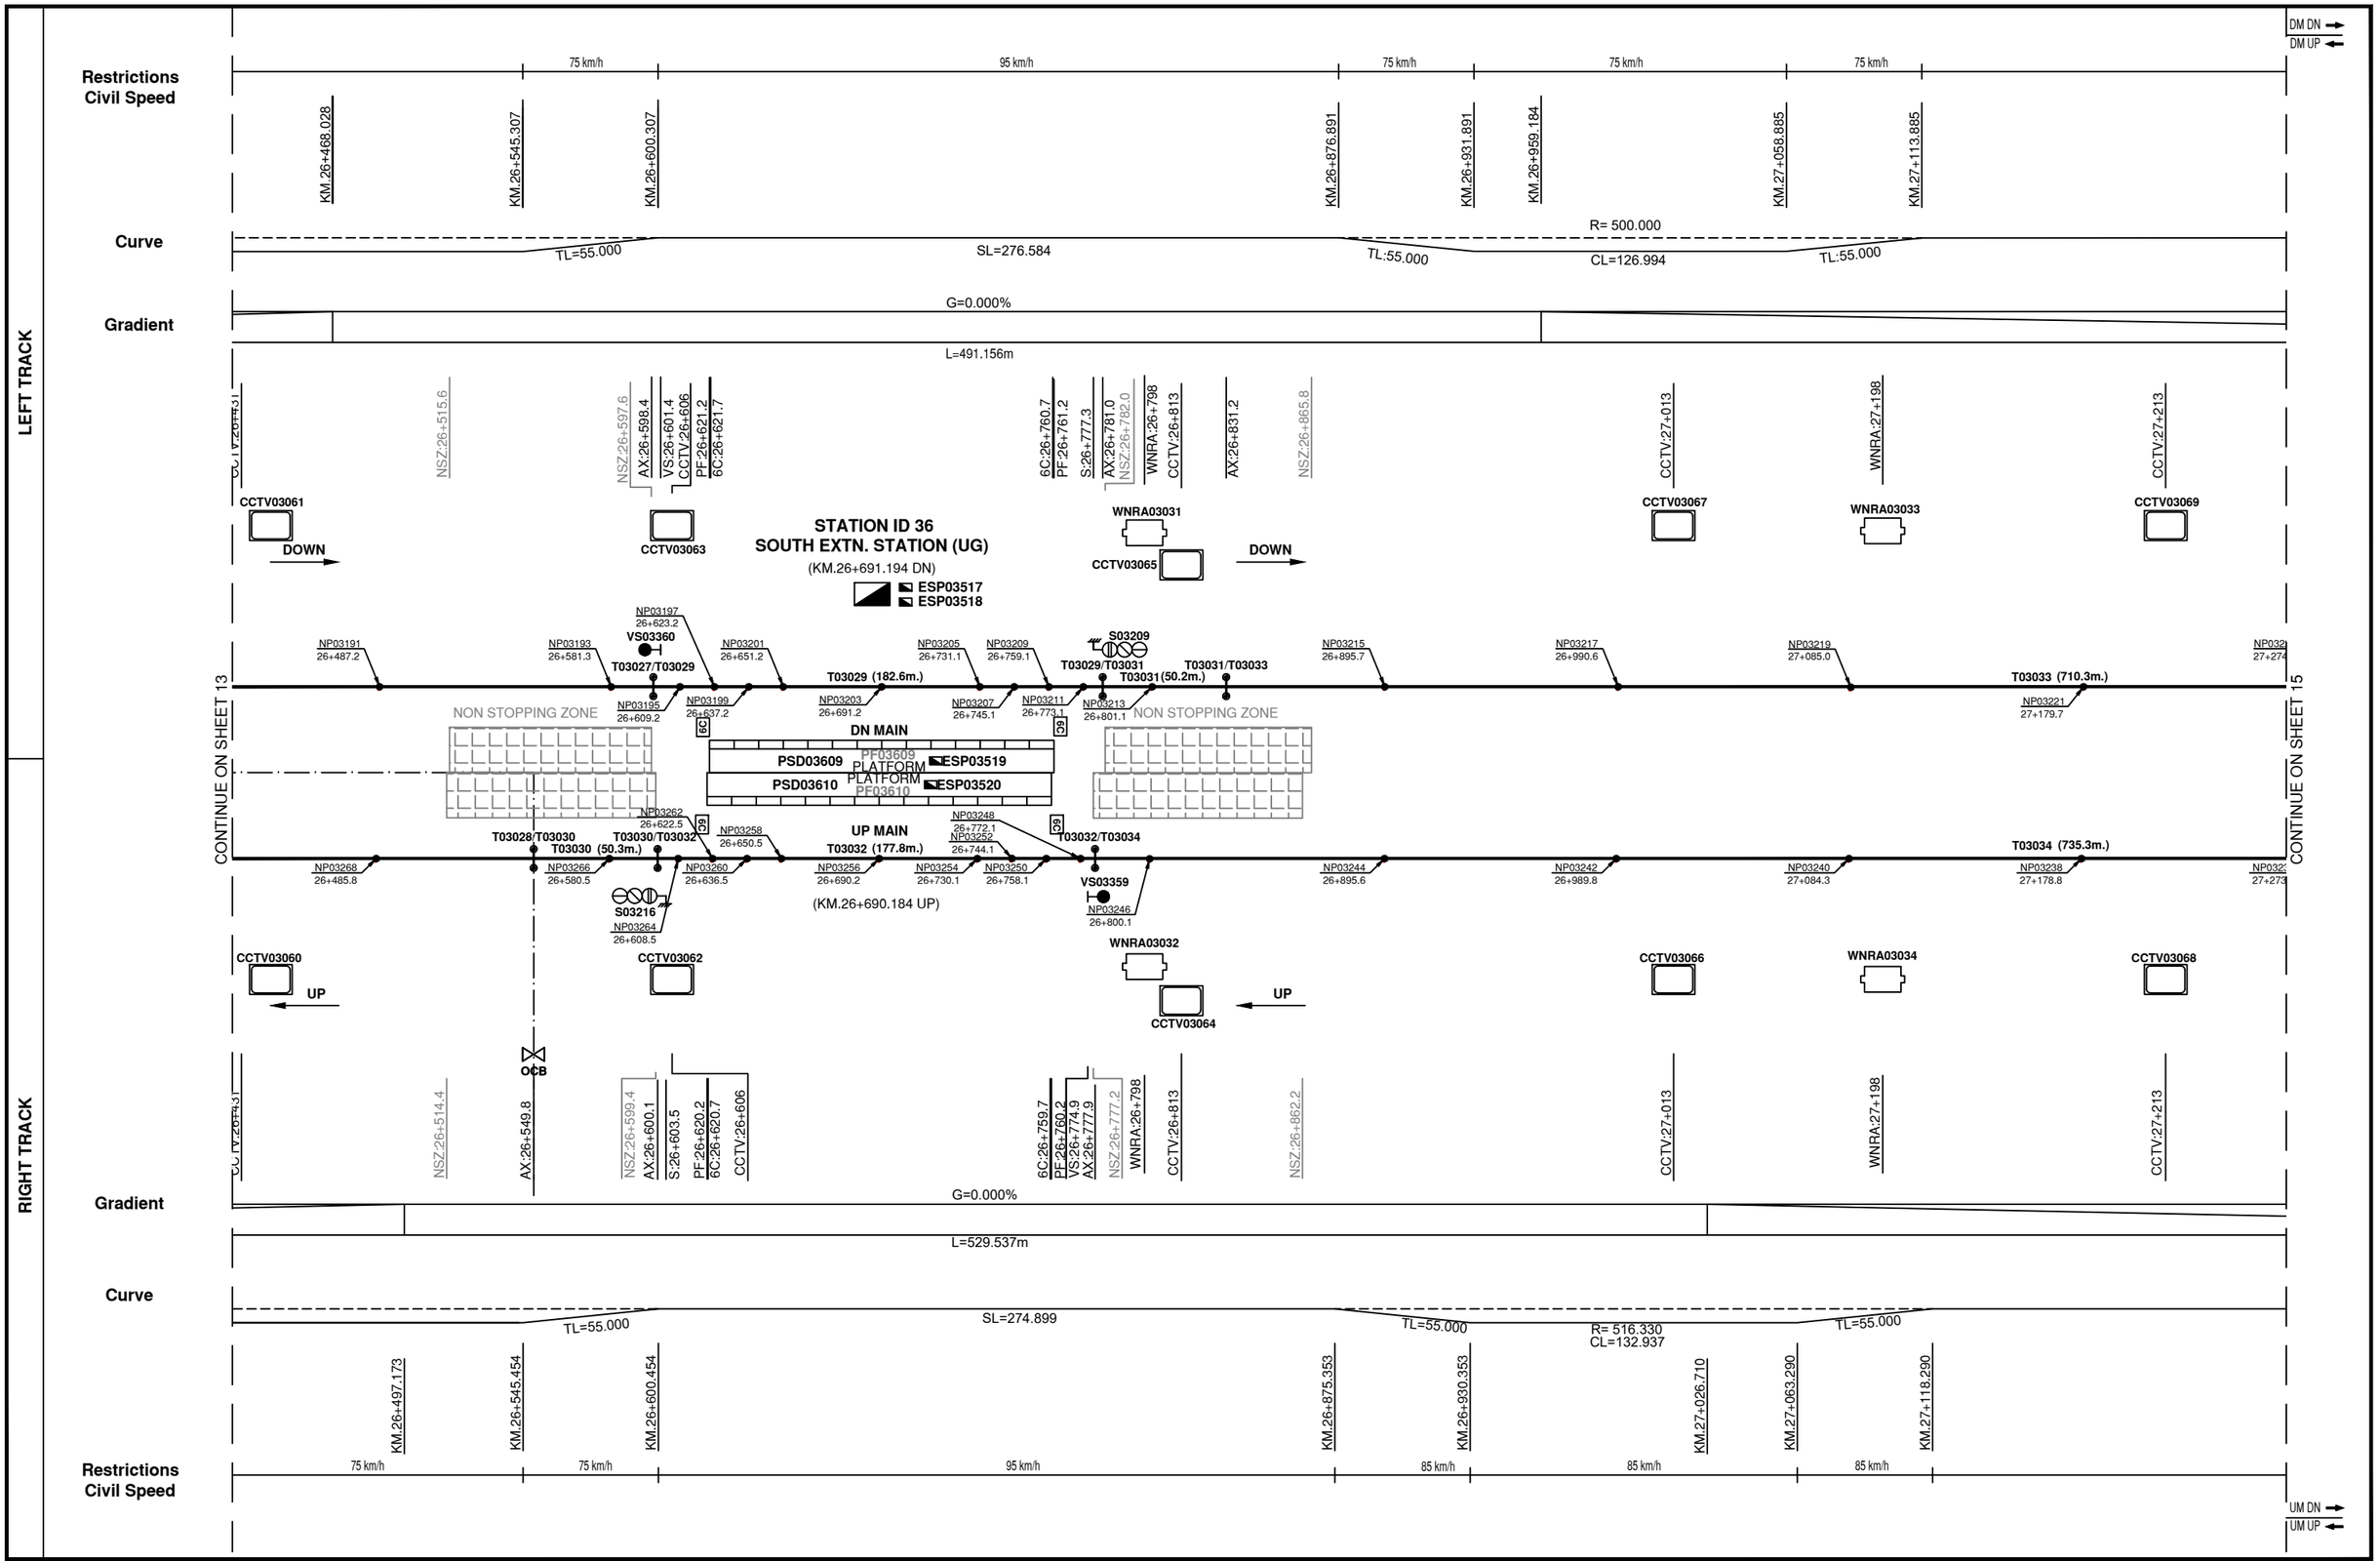

DELHI METRO RAIL CORPORATION LTD.
Metro Bhawan, Fire Brigade Lane, Barakhamba Road, New Delhi-110001

ORIGINATOR:
BOMBARDIER
the evolution of mobility

© 2019, Bombardier Inc.
All rights reserved.

AS-BUILT DRAWING

REV	DATE	DESCRIPTION
8.0	26-JUN-19	AS-BUILT DRAWING

	NAME	DATE
DESIGNED	IRSHAD A.	25-JUN-19
CHECKED	ASHOK K.	26-JUN-19
APPROVED	ROHIT T.	26-JUN-19

DRAWING TITLE:
DELHI MRTS PROJECT PHASE III LINE 7
TRAIN CONTROL & SIGNALLING SYSTEM CONTRACT CS03
TRACK AND SIGNALLING PLAN LINE 7
SIR VISHWESHWARAIAH MOTI BAGH STATION TO HAZRAT NIZAMUDDIN STATION
SECTION-DH

DRAWING No:	COST CENTRE:	SCALE	SHEET	CONT.	REV.
100241842	A PRELIMINARIES AND GENERAL REQUIREMENTS	N/S	14	15	8.0

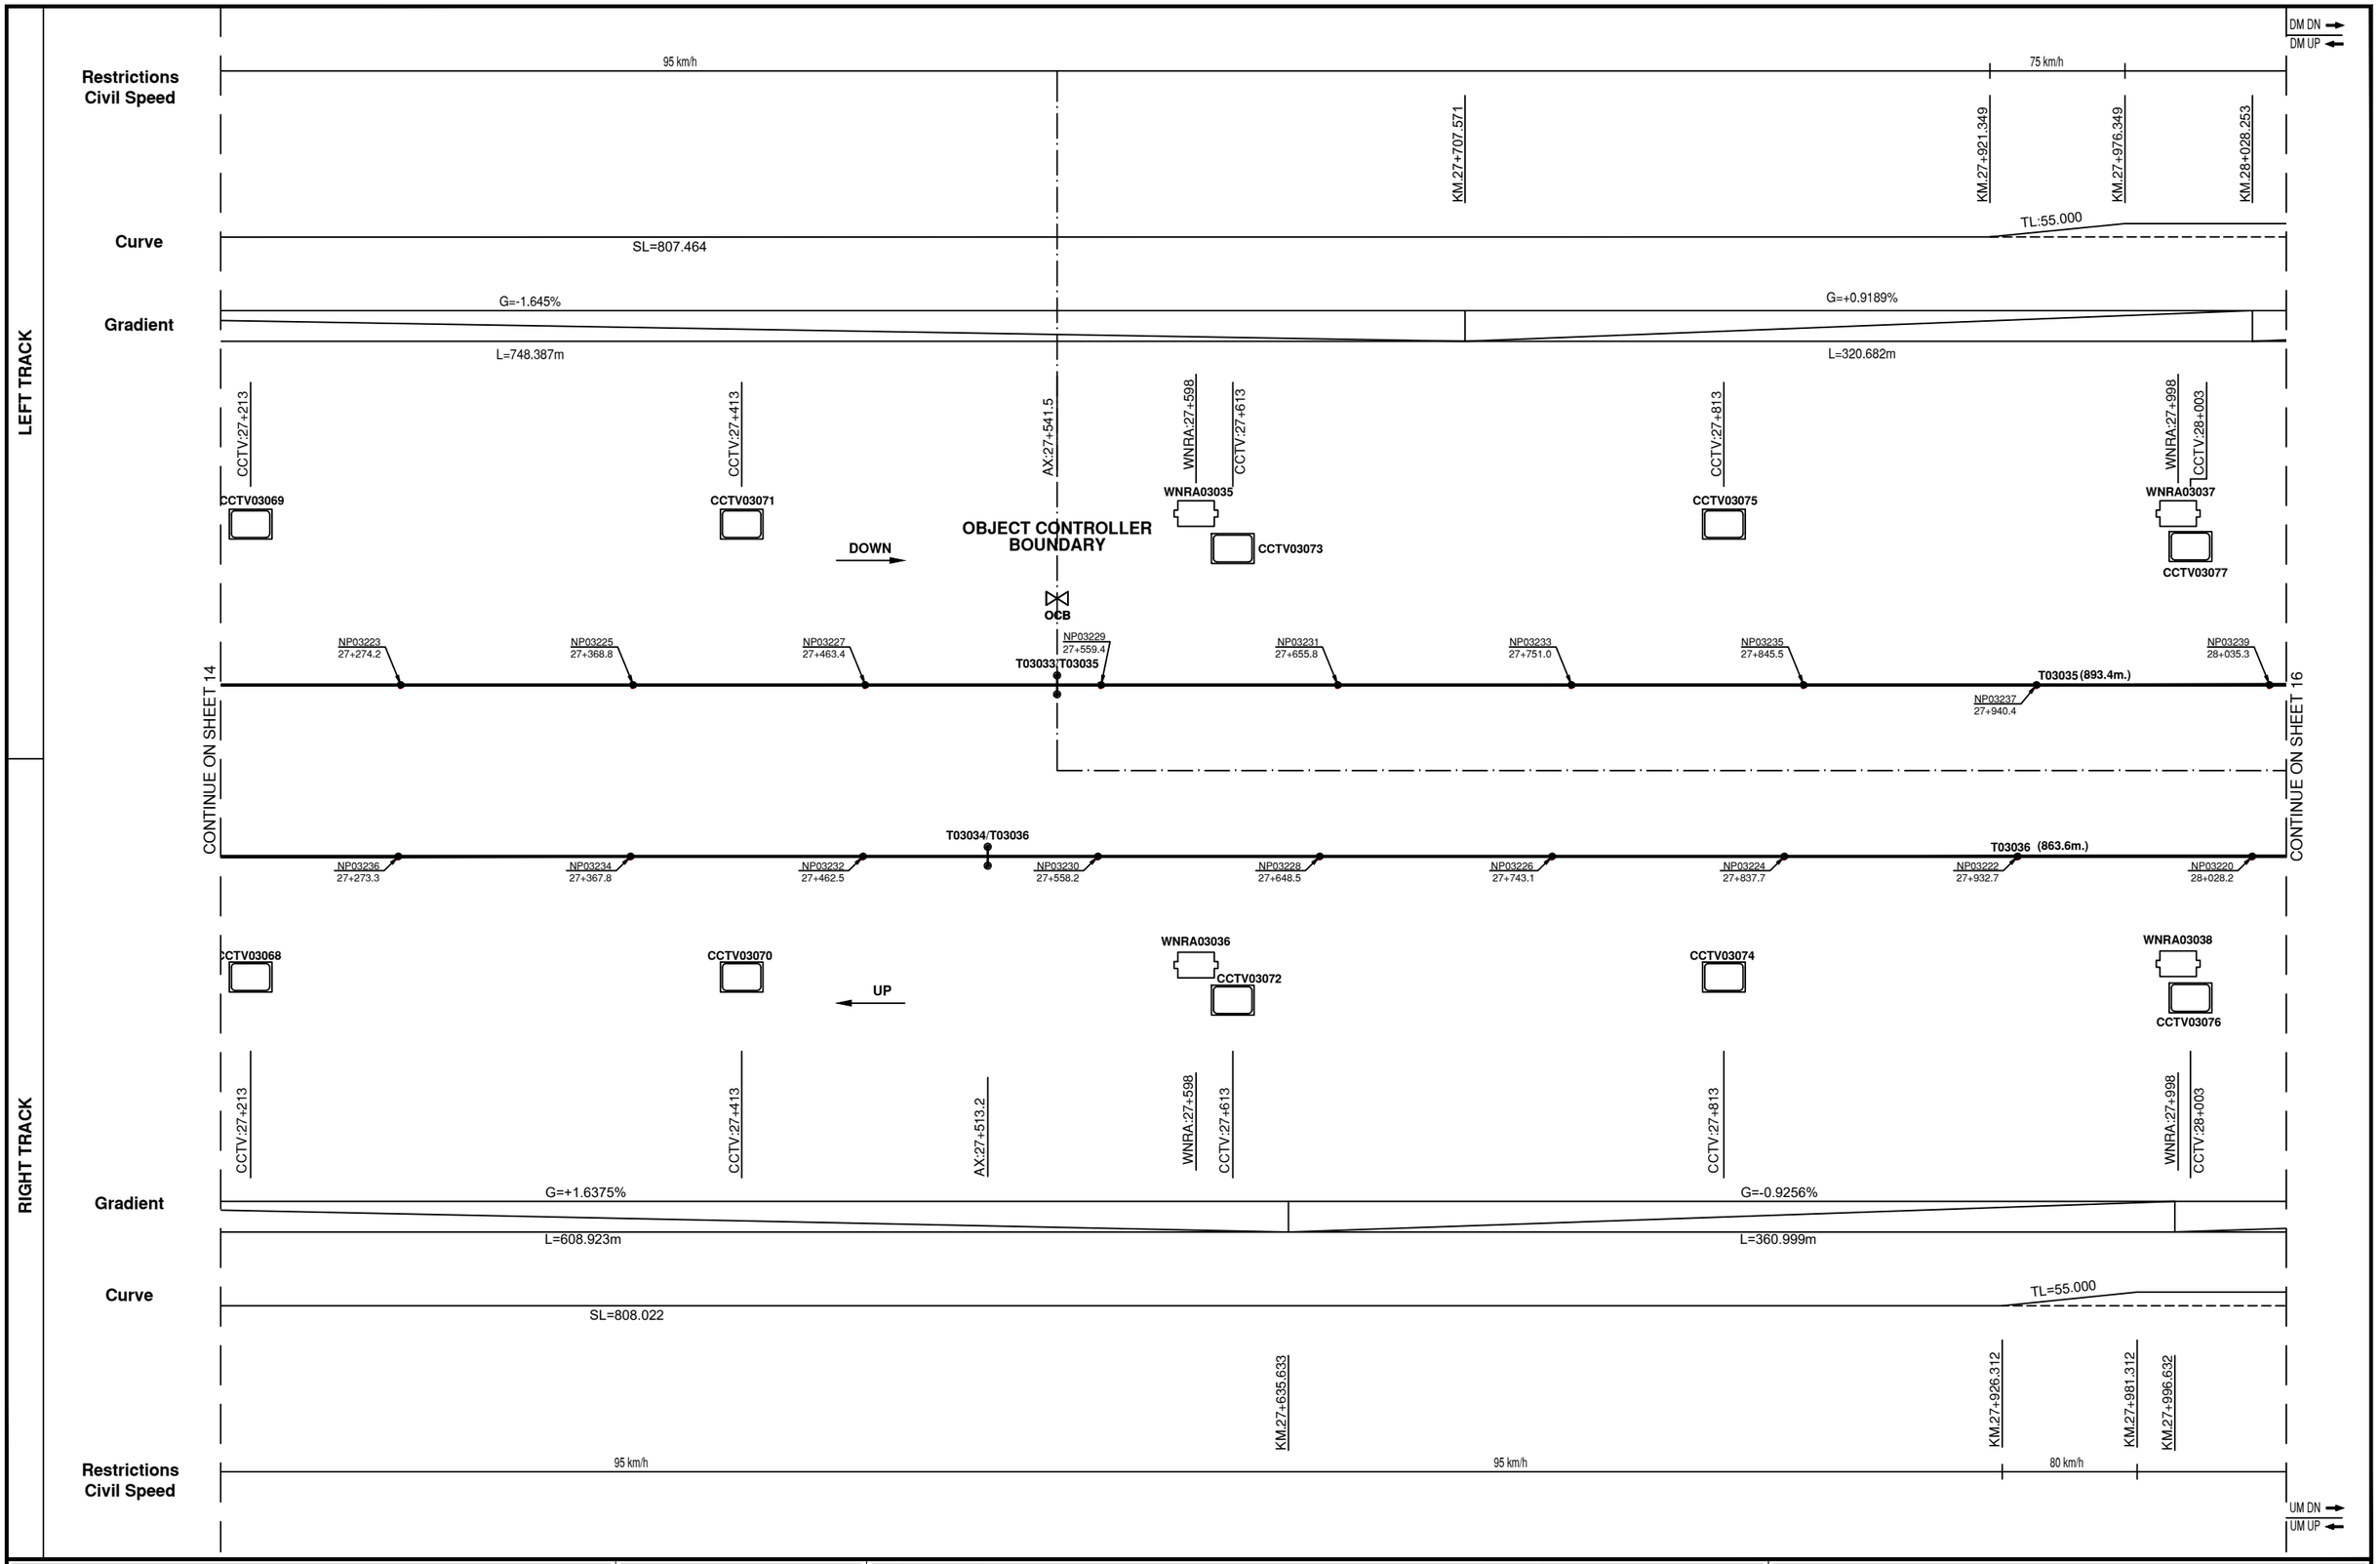

DELHI METRO RAIL CORPORATION LTD.
Metro Bhawan, Fire Brigade Lane, Barakhamba Road, New Delhi-110001

ORIGINATOR:
BOMBARDIER
the evolution of mobility

© 2019, Bombardier Inc. All rights reserved.

AS-BUILT DRAWING

REV	DATE	DESCRIPTION
8.0	26-JUN-19	AS-BUILT DRAWING

	NAME	DATE
DESIGNED	IRSHAD A.	25-JUN-19
CHECKED	ASHOK K.	26-JUN-19
APPROVED	ROHIT T.	26-JUN-19

DRAWING TITLE:
DELHI MRTS PROJECT PHASE III LINE 7
TRAIN CONTROL & SIGNALLING SYSTEM CONTRACT CS03
TRACK AND SIGNALLING PLAN LINE 7
SIR VISHWESHWARAIAH MOTI BAGH STATION TO HAZRAT NIZAMUDDIN STATION
SECTION-DH

DRAWING No:	COST CENTRE:	SCALE	SHEET	CONT.	REV.
100241842	A PRELIMINARIES AND GENERAL REQUIREMENTS	N/S	15	16	8.0

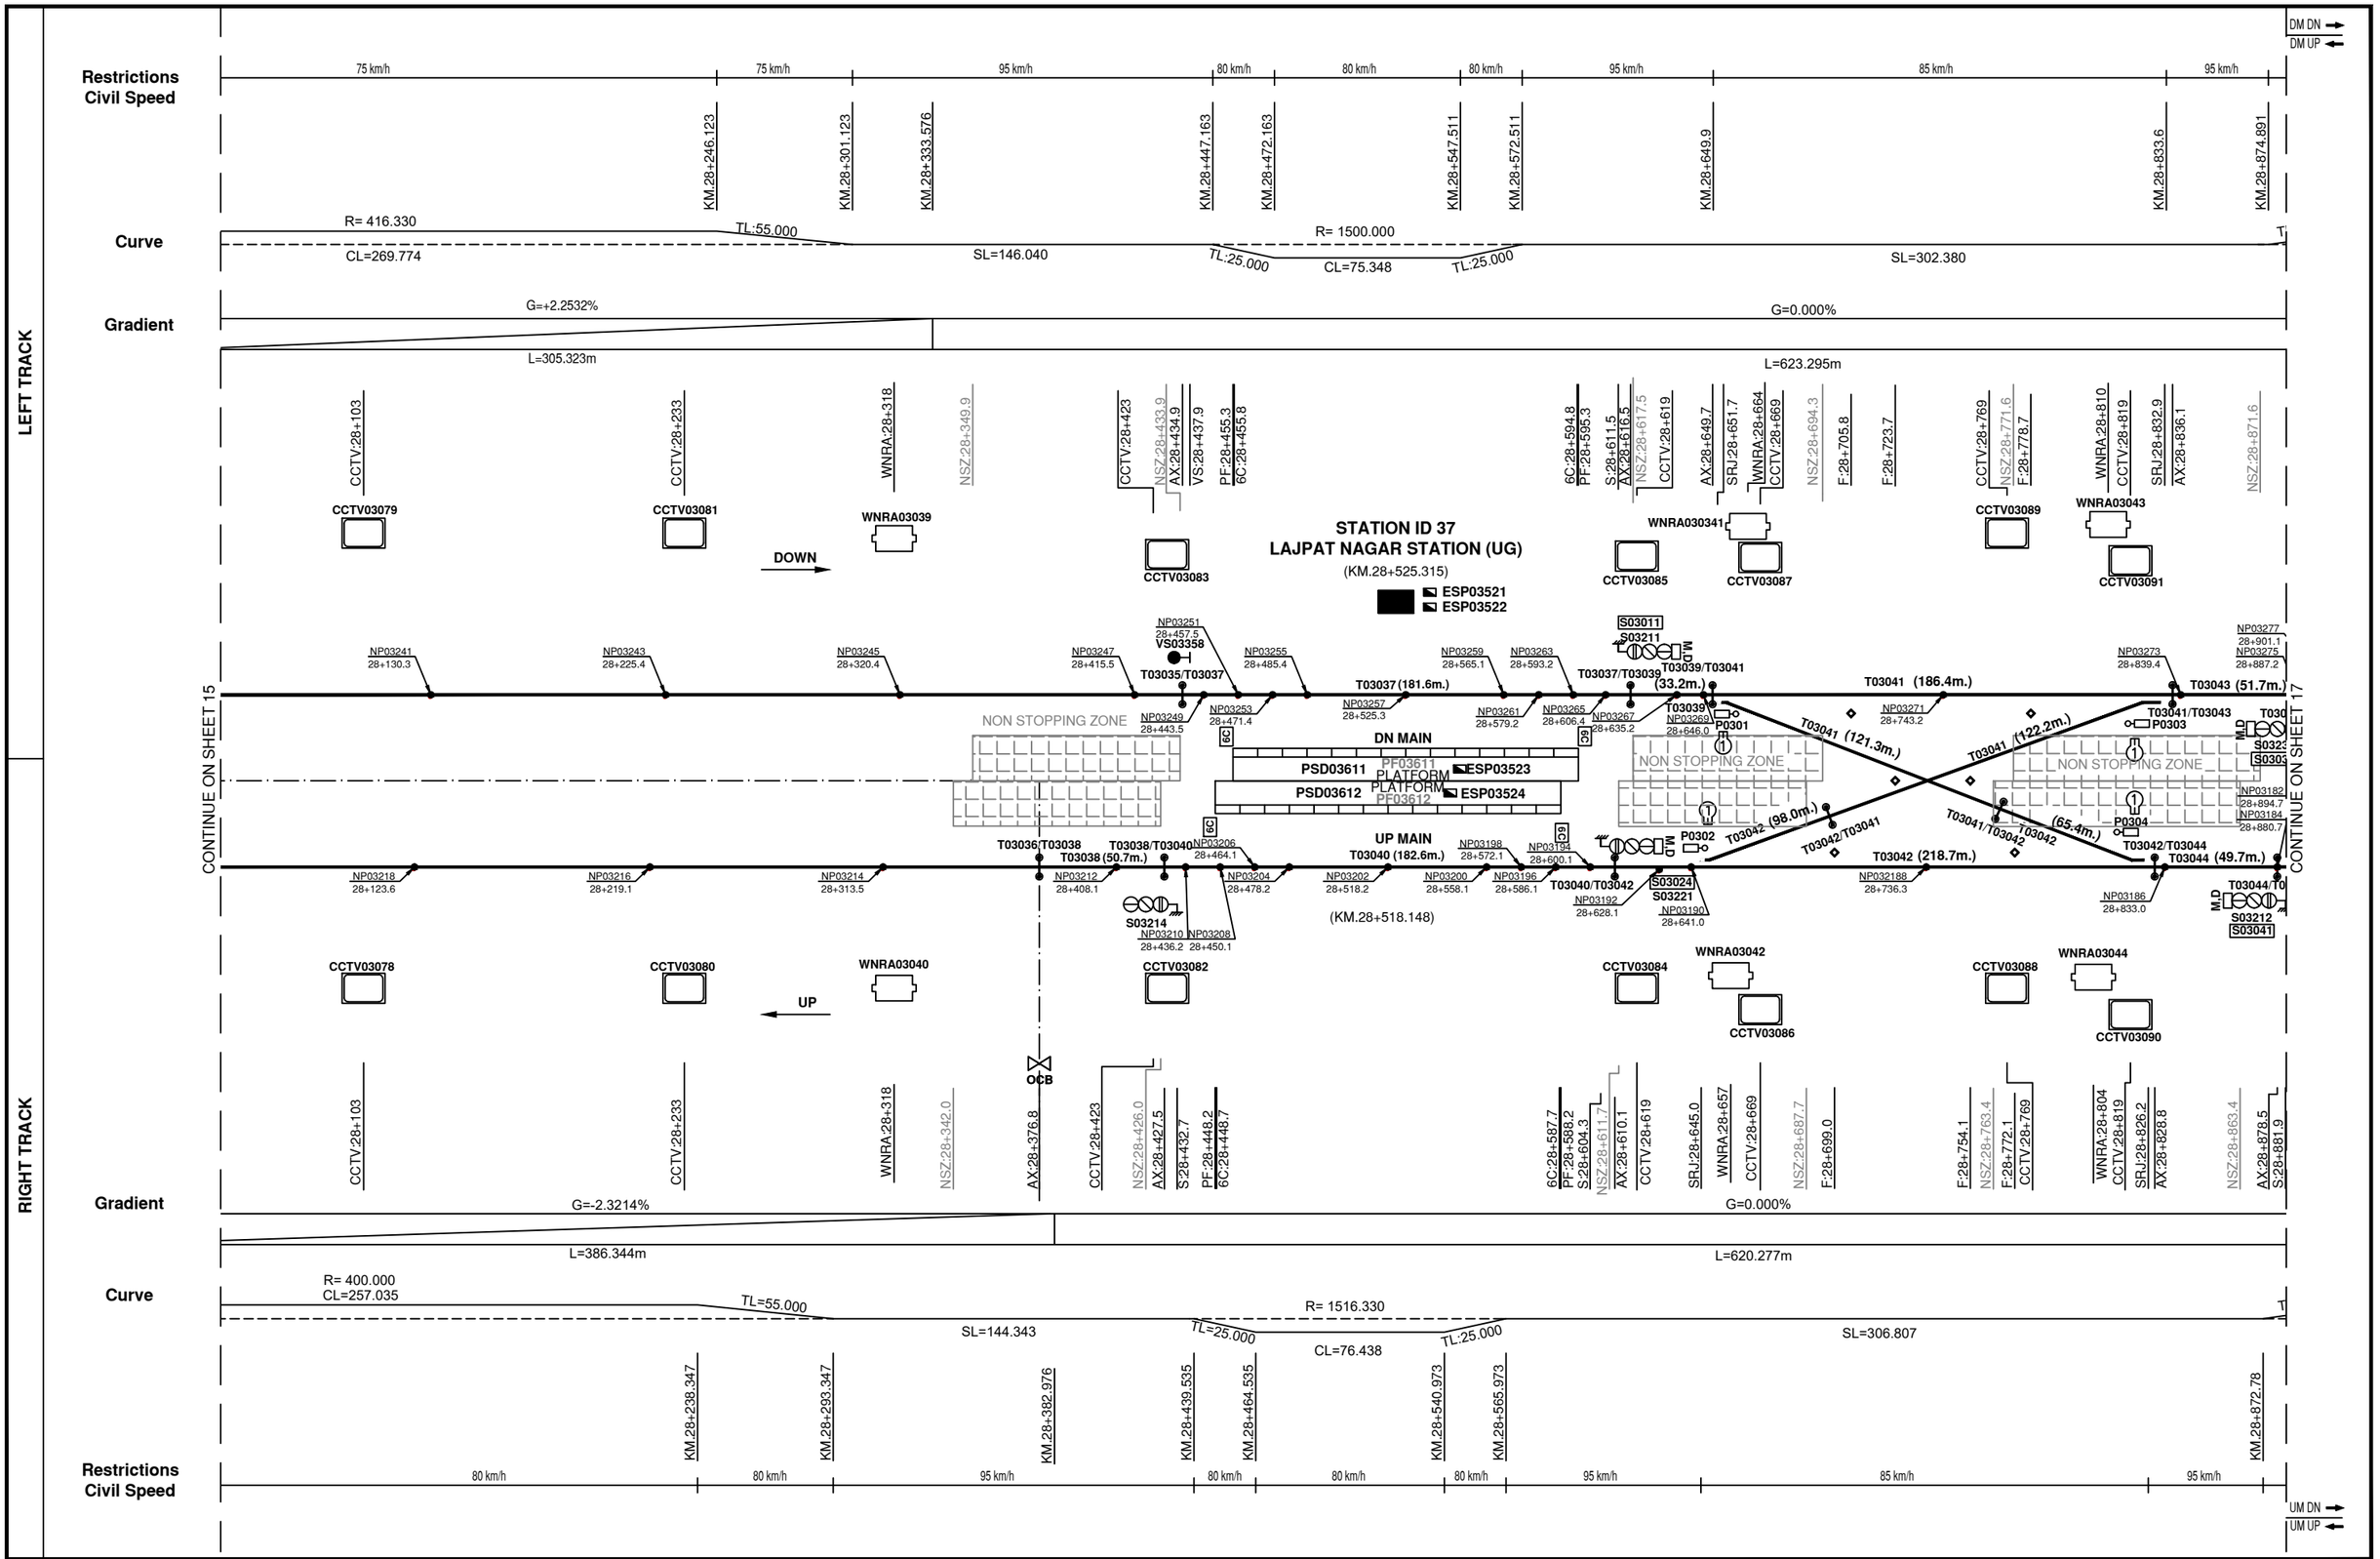

DELHI METRO RAIL CORPORATION LTD.
Metro Bhawan, Fire Brigade Lane, Barakhamba Road, New Delhi-110001

ORIGINATOR:
BOMBARDIER
the evolution of mobility

© 2019, Bombardier Inc.
All rights reserved.

AS-BUILT DRAWING

REV	DATE	DESCRIPTION
8.0	26-JUN-19	AS-BUILT DRAWING

	NAME	DATE
DESIGNED	IRSHAD A.	25-JUN-19
CHECKED	ASHOK K.	26-JUN-19
APPROVED	ROHIT T.	26-JUN-19

DRAWING TITLE:
DELHI MRTS PROJECT PHASE III LINE 7
TRAIN CONTROL & SIGNALLING SYSTEM CONTRACT CS03
TRACK AND SIGNALLING PLAN LINE 7
SIR VISHWESHWARAIAH MOTI BAGH STATION TO HAZRAT NIZAMUDDIN STATION
SECTION-DH

DRAWING No:	COST CENTRE:	SCALE	SHEET	CONT.	REV.
100241842	A PRELIMINARIES AND GENERAL REQUIREMENTS	N/S	16	17	8.0

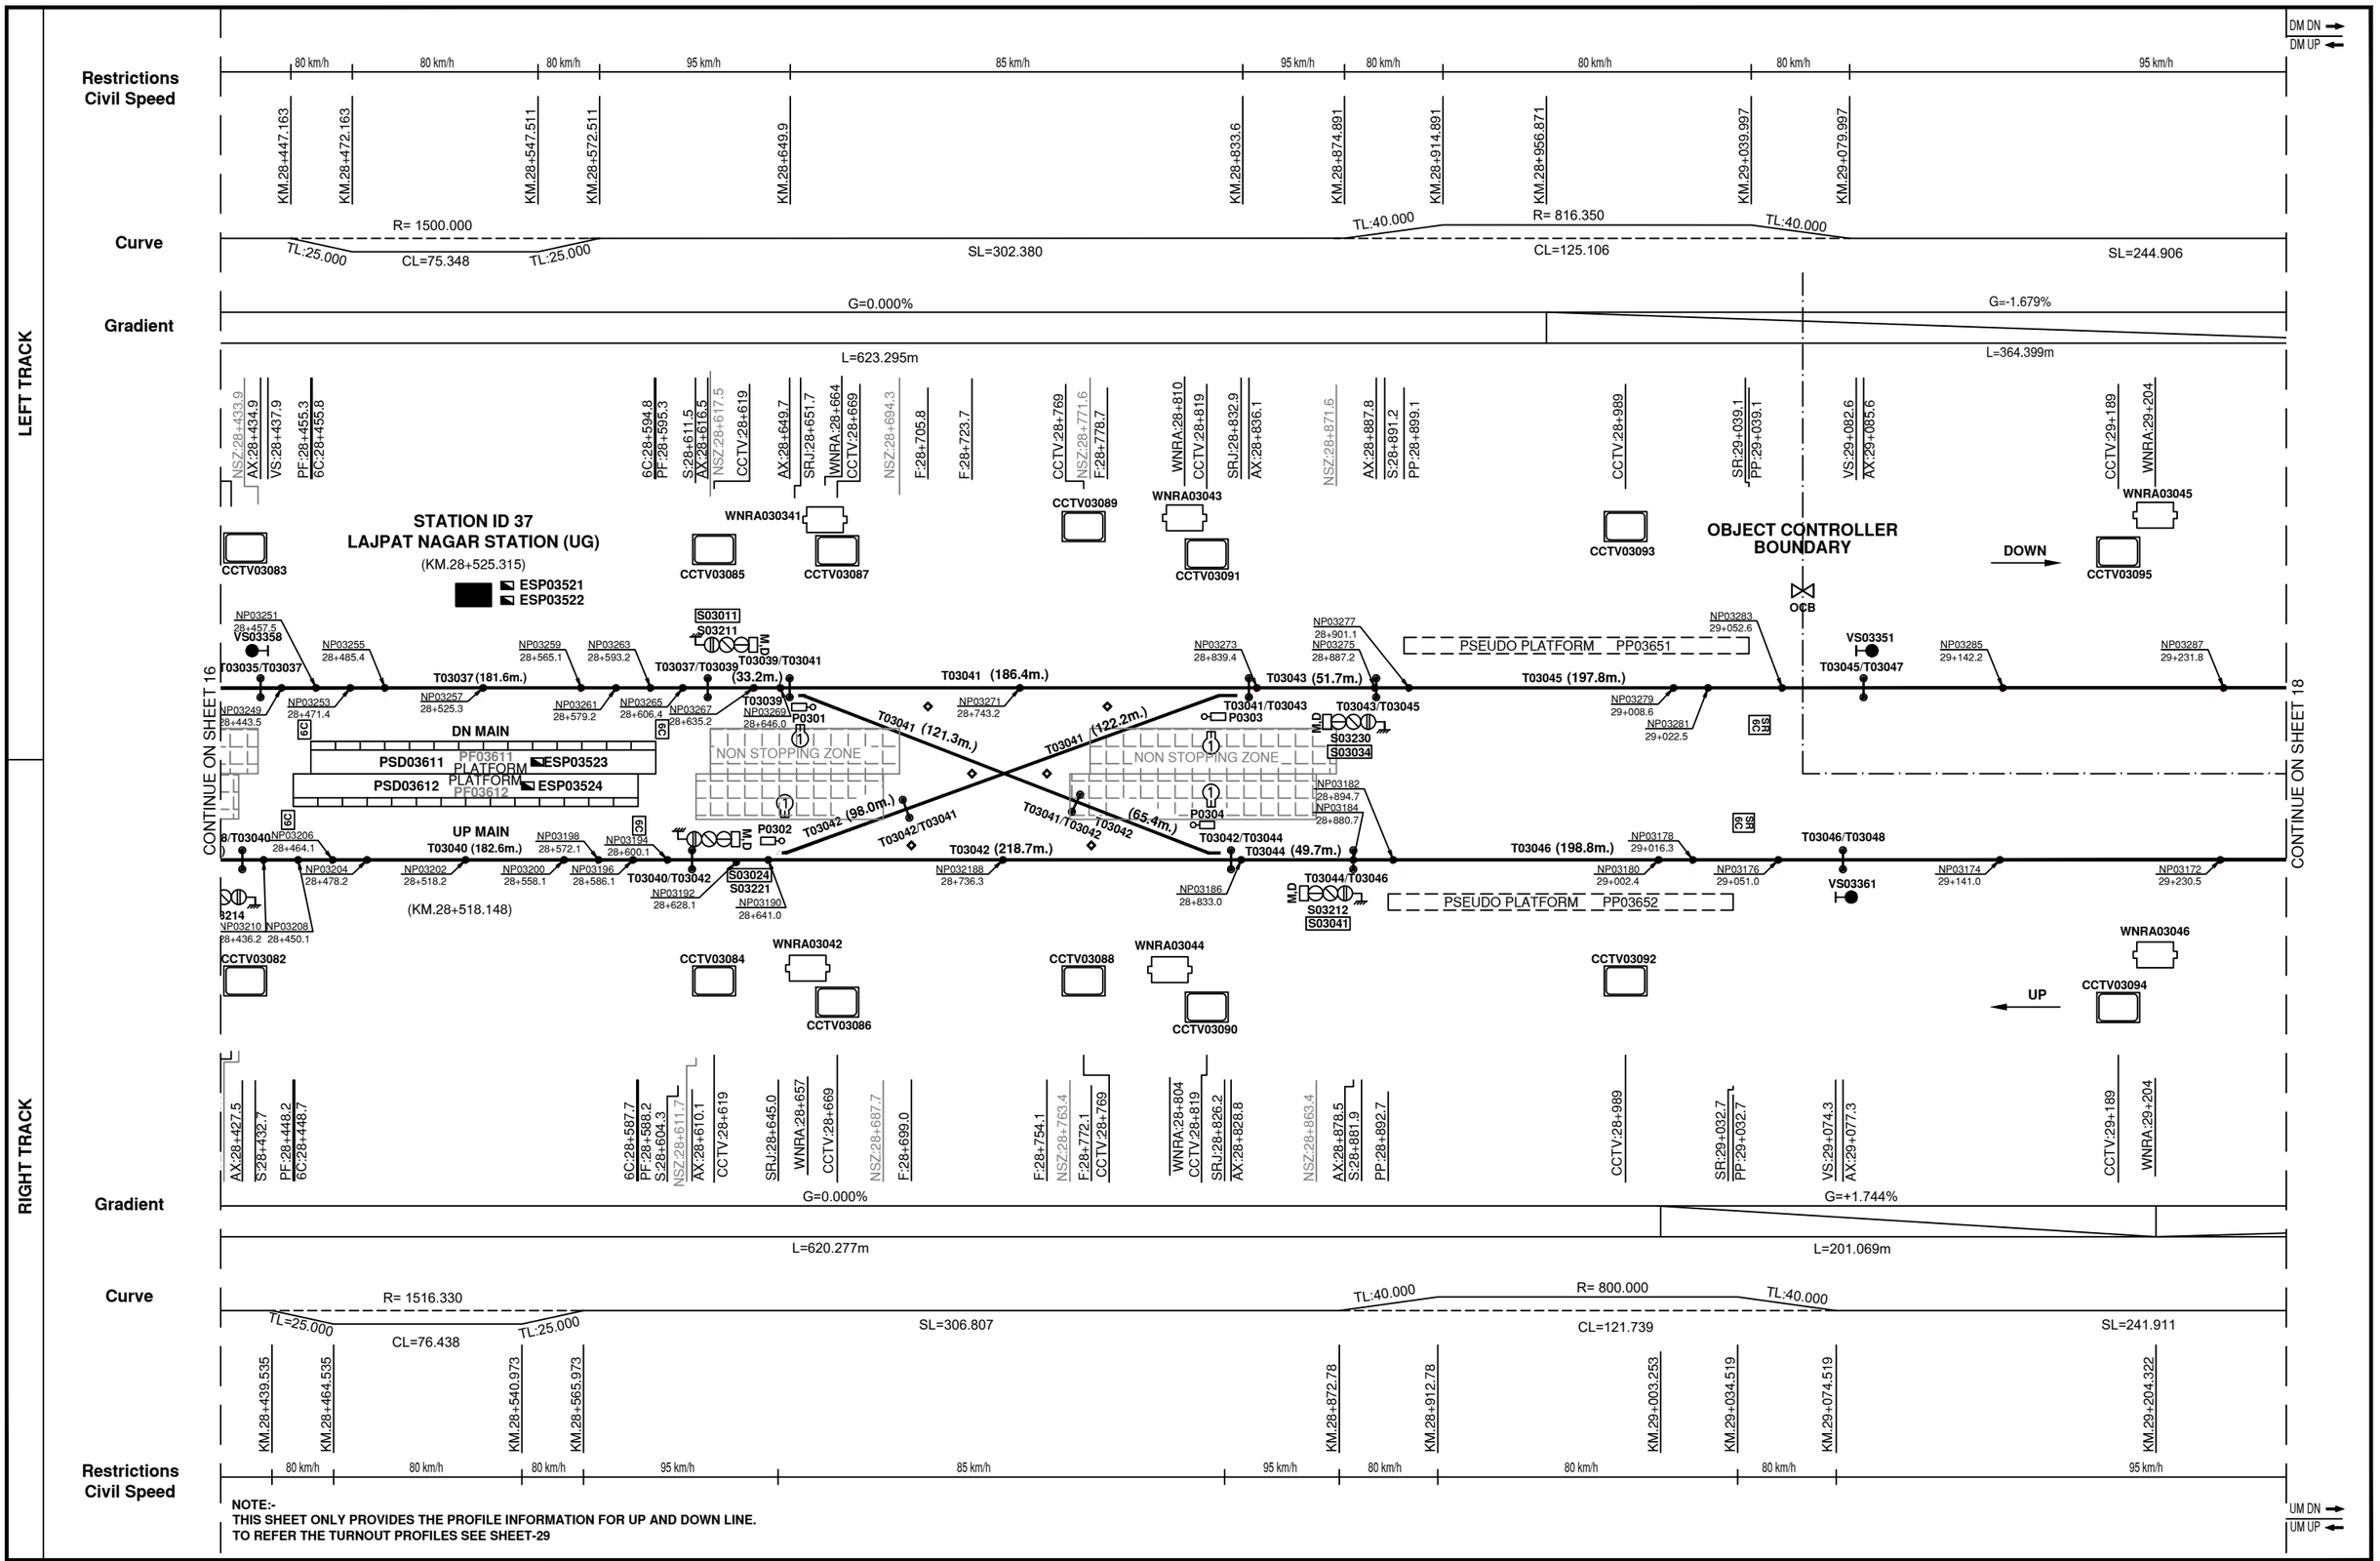

NOTE:-
THIS SHEET ONLY PROVIDES THE PROFILE INFORMATION FOR UP AND DOWN LINE.
TO REFER THE TURNOUT PROFILES SEE SHEET-29

DELHI METRO RAIL CORPORATION LTD.
Metro Bhawan, Fire Brigade Lane, Barakhamba Road, New Delhi-110001

ORIGINATOR:
BOMBARDIER
the evolution of mobility

© 2019, Bombardier Inc.
All rights reserved.

AS-BUILT DRAWING

REV	DATE	DESCRIPTION
8.0	26-JUN-19	AS-BUILT DRAWING

	NAME	DATE
DESIGNED	IRSHAD A.	25-JUN-19
CHECKED	ASHOK K.	26-JUN-19
APPROVED	ROHIT T.	26-JUN-19

DRAWING TITLE: DELHI MRTS PROJECT PHASE III LINE 7
TRAIN CONTROL & SIGNALLING SYSTEM CONTRACT CS03
TRACK AND SIGNALLING PLAN LINE 7
SIR VISHWESHWARAIAH MOTI BAGH STATION TO HAZRAT NIZAMUDDIN STATION
SECTION-DH

DRAWING No:	COST CENTRE:	SCALE	SHEET	CONT.	REV.
100241842	A PRELIMINARIES AND GENERAL REQUIREMENTS	N/S	17	18	8.0

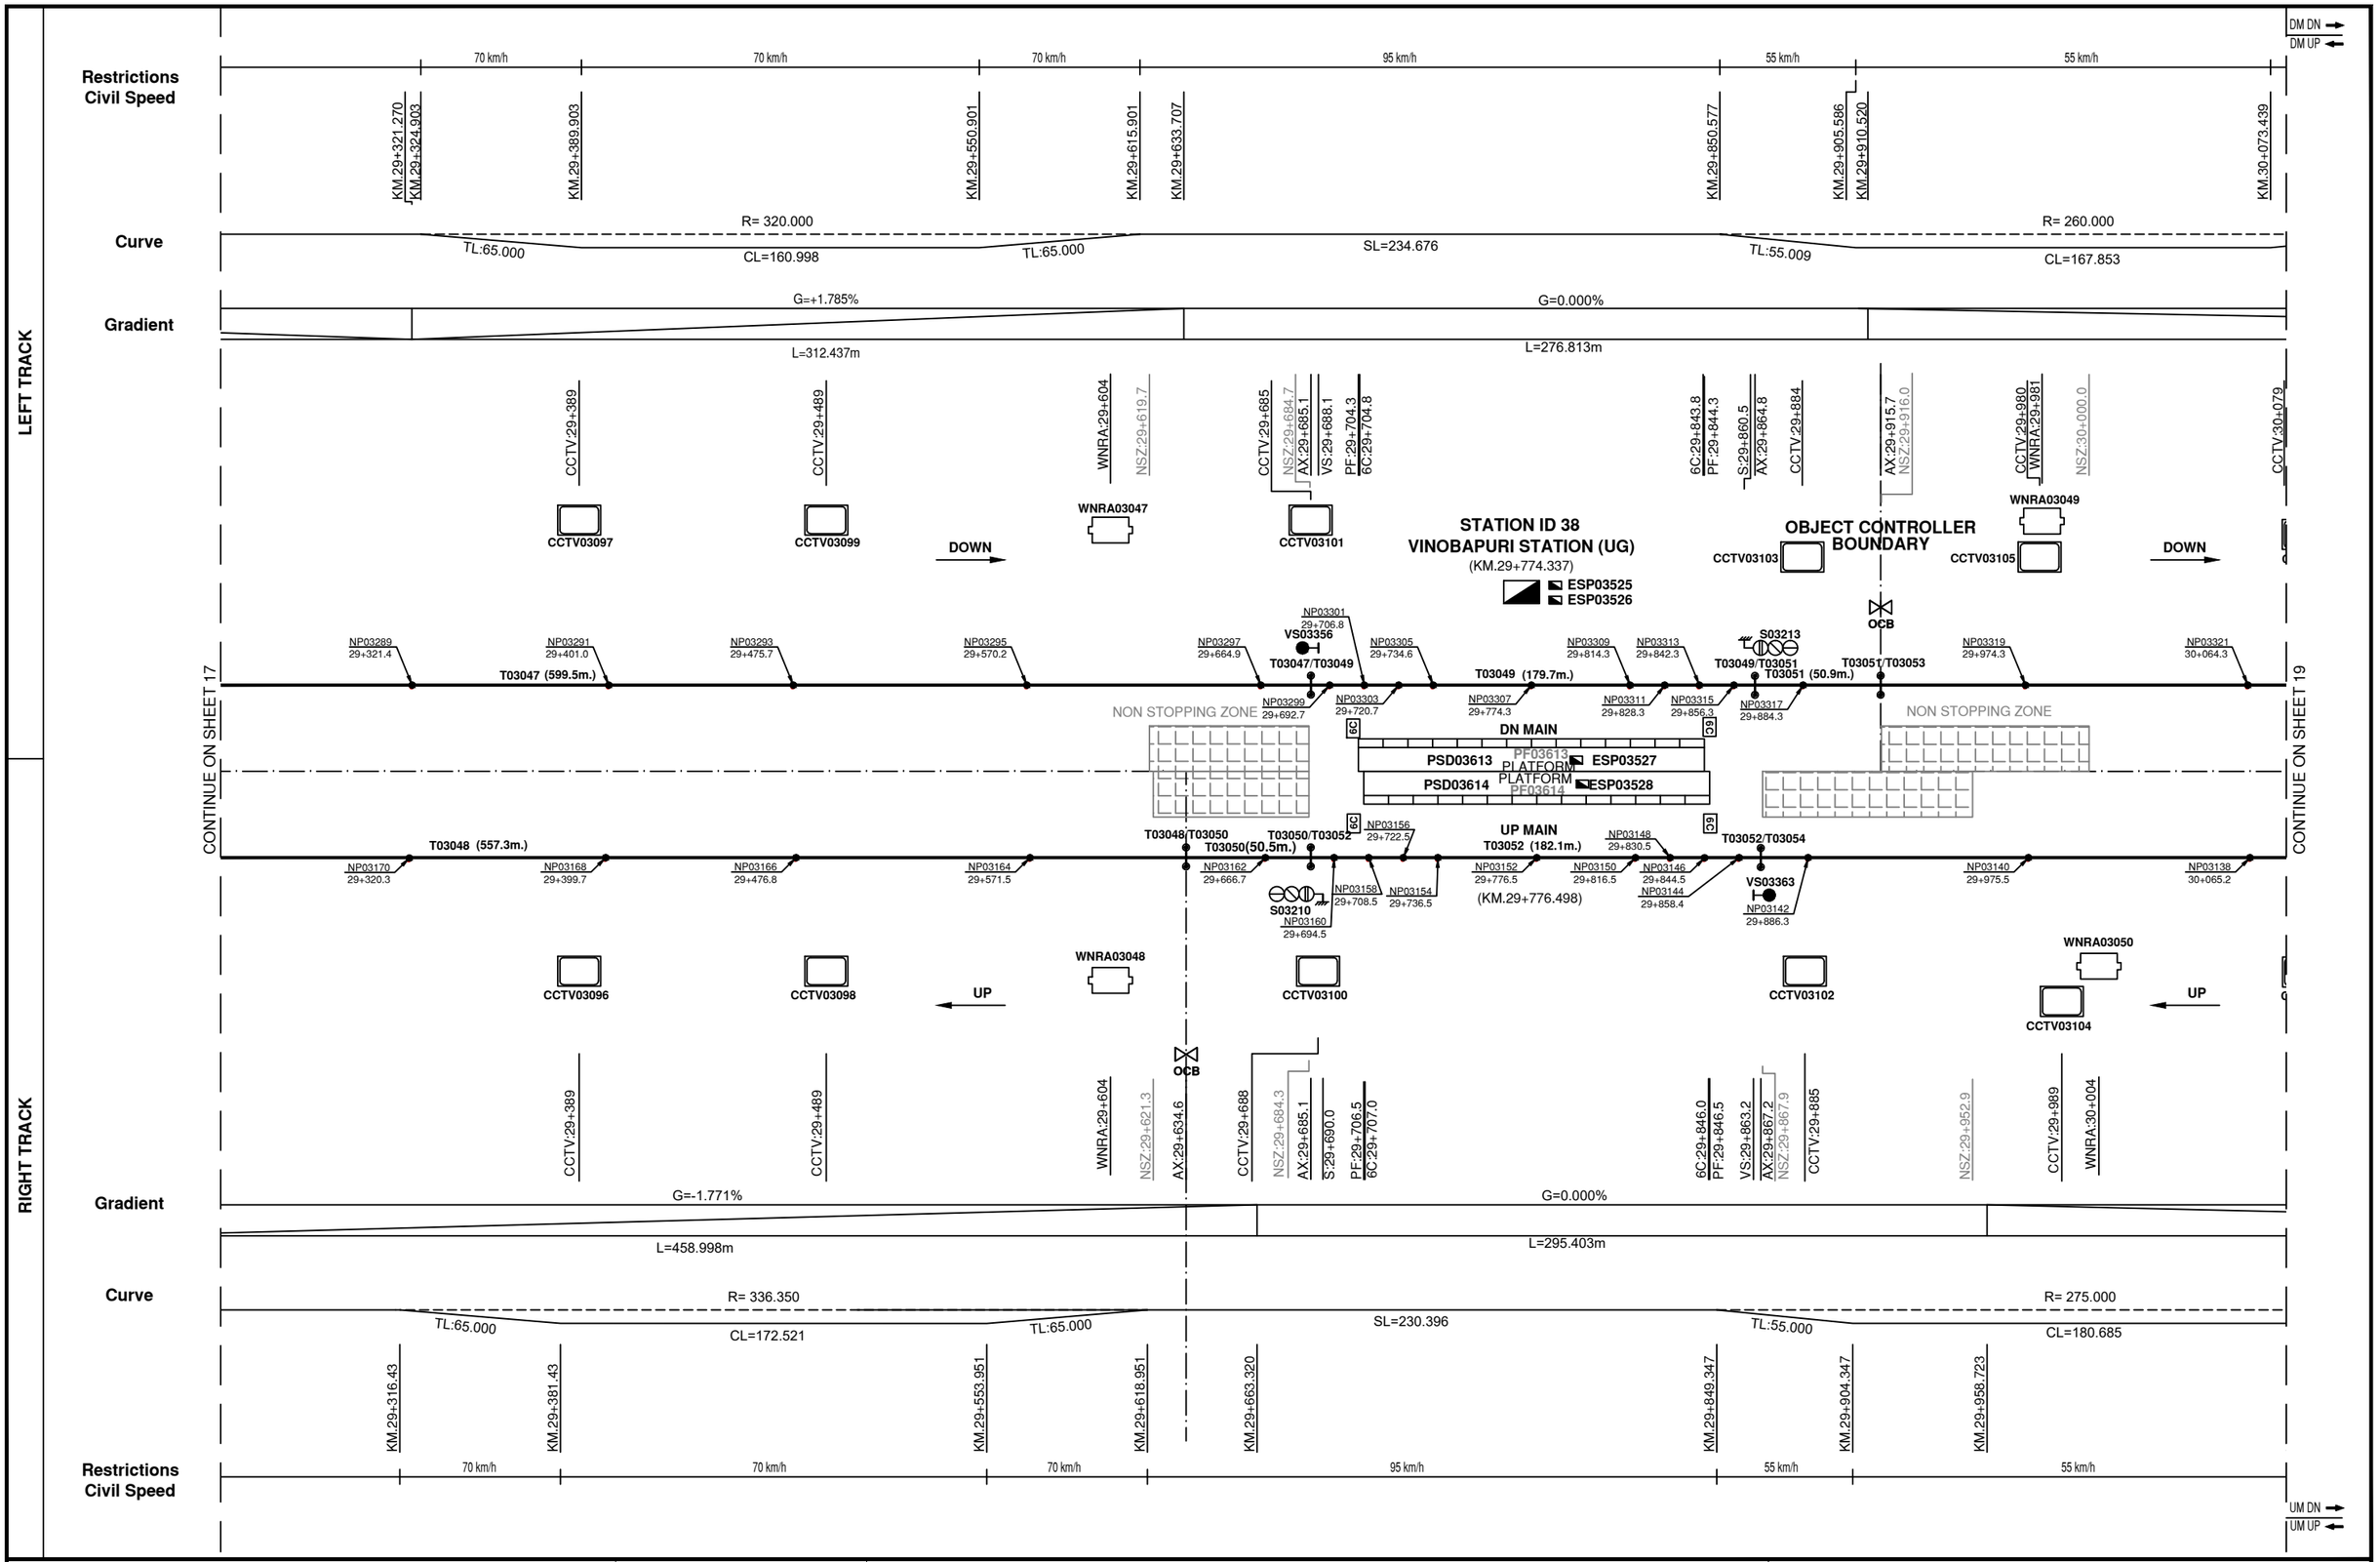

DELHI METRO RAIL CORPORATION LTD.
Metro Bhawan, Fire Brigade Lane, Barakhamba Road, New Delhi-110001

ORIGINATOR:
BOMBARDIER
the evolution of mobility

© 2019, Bombardier Inc.
All rights reserved.

AS-BUILT DRAWING

REV	DATE	DESCRIPTION
8.0	26–JUN–19	AS–BUILT DRAWING

	NAME	DATE
DESIGNED	IRSHAD A.	25–JUN–19
CHECKED	ASHOK K.	26–JUN–19
APPROVED	ROHIT T.	26–JUN–19

DRAWING TITLE:
DELHI MRTS PROJECT PHASE III LINE 7
TRAIN CONTROL & SIGNALLING SYSTEM CONTRACT CS03
TRACK AND SIGNALLING PLAN LINE 7
SIR VISHWESHWARAIAH MOTI BAGH STATION TO HAZRAT NIZAMUDDIN STATION
SECTION-DH

DRAWING No:	COST CENTRE:	SCALE	SHEET	CONT.	REV.
100241842	A PRELIMINARIES AND GENERAL REQUIREMENTS	N/S	18	19	8.0

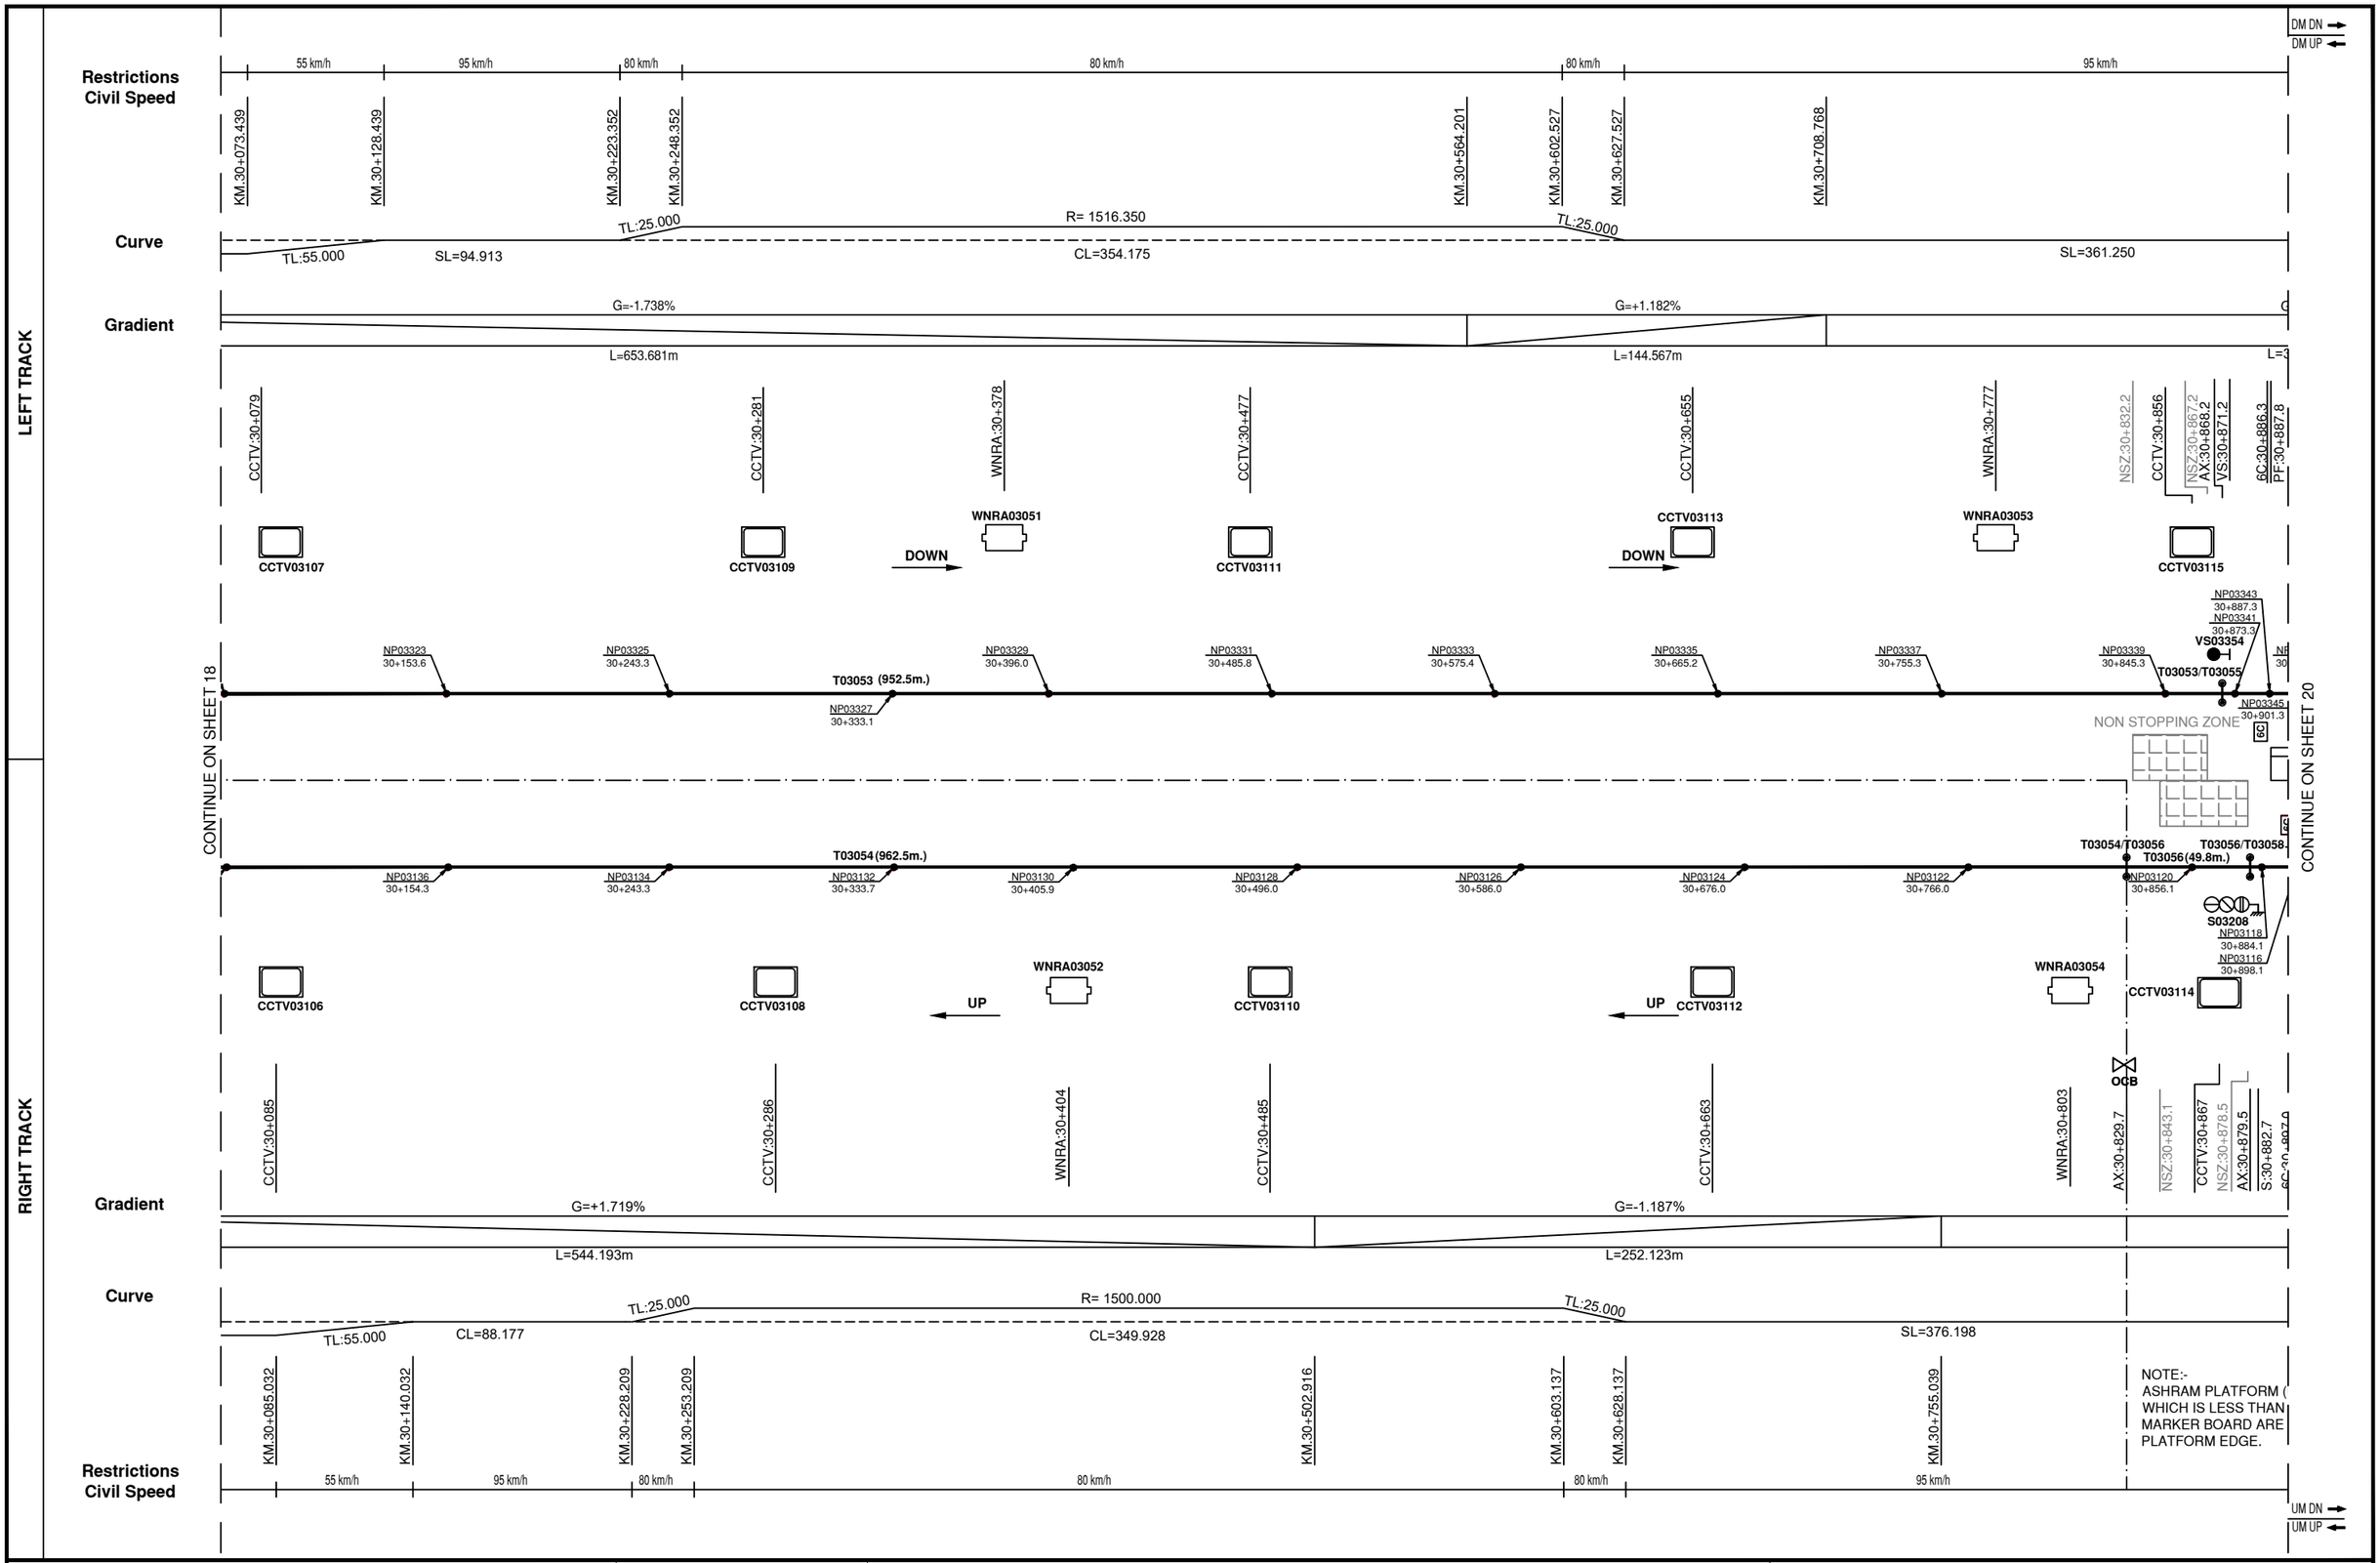

DELHI METRO RAIL CORPORATION LTD.
Metro Bhawan, Fire Brigade Lane, Barakhamba Road, New Delhi-110001

ORIGINATOR:
BOMBARDIER
the evolution of mobility

© 2019, Bombardier Inc.
All rights reserved.

AS-BUILT DRAWING

REV	DATE	DESCRIPTION
8.0	26-JUN-19	AS-BUILT DRAWING

	NAME	DATE
DESIGNED	IRSHAD A.	25-JUN-19
CHECKED	ASHOK K.	26-JUN-19
APPROVED	ROHIT T.	26-JUN-19

DRAWING TITLE:
DELHI MRTS PROJECT PHASE III LINE 7
TRAIN CONTROL & SIGNALLING SYSTEM CONTRACT CS03
TRACK AND SIGNALLING PLAN LINE 7
SIR VISHWESHWARAIAH MOTI BAGH STATION TO HAZRAT NIZAMUDDIN STATION
SECTION-DH

DRAWING No:	COST CENTRE:	SCALE	SHEET	CONT.	REV.
100241842	A PRELIMINARIES AND GENERAL REQUIREMENTS	N/S	19	20	8.0

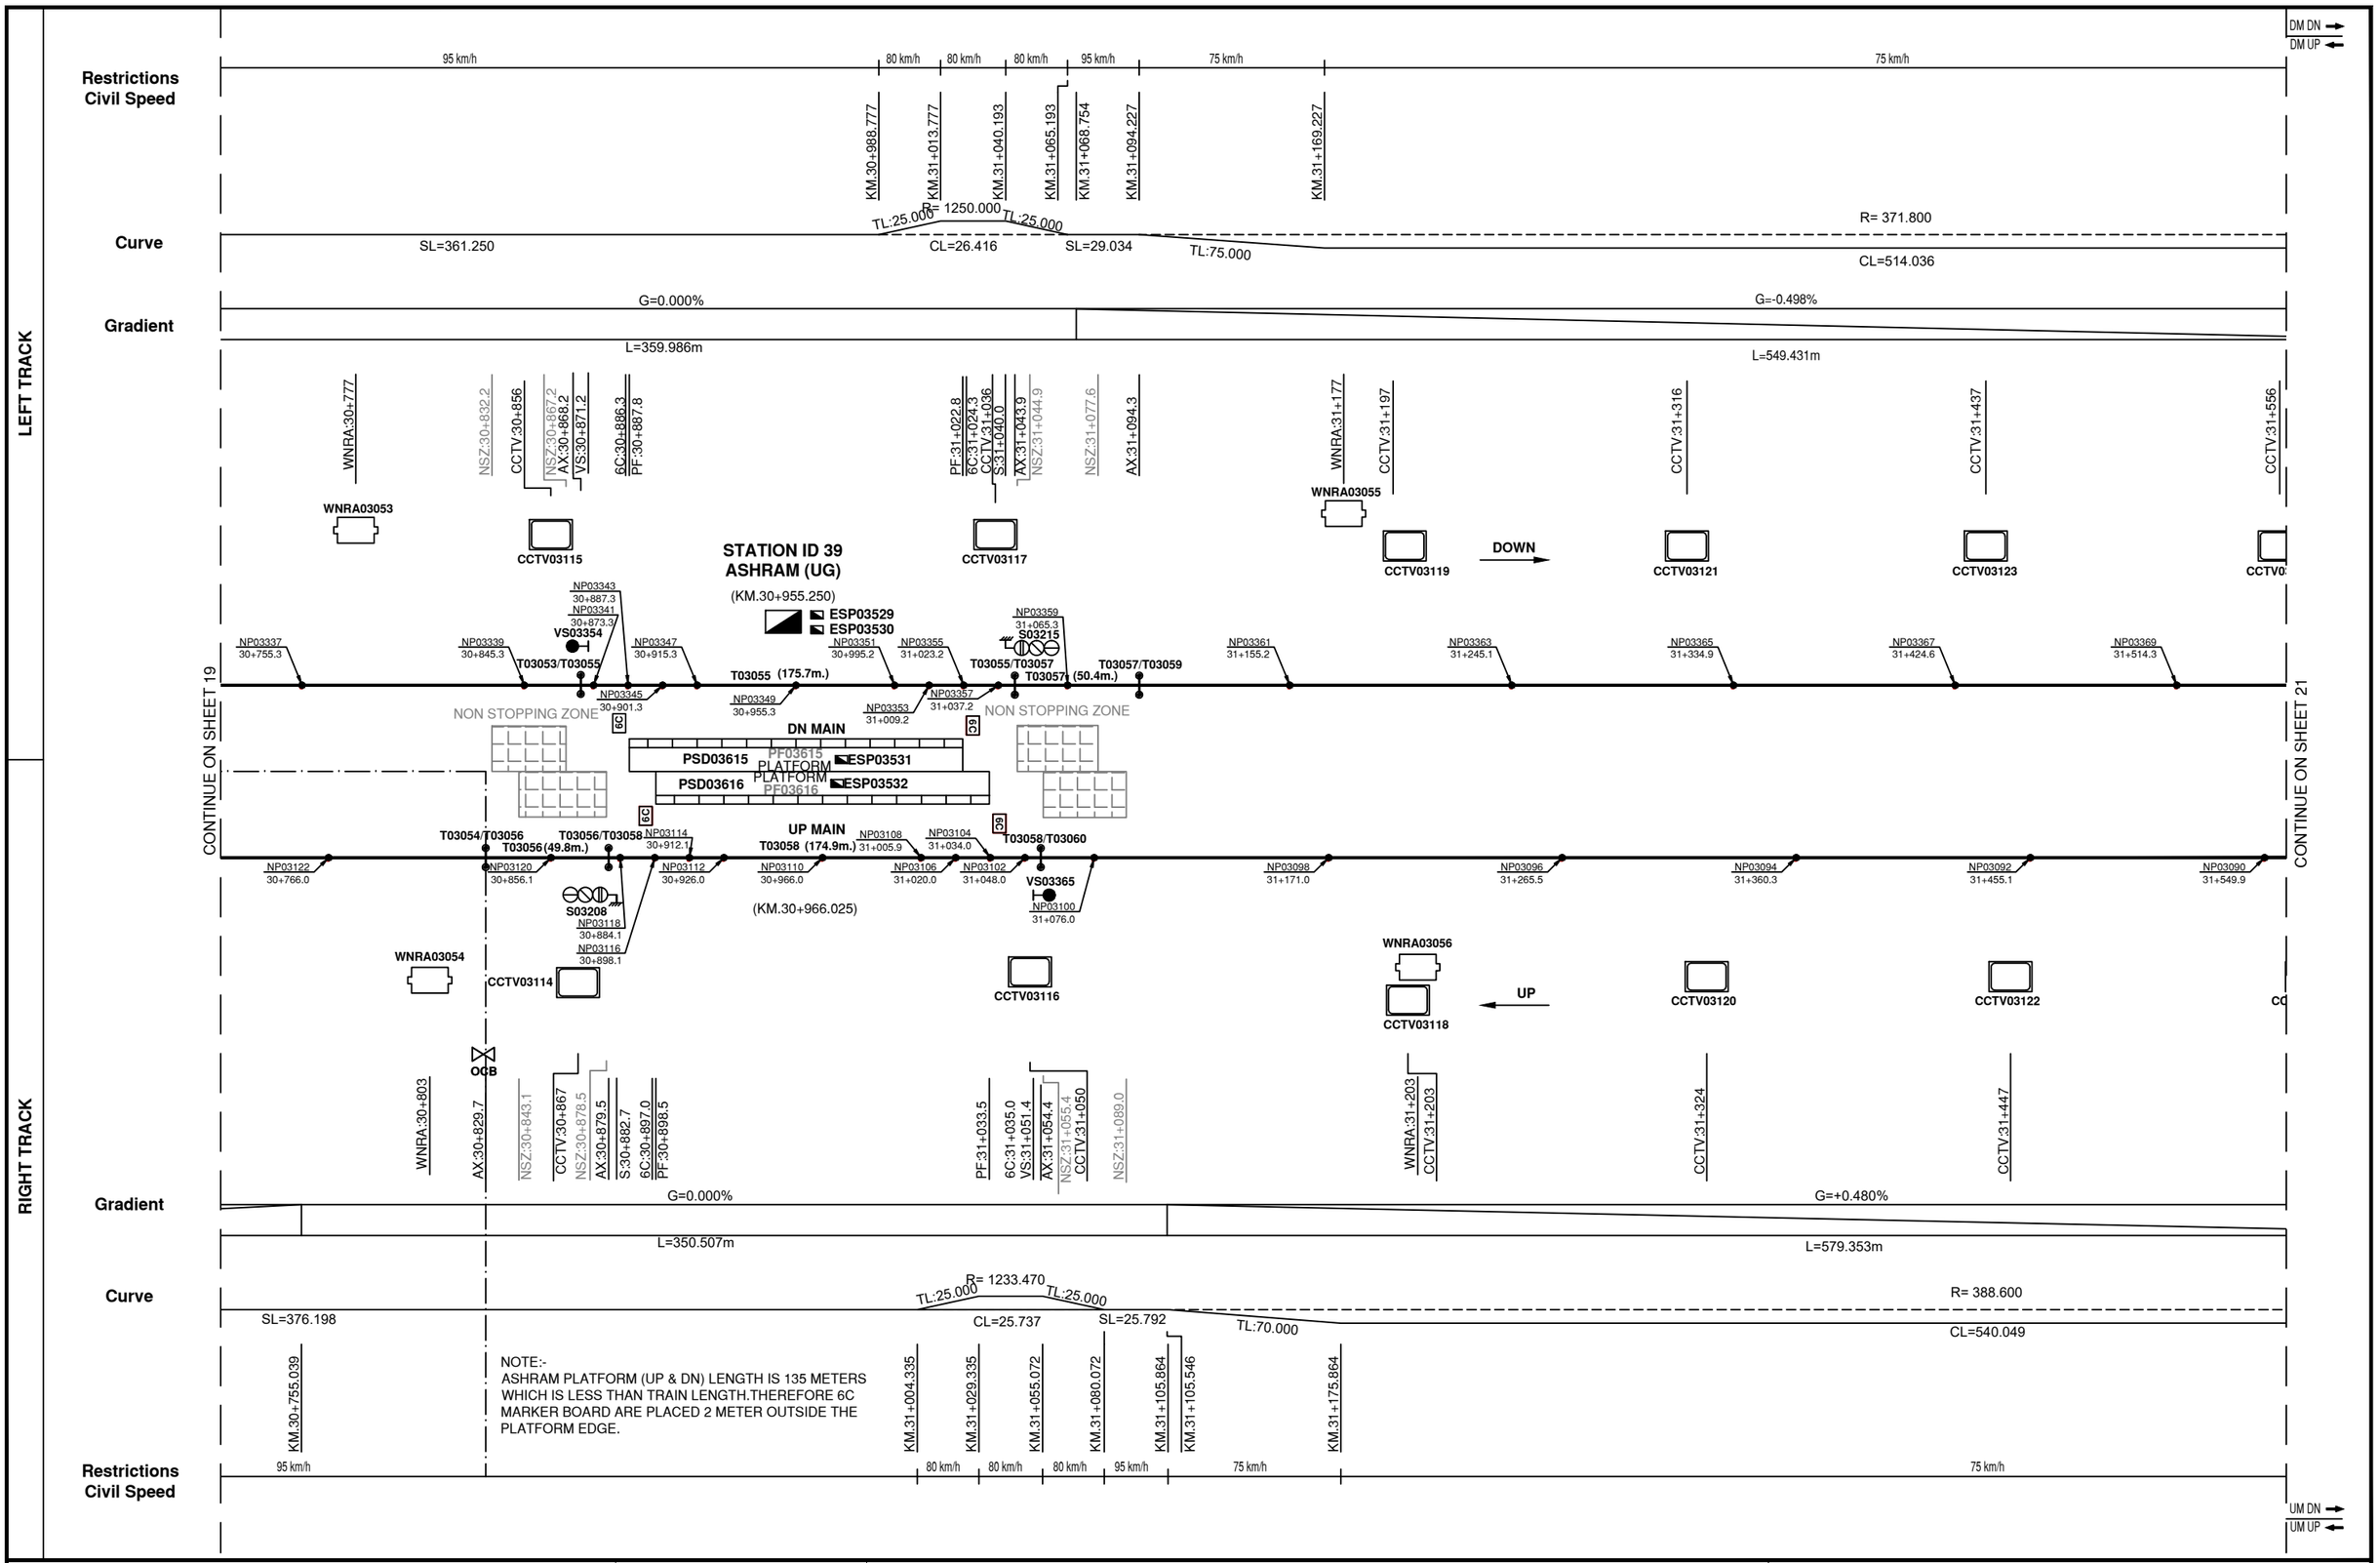

DELHI METRO RAIL CORPORATION LTD.
Metro Bhawan, Fire Brigade Lane, Barakhamba Road, New Delhi-110001

ORIGINATOR:
BOMBARDIER
the evolution of mobility

© 2019, Bombardier Inc.
All rights reserved.

AS-BUILT DRAWING

REV	DATE	DESCRIPTION
8.0	26-JUN-19	AS-BUILT DRAWING

	NAME	DATE
DESIGNED	IRSHAD A.	25-JUN-19
CHECKED	ASHOK K.	26-JUN-19
APPROVED	ROHIT T.	26-JUN-19

DRAWING TITLE:
DELHI MRTS PROJECT PHASE III LINE 7
TRAIN CONTROL & SIGNALLING SYSTEM CONTRACT CS03
TRACK AND SIGNALLING PLAN LINE 7
SIR VISHWESHWARAIAH MOTI BAGH STATION TO HAZRAT NIZAMUDDIN STATION
SECTION-DH

DRAWING No:	COST CENTRE:	SCALE	SHEET	CONT.	REV.
100241842	A PRELIMINARIES AND GENERAL REQUIREMENTS	N/S	20	21	8.0

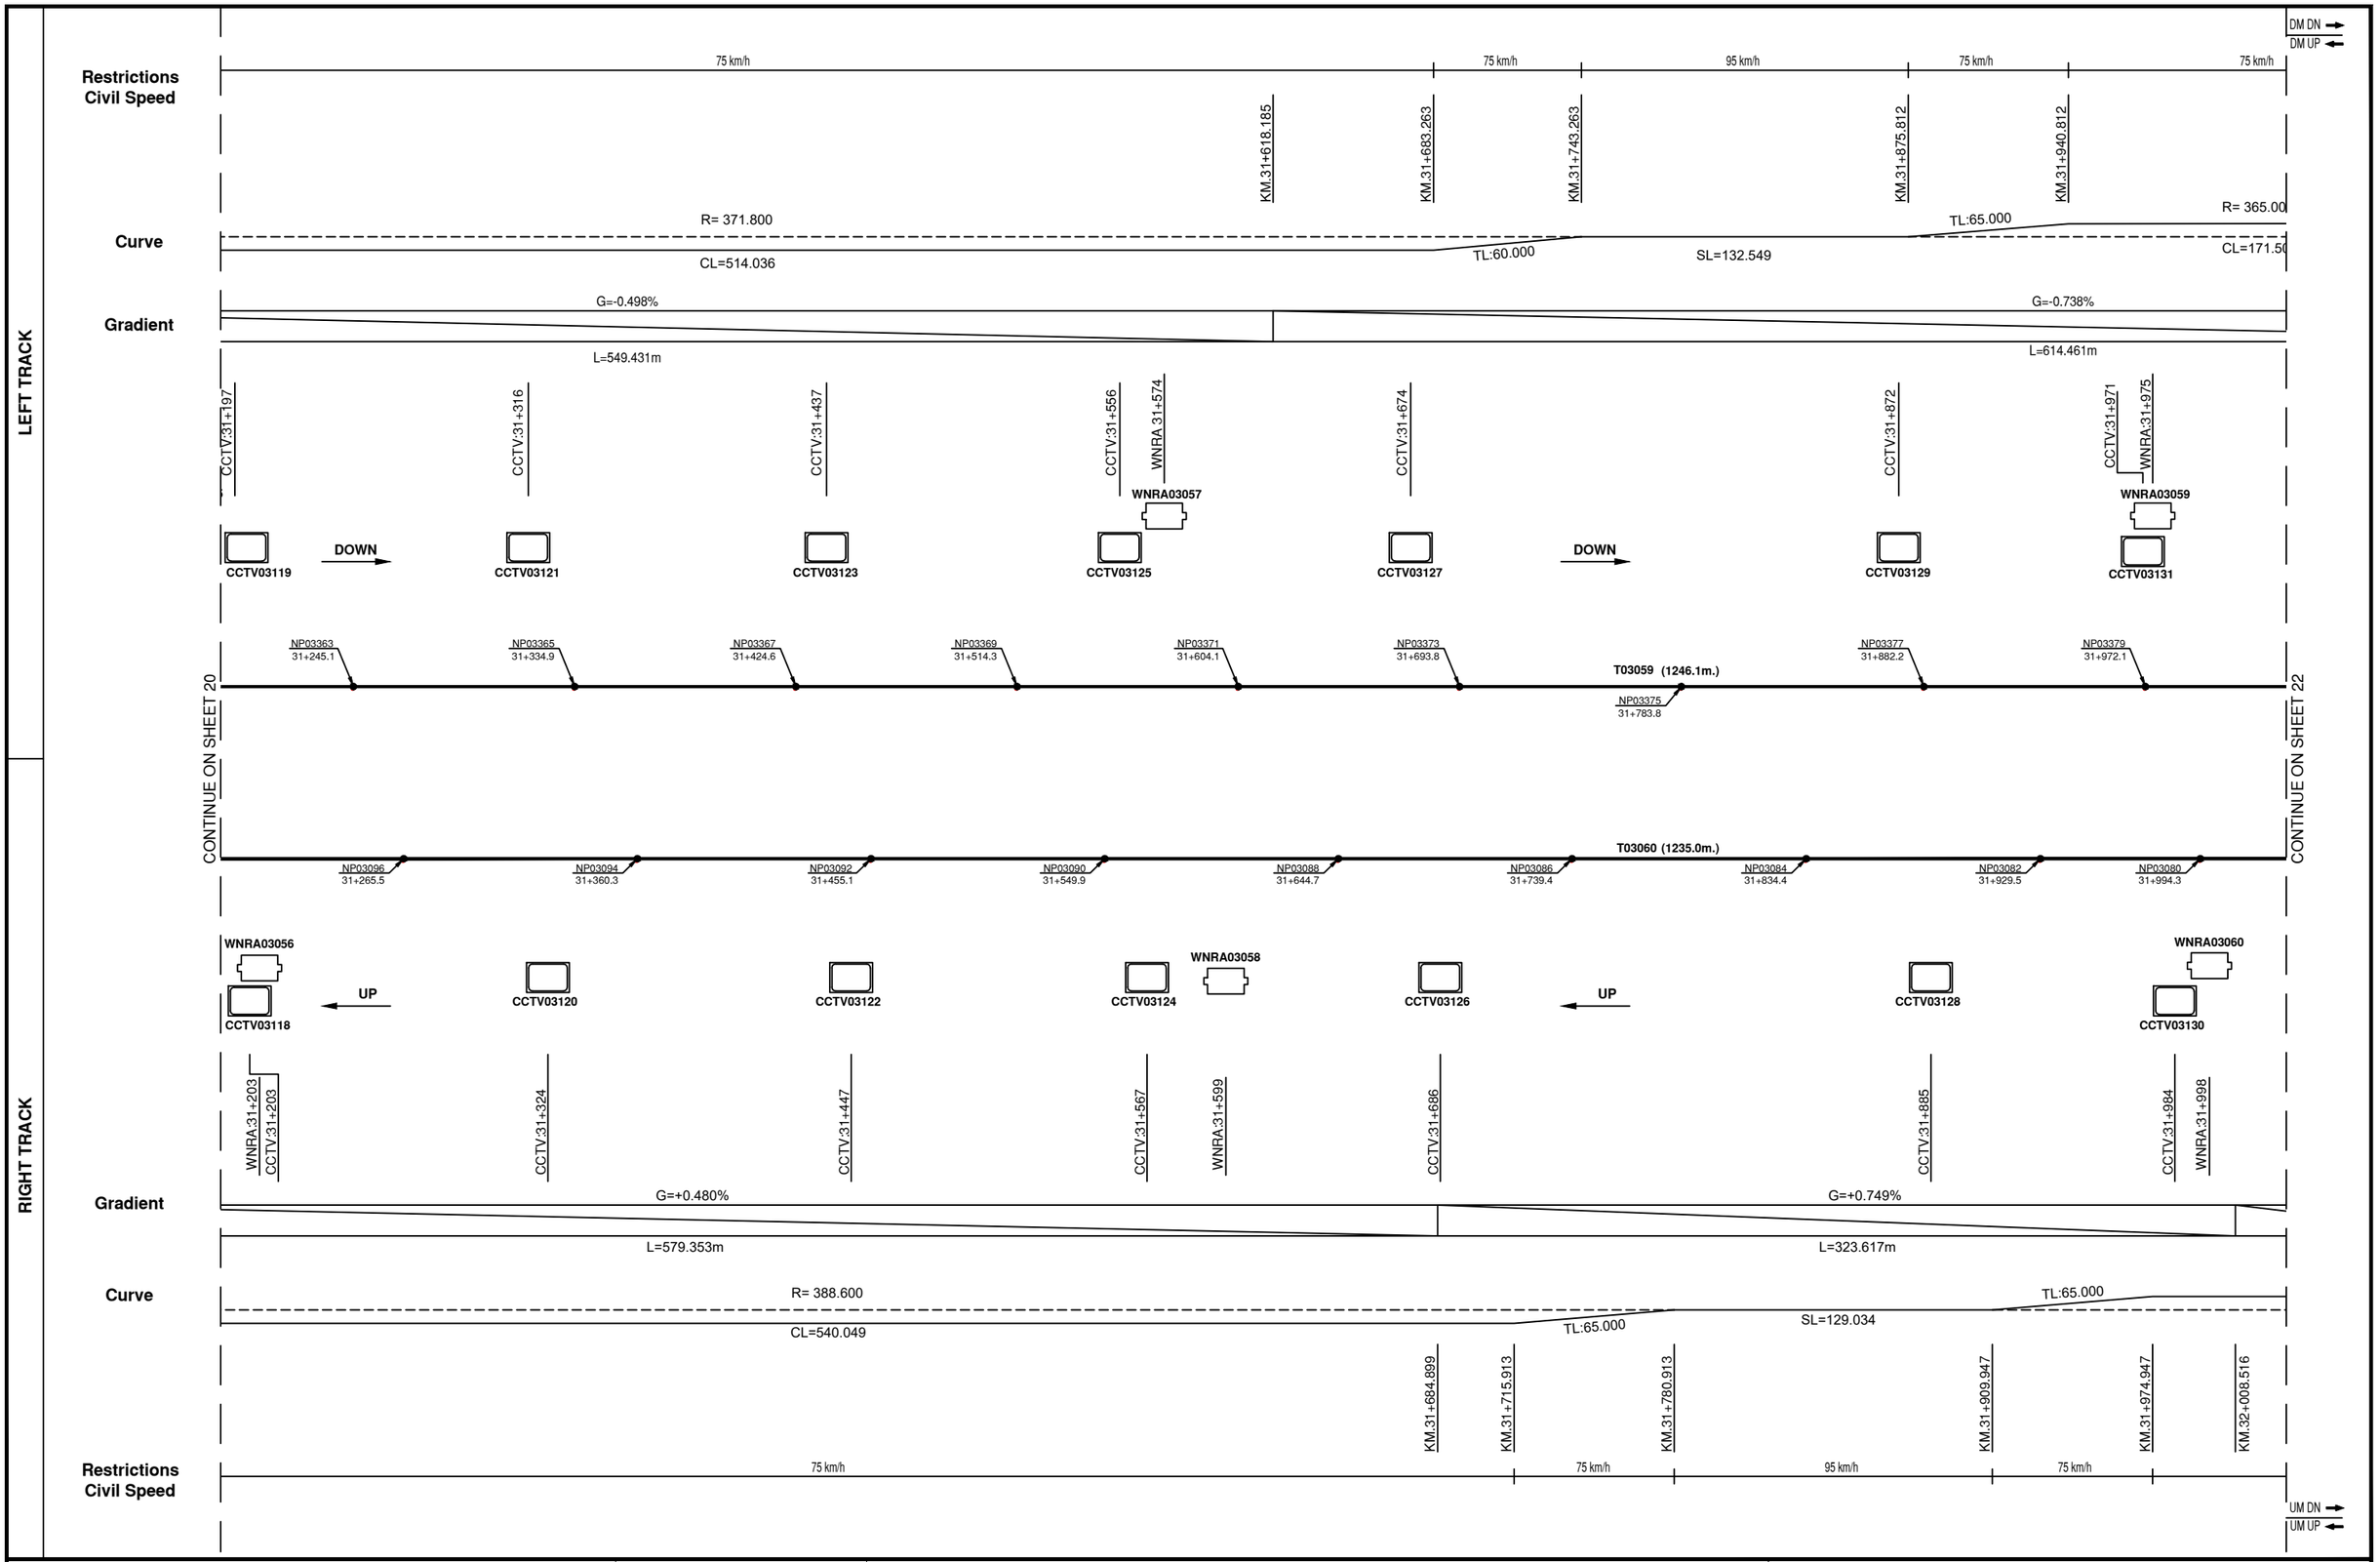

DELHI METRO RAIL CORPORATION LTD.
Metro Bhawan, Fire Brigade Lane, Barakhamba Road, New Delhi-110001

ORIGINATOR:
BOMBARDIER
the evolution of mobility

© 2019, Bombardier Inc.
All rights reserved.

AS-BUILT DRAWING

REV	DATE	DESCRIPTION
8.0	26-JUN-19	AS-BUILT DRAWING

	NAME	DATE
DESIGNED	IRSHAD A.	25-JUN-19
CHECKED	ASHOK K.	26-JUN-19
APPROVED	ROHIT T.	26-JUN-19

DRAWING TITLE:
DELHI MRTS PROJECT PHASE III LINE 7
TRAIN CONTROL & SIGNALLING SYSTEM CONTRACT CS03
TRACK AND SIGNALLING PLAN LINE 7
SIR VISHWESHWARAIAH MOTI BAGH STATION TO HAZRAT NIZAMUDDIN STATION
SECTION-DH

DRAWING No:	COST CENTRE:	SCALE	SHEET	CONT.	REV.
100241842	A PRELIMINARIES AND GENERAL REQUIREMENTS	N/S	21	22	8.0

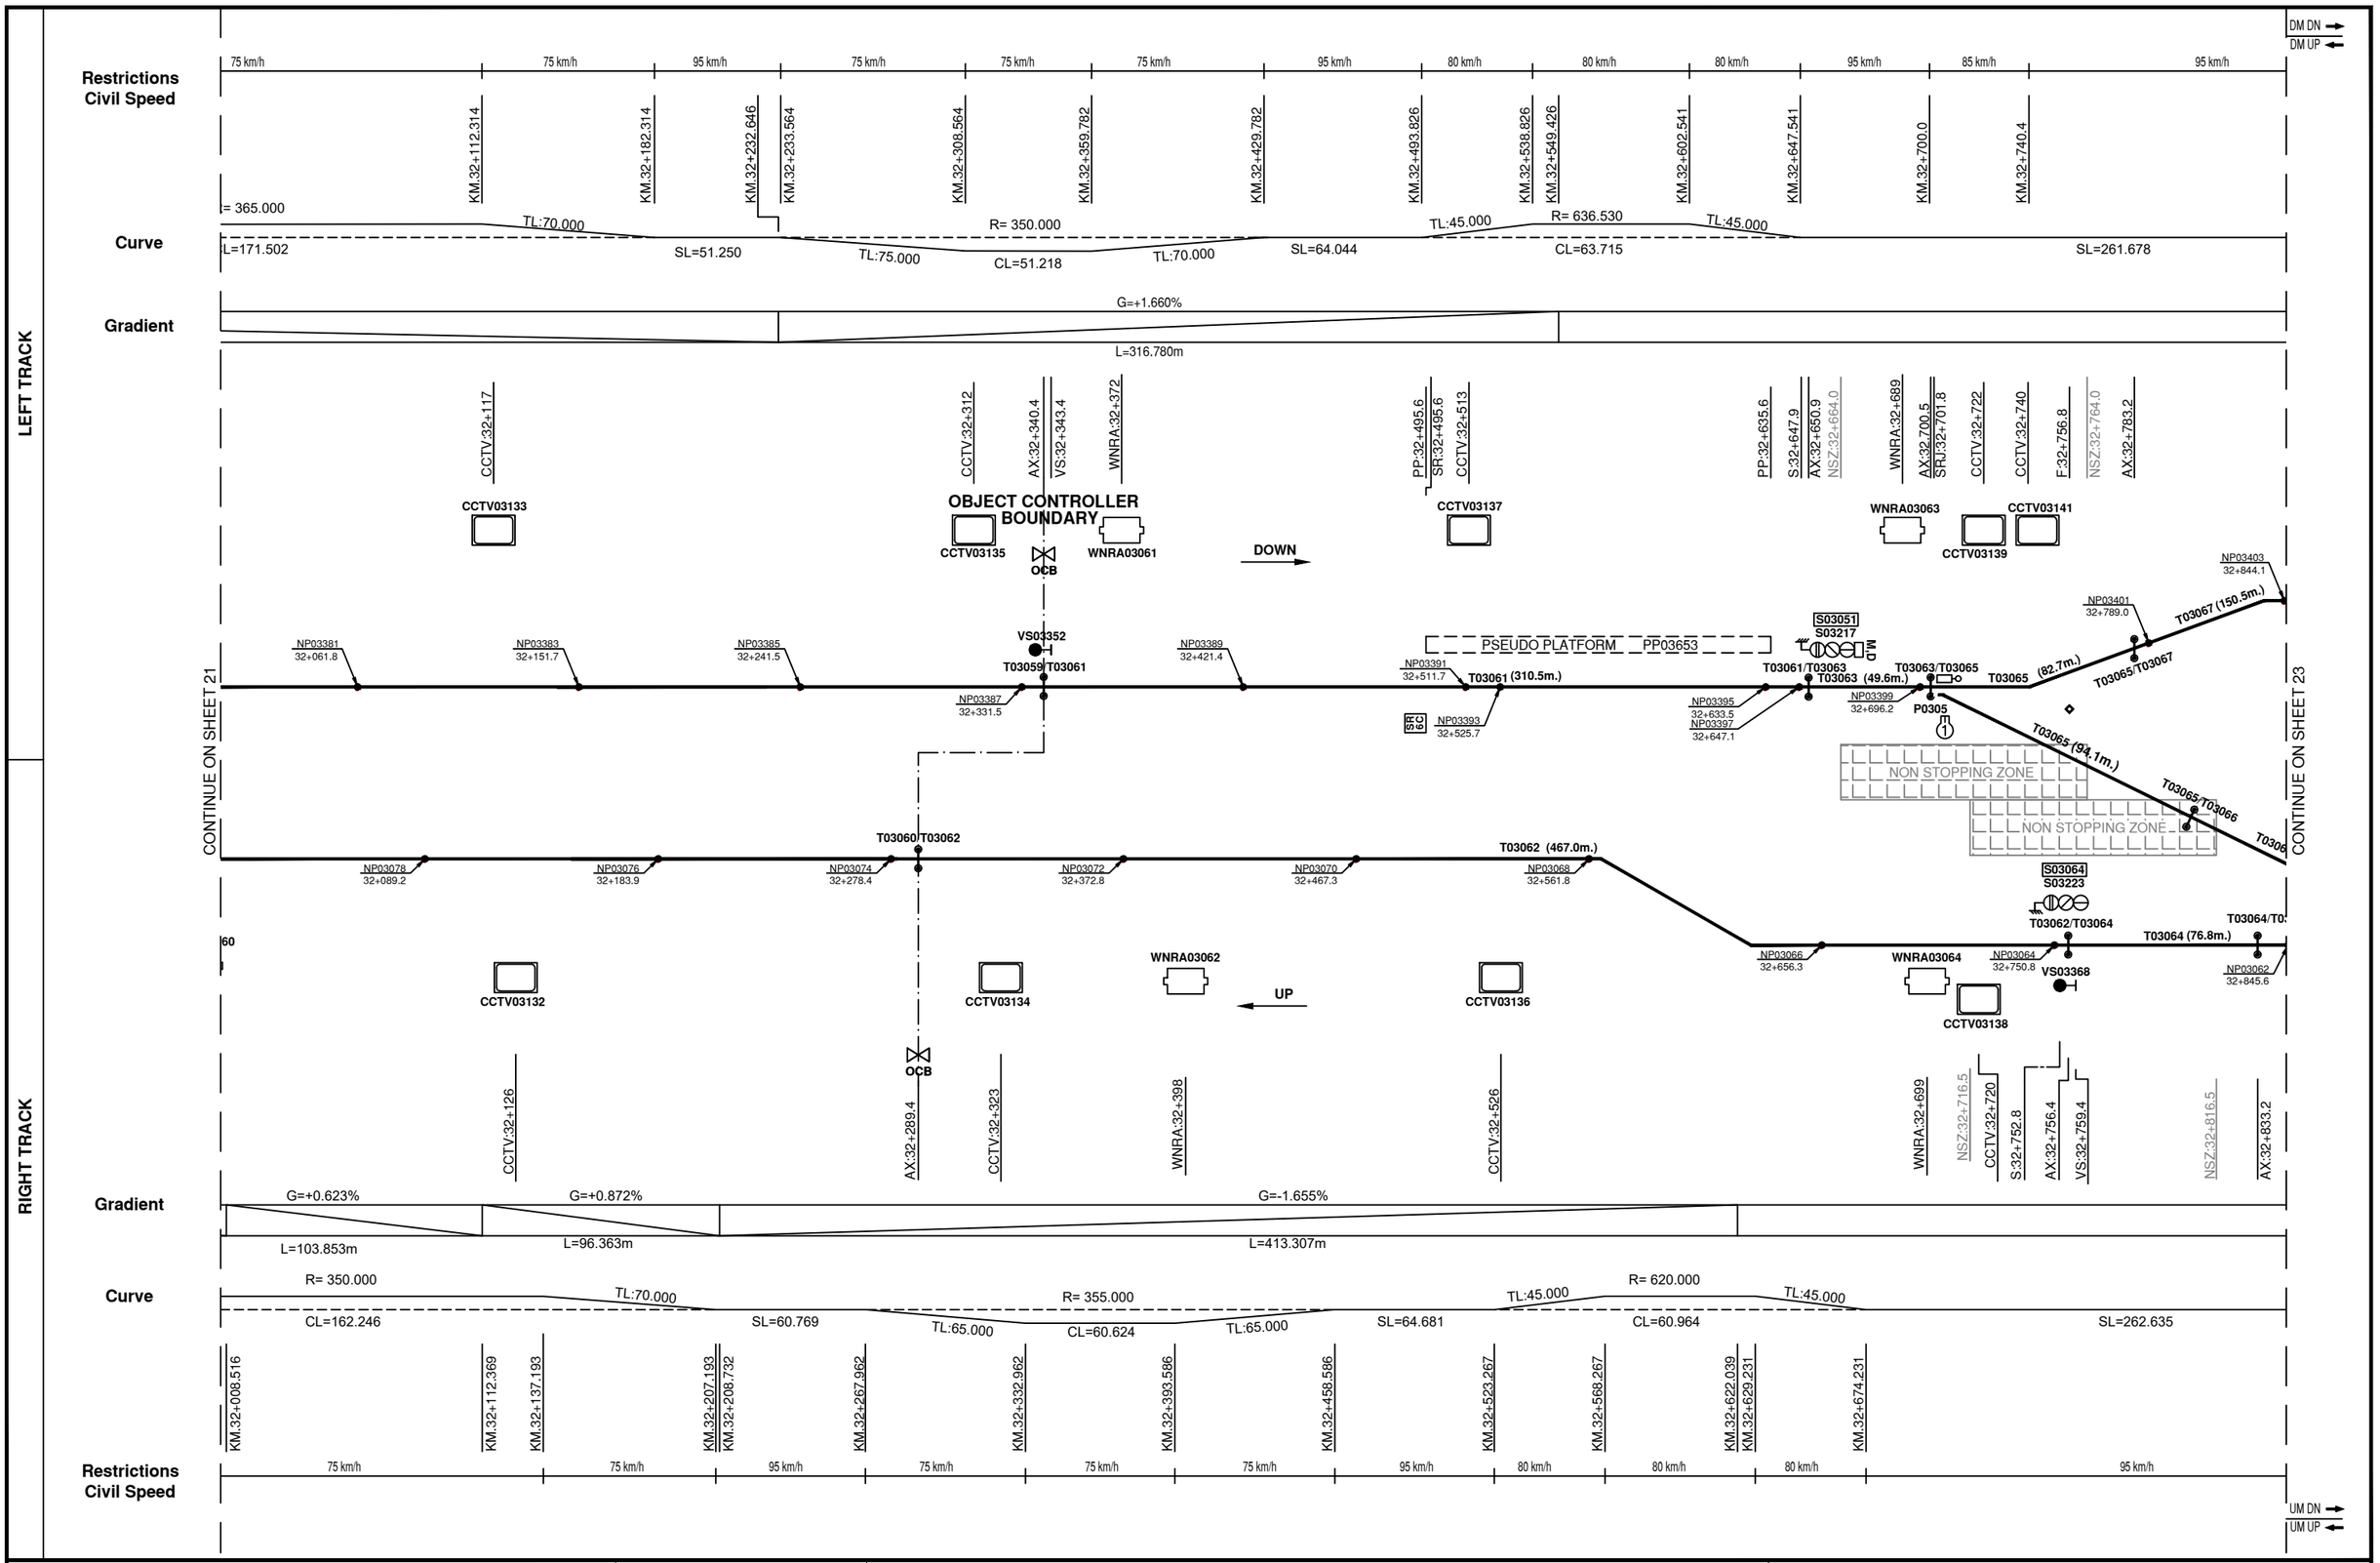

DELHI METRO RAIL CORPORATION LTD.
Metro Bhawan, Fire Brigade Lane, Barakhamba Road, New Delhi-110001

ORIGINATOR:
BOMBARDIER
the evolution of mobility

© 2019, Bombardier Inc. All rights reserved.

AS-BUILT DRAWING

REV	DATE	DESCRIPTION
8.0	26-JUN-19	AS-BUILT DRAWING

	NAME	DATE
DESIGNED	IRSHAD A.	25-JUN-19
CHECKED	ASHOK K.	26-JUN-19
APPROVED	ROHIT T.	26-JUN-19

DRAWING TITLE: DELHI MRTS PROJECT PHASE III LINE 7
TRAIN CONTROL & SIGNALLING SYSTEM CONTRACT CS03
TRACK AND SIGNALLING PLAN LINE 7
SIR VISHWESHWARAIAH MOTI BAGH STATION TO HAZRAT NIZAMUDDIN STATION
SECTION-DH

DRAWING No:	COST CENTRE:	SCALE	SHEET	CONT.	REV.
100241842	A PRELIMINARIES AND GENERAL REQUIREMENTS	N/S	22	23	8.0

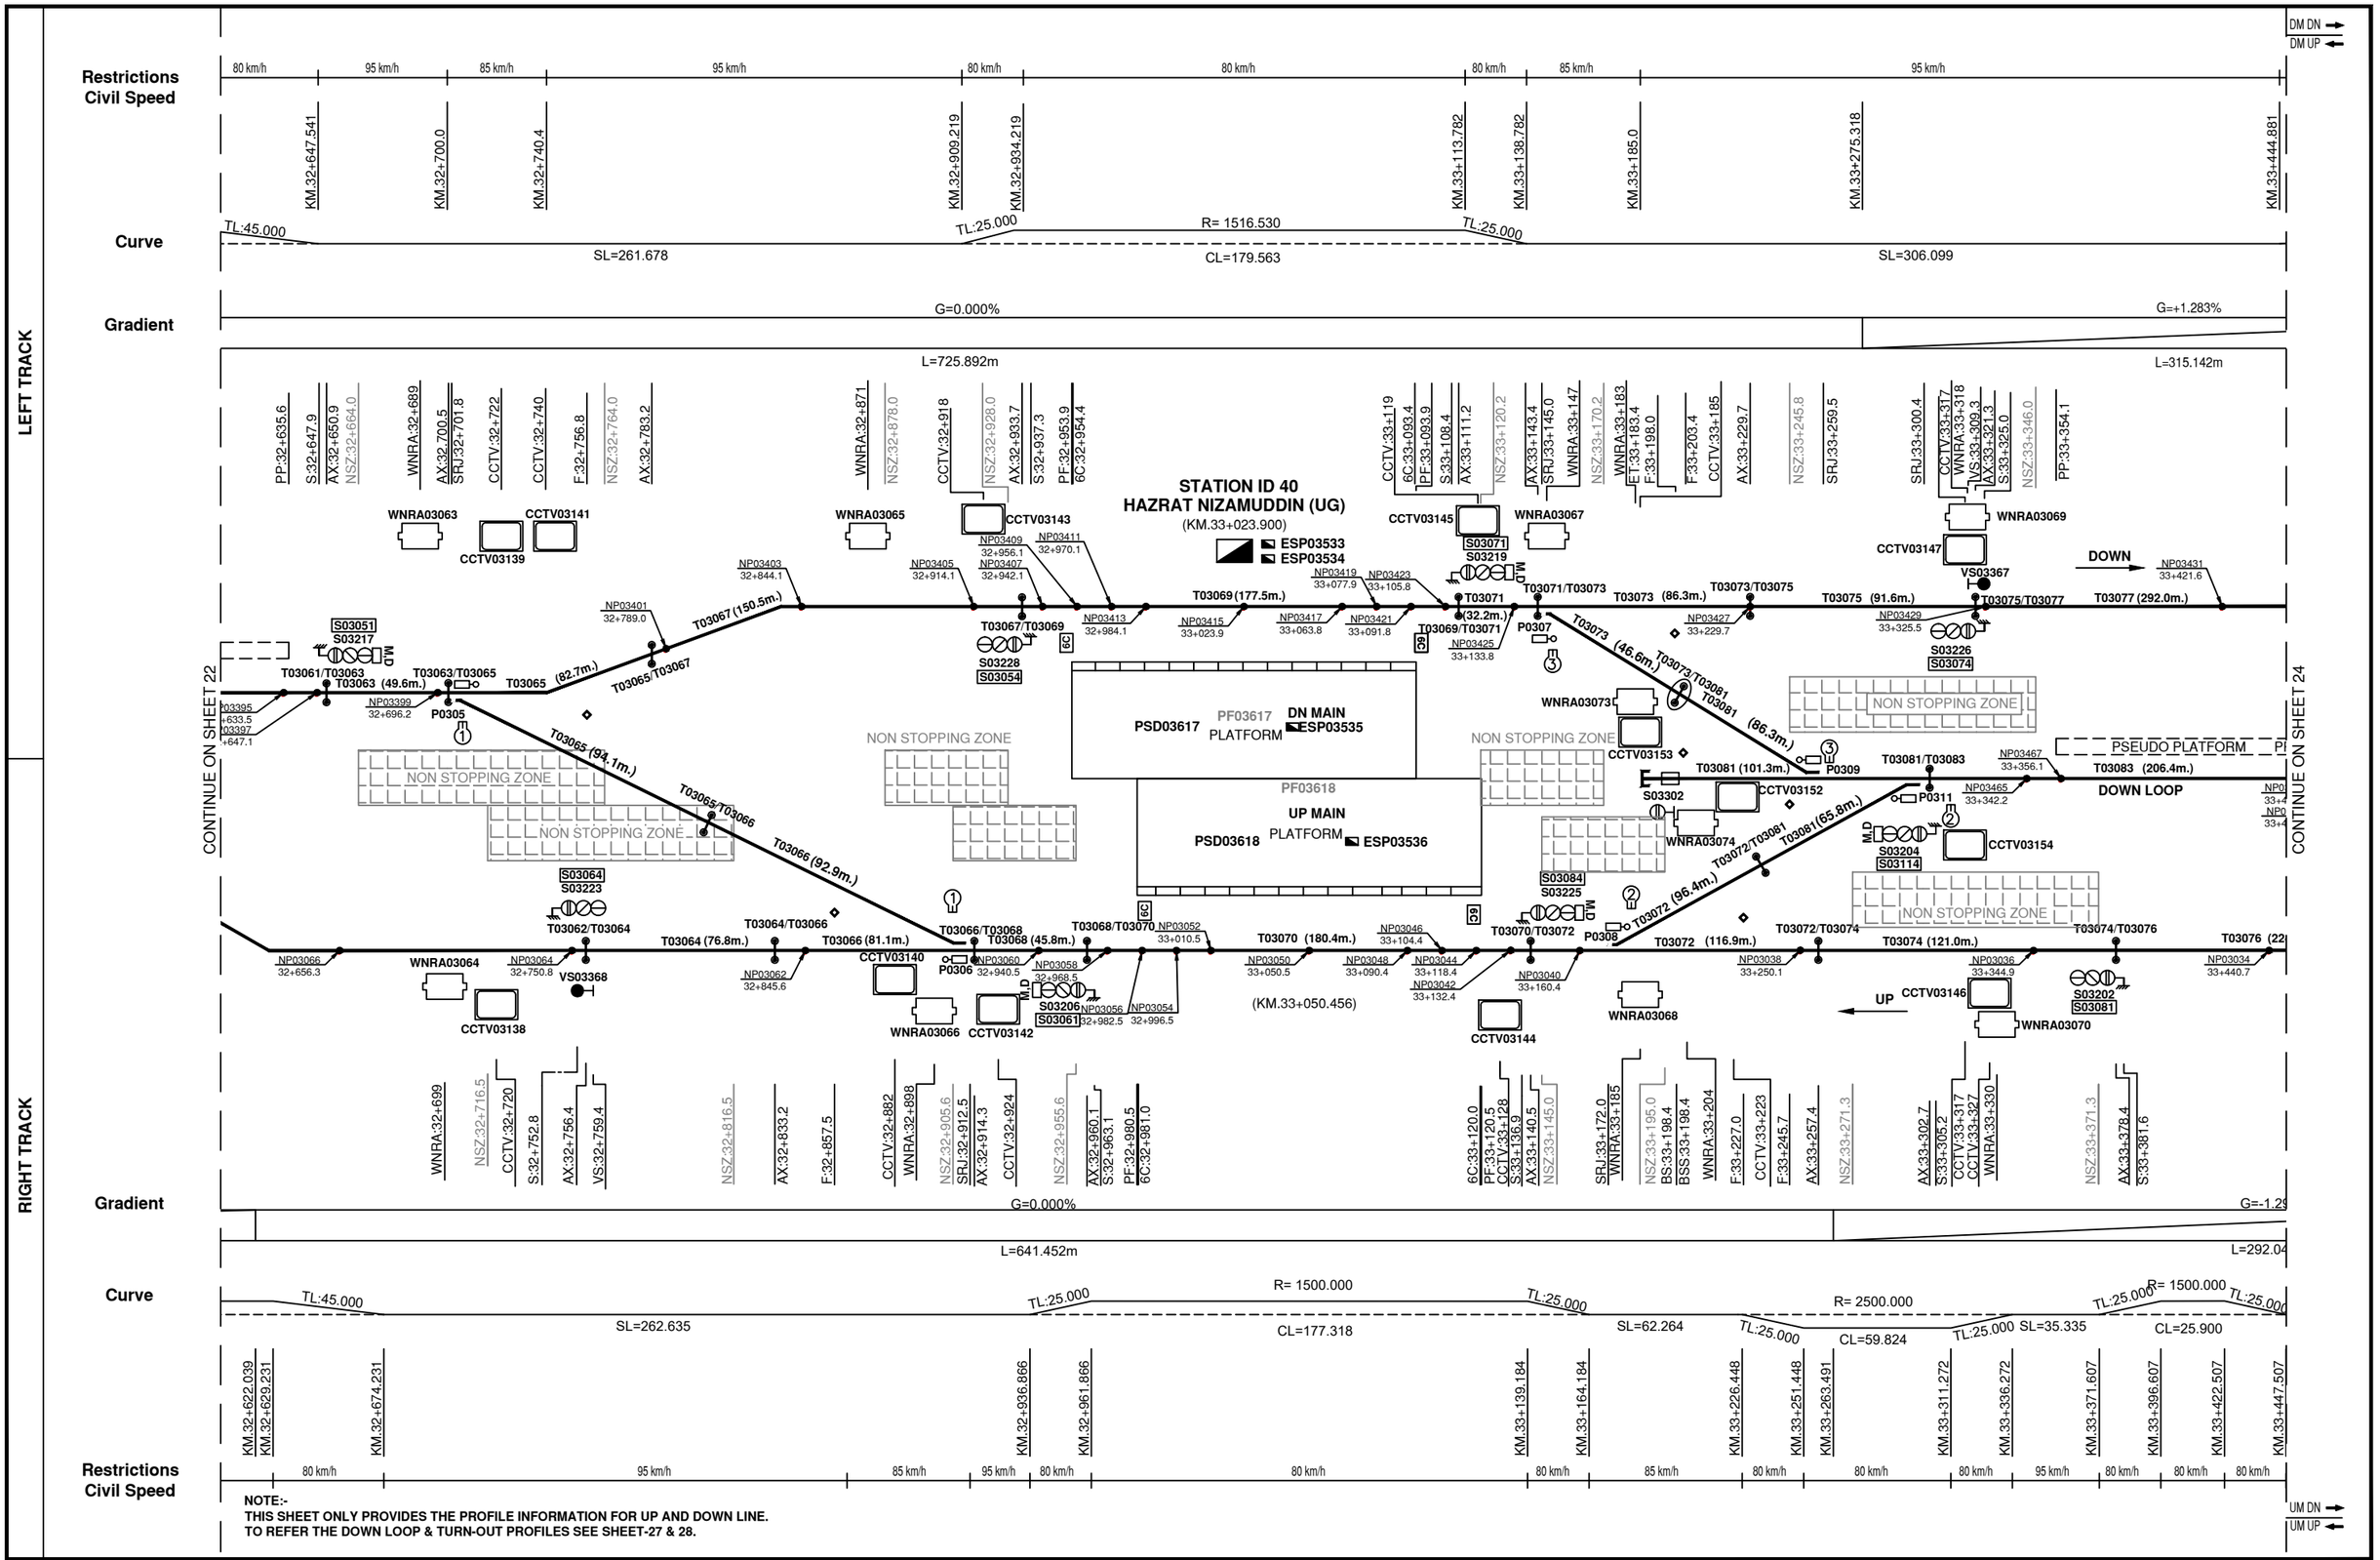

NOTE:-
THIS SHEET ONLY PROVIDES THE PROFILE INFORMATION FOR UP AND DOWN LINE.
TO REFER THE DOWN LOOP & TURN-OUT PROFILES SEE SHEET-27 & 28.

DELHI METRO RAIL CORPORATION LTD.
Metro Bhawan, Fire Brigade Lane, Barakhamba Road, New Delhi-110001

ORIGINATOR:
BOMBARDIER
the evolution of mobility

© 2019, Bombardier Inc.
All rights reserved.

AS-BUILT DRAWING

REV	DATE	DESCRIPTION
8.0	26-JUN-19	AS-BUILT DRAWING

	NAME	DATE
DESIGNED	IRSHAD A.	25-JUN-19
CHECKED	ASHOK K.	26-JUN-19
APPROVED	ROHIT T.	26-JUN-19

DRAWING TITLE:
DELHI MRTS PROJECT PHASE III LINE 7
TRAIN CONTROL & SIGNALLING SYSTEM CONTRACT CS03
TRACK AND SIGNALLING PLAN LINE 7
SIR VISHWESHWARAIAH MOTI BAGH STATION TO HAZRAT NIZAMUDDIN STATION
SECTION-DH

DRAWING No:	COST CENTRE:	SCALE	SHEET	CONT.	REV.
100241842	A PRELIMINARIES AND GENERAL REQUIREMENTS	N/S	23	24	8.0

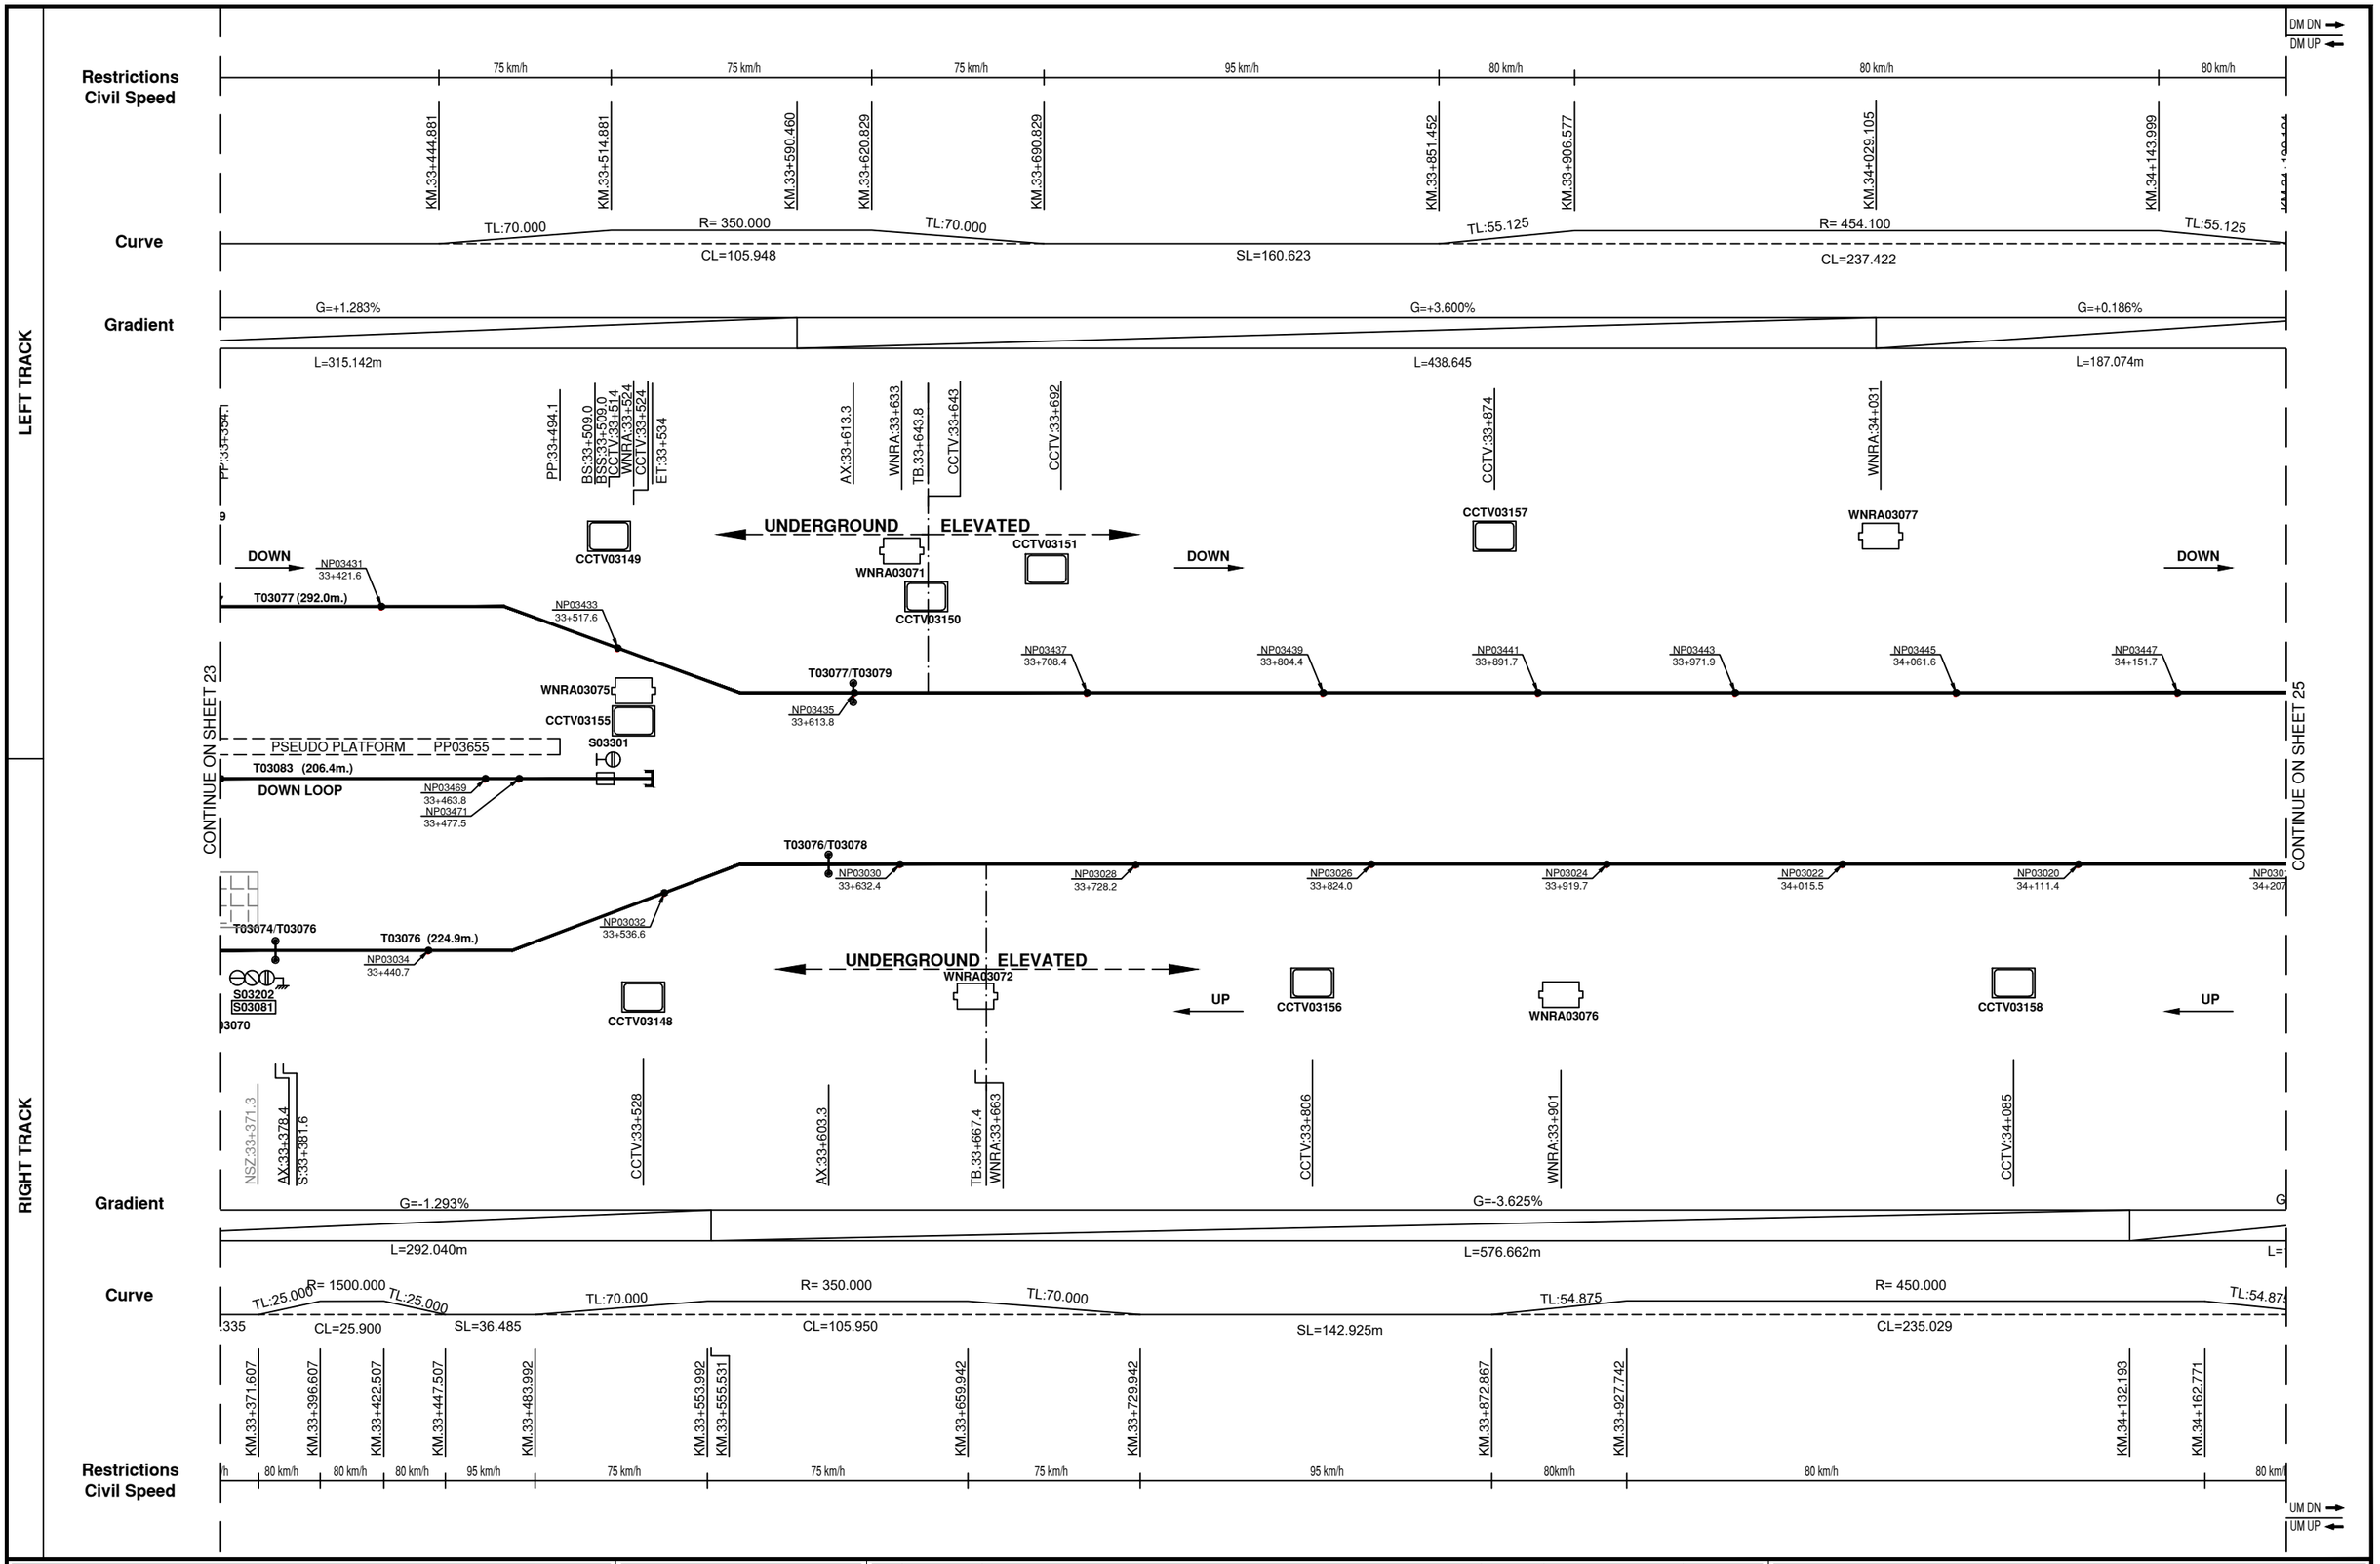

DELHI METRO RAIL CORPORATION LTD.
Metro Bhawan, Fire Brigade Lane, Barakhamba Road, New Delhi-110001

ORIGINATOR:
BOMBARDIER
the evolution of mobility

© 2019, Bombardier Inc.
All rights reserved.

AS-BUILT DRAWING

REV	DATE	DESCRIPTION
8.0	26-JUN-19	AS-BUILT DRAWING

	NAME	DATE
DESIGNED	IRSHAD A.	25-JUN-19
CHECKED	ASHOK K.	26-JUN-19
APPROVED	ROHIT T.	26-JUN-19

DRAWING TITLE: DELHI MRTS PROJECT PHASE III LINE 7
TRAIN CONTROL & SIGNALLING SYSTEM CONTRACT CS03
TRACK AND SIGNALLING PLAN LINE 7
SIR VISHWESHWARAIAH MOTI BAGH STATION TO HAZRAT NIZAMUDDIN STATION
SECTION-DH

DRAWING No:	COST CENTRE:	SCALE	SHEET	CONT.	REV.
100241842	A PRELIMINARIES AND GENERAL REQUIREMENTS	N/S	24	25	8.0

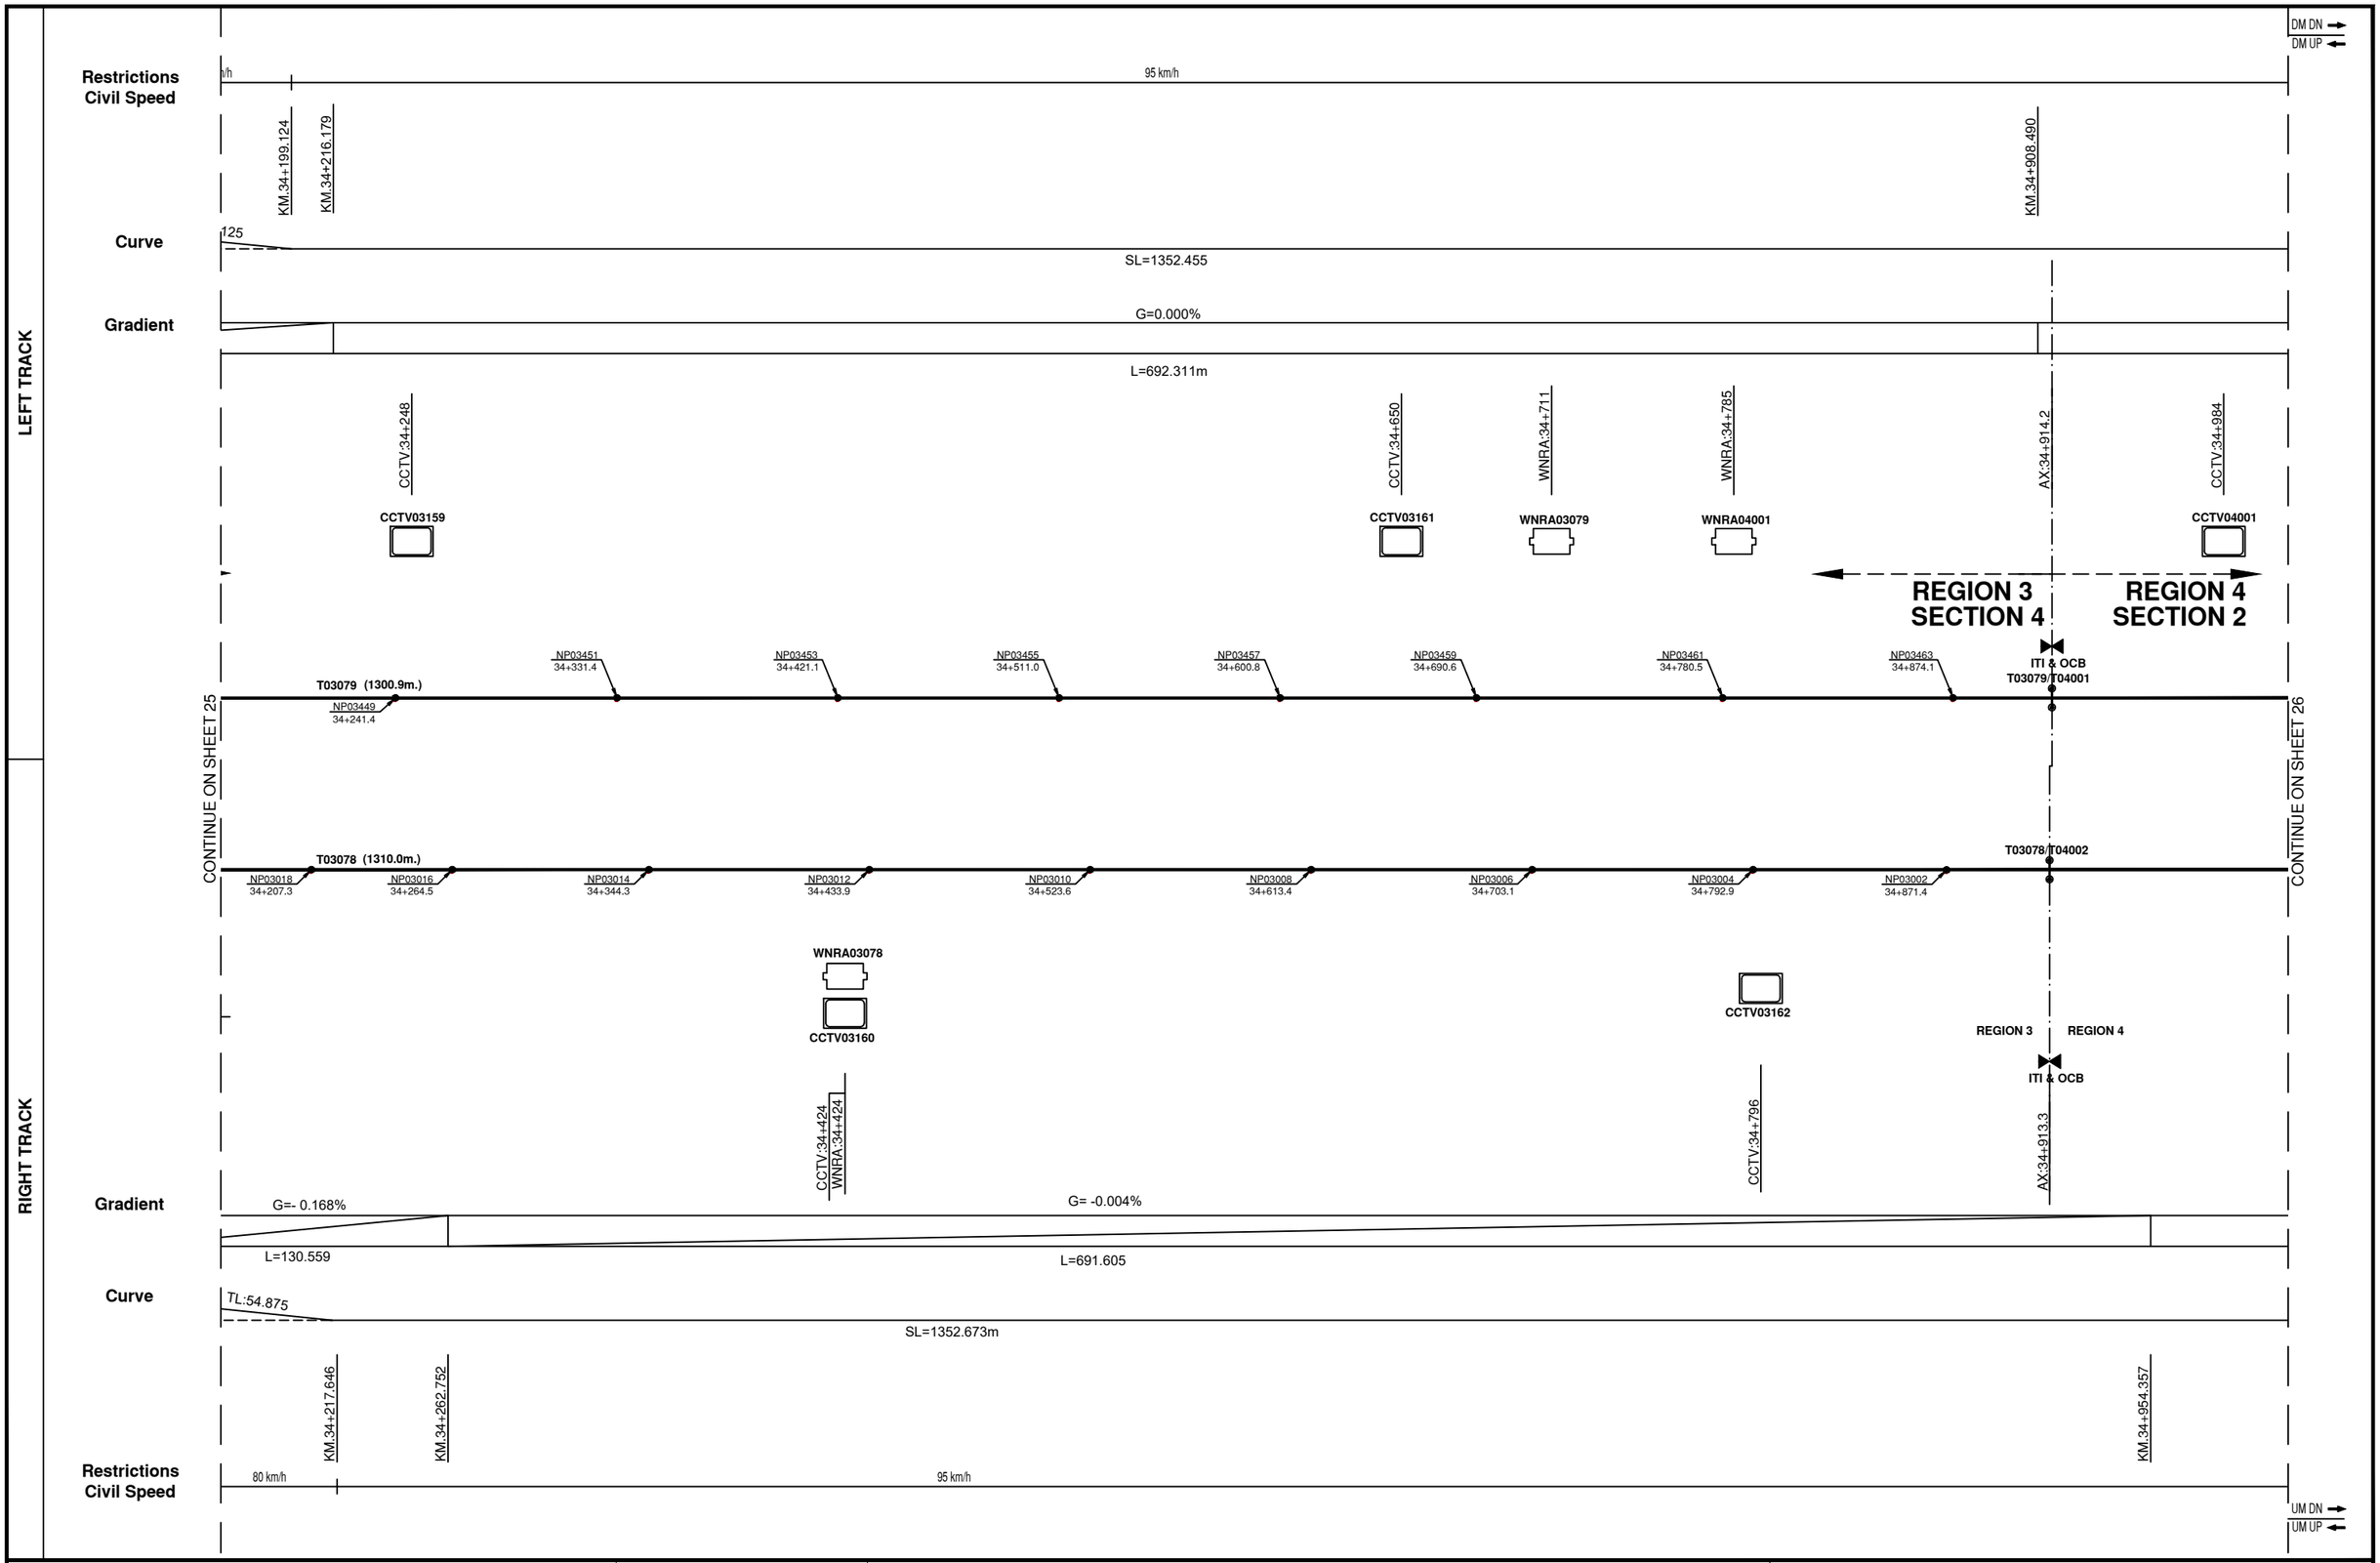

DELHI METRO RAIL CORPORATION LTD.
Metro Bhawan, Fire Brigade Lane, Barakhamba Road, New Delhi-110001

ORIGINATOR:
BOMBARDIER
the evolution of mobility

© 2019, Bombardier Inc.
All rights reserved.

AS-BUILT DRAWING

REV	DATE	DESCRIPTION
8.0	26-JUN-19	AS-BUILT DRAWING

	NAME	DATE
DESIGNED	IRSHAD A.	25-JUN-19
CHECKED	ASHOK K.	26-JUN-19
APPROVED	ROHIT T.	26-JUN-19

DRAWING TITLE:
DELHI MRTS PROJECT PHASE III LINE 7
TRAIN CONTROL & SIGNALLING SYSTEM CONTRACT CS03
TRACK AND SIGNALLING PLAN LINE 7
SIR VISHWESHWARAIAH MOTI BAGH STATION TO HAZRAT NIZAMUDDIN STATION
SECTION-DH

DRAWING No:	COST CENTRE:	SCALE	SHEET	CONT.	REV.
100241842	A PRELIMINARIES AND GENERAL REQUIREMENTS	N/S	25	26	8.0

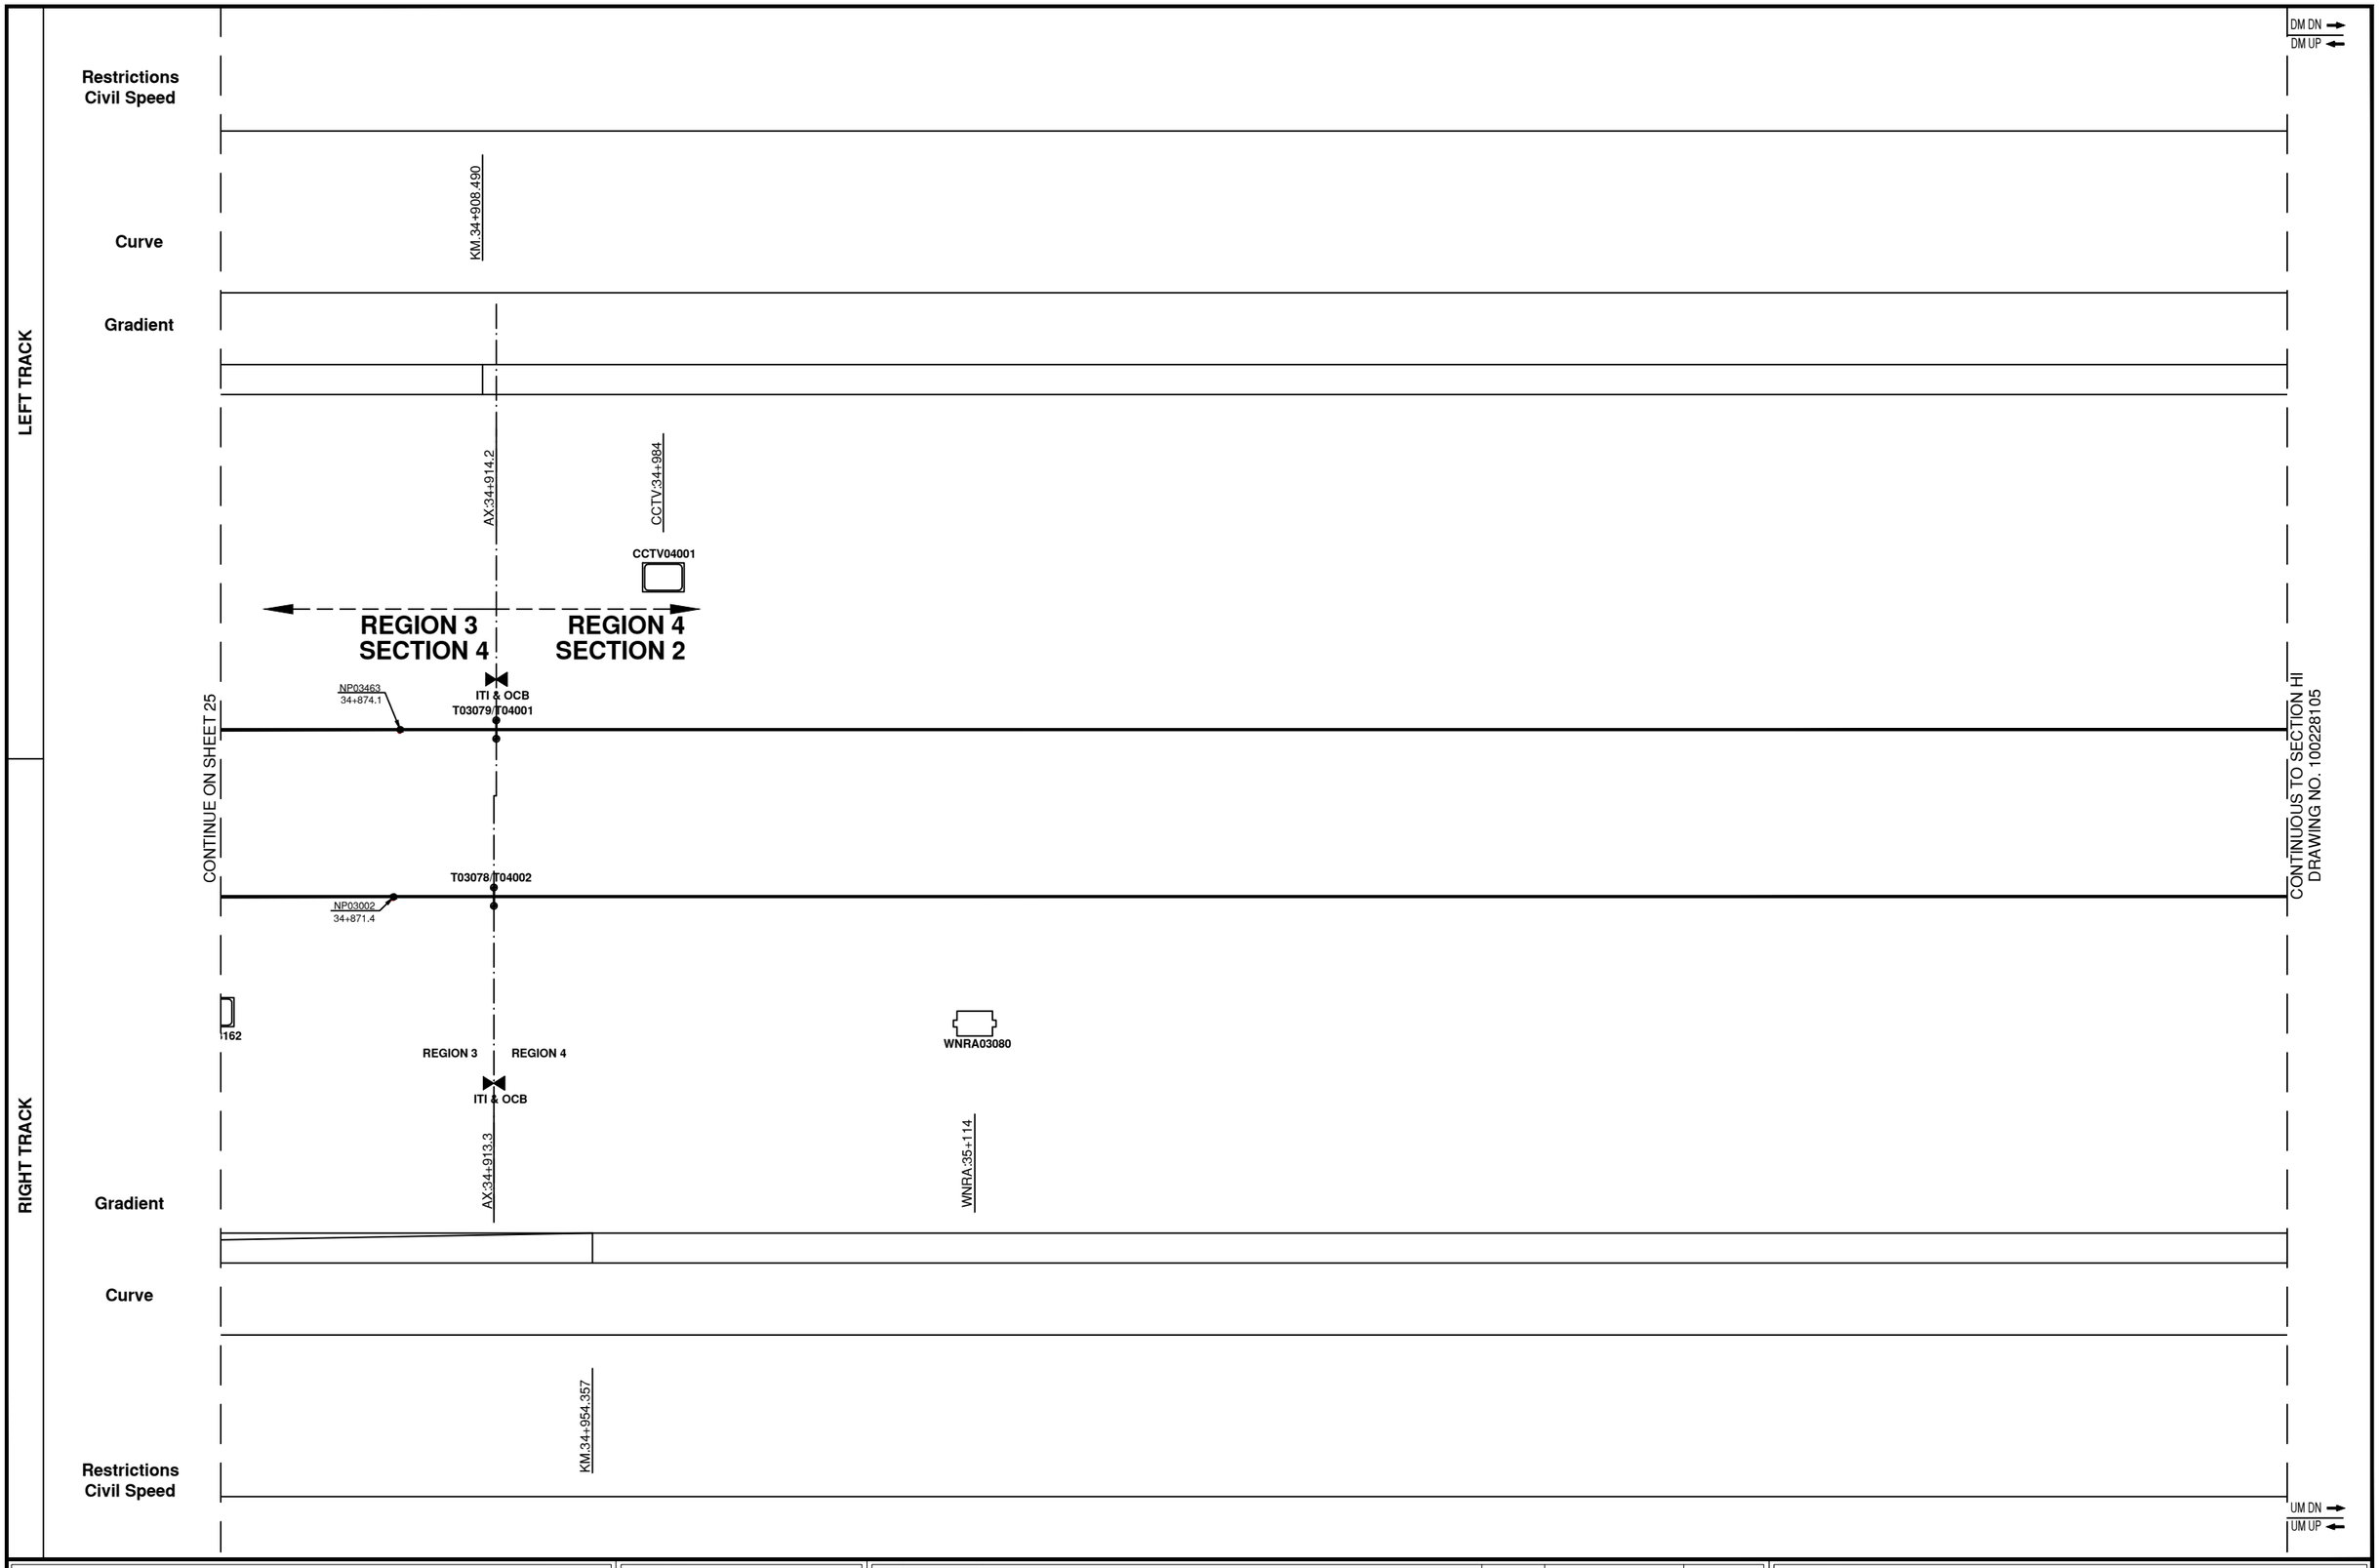

DELHI METRO RAIL CORPORATION LTD.
Metro Bhawan, Fire Brigade Lane, Barakhamba Road, New Delhi-110001

ORIGINATOR:
BOMBARDIER
the evolution of mobility

© 2019, Bombardier Inc.
All rights reserved.

AS-BUILT DRAWING

REV	DATE	DESCRIPTION
8.0	26-JUN-19	AS-BUILT DRAWING

	NAME	DATE
DESIGNED	IRSHAD A.	25-JUN-19
CHECKED	ASHOK K.	26-JUN-19
APPROVED	ROHIT T.	26-JUN-19

DRAWING TITLE: DELHI MRTS PROJECT PHASE III LINE 7
TRAIN CONTROL & SIGNALLING SYSTEM CONTRACT CS03
TRACK AND SIGNALLING PLAN LINE 7
SIR VISHWESHWARAIAH MOTI BAGH STATION TO HAZRAT NIZAMUDDIN STATION
SECTION-DH

DRAWING No:	COST CENTRE:	SCALE	SHEET	CONT.	REV.
100241842	A PRELIMINARIES AND GENERAL REQUIREMENTS	N/S	26	27	8.0

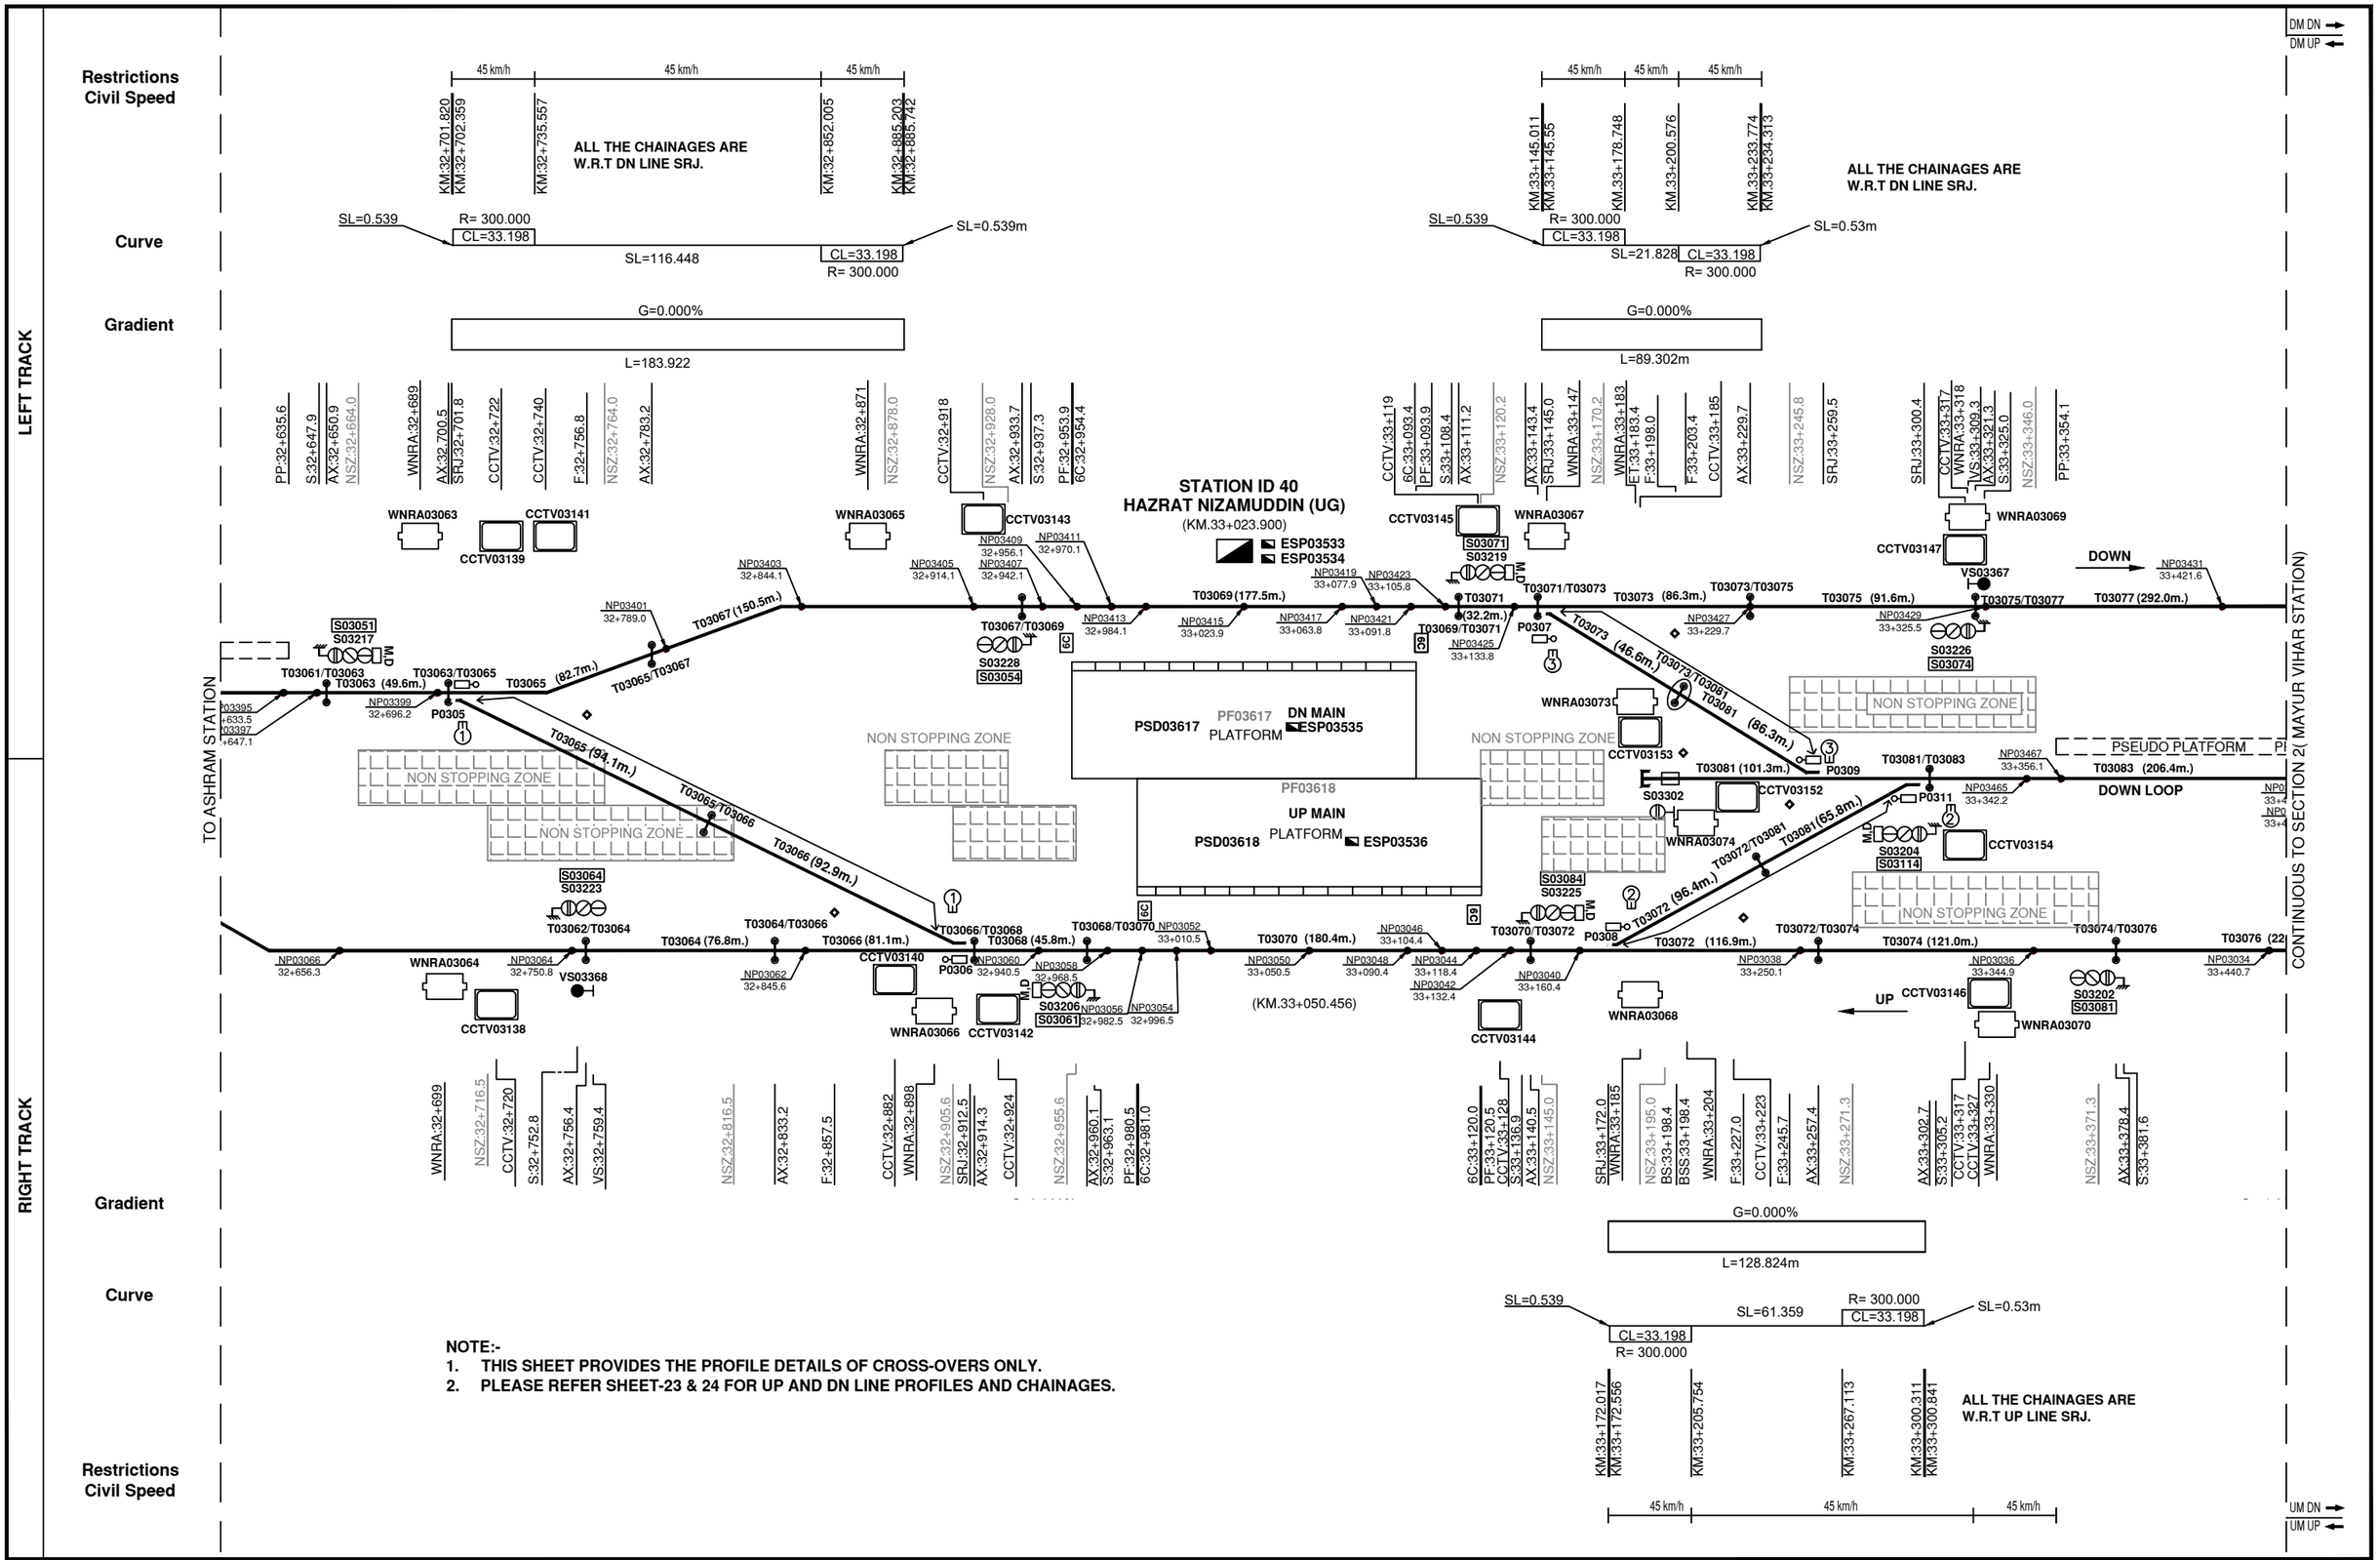

NOTE:-

1. THIS SHEET PROVIDES THE PROFILE DETAILS OF CROSS-OVERS ONLY.
2. PLEASE REFER SHEET-23 & 24 FOR UP AND DN LINE PROFILES AND CHAINAGES.

DELHI METRO RAIL CORPORATION LTD.
Metro Bhawan, Fire Brigade Lane, Barakhamba Road, New Delhi-110001

ORIGINATOR:
BOMBARDIER
the evolution of mobility

© 2019, Bombardier Inc. All rights reserved.

AS-BUILT DRAWING

REV	DATE	DESCRIPTION
8.0	26-JUN-19	AS-BUILT DRAWING

	NAME	DATE
DESIGNED	IRSHAD A.	25-JUN-19
CHECKED	ASHOK K.	26-JUN-19
APPROVED	ROHIT T.	26-JUN-19

DRAWING TITLE:
DELHI MRTS PROJECT PHASE III LINE 7
TRAIN CONTROL & SIGNALLING SYSTEM CONTRACT CS03
TRACK AND SIGNALLING PLAN LINE 7
SIR VISHWESHWARAIAH MOTI BAGH STATION TO HAZRAT NIZAMUDDIN STATION
NIZAMUDDIN CROSS-OVER PROFILES

DRAWING No:	COST CENTRE:	SCALE	SHEET	CONT.	REV.
100241842	A PRELIMINARIES AND GENERAL REQUIREMENTS	N/S	27	28	8.0

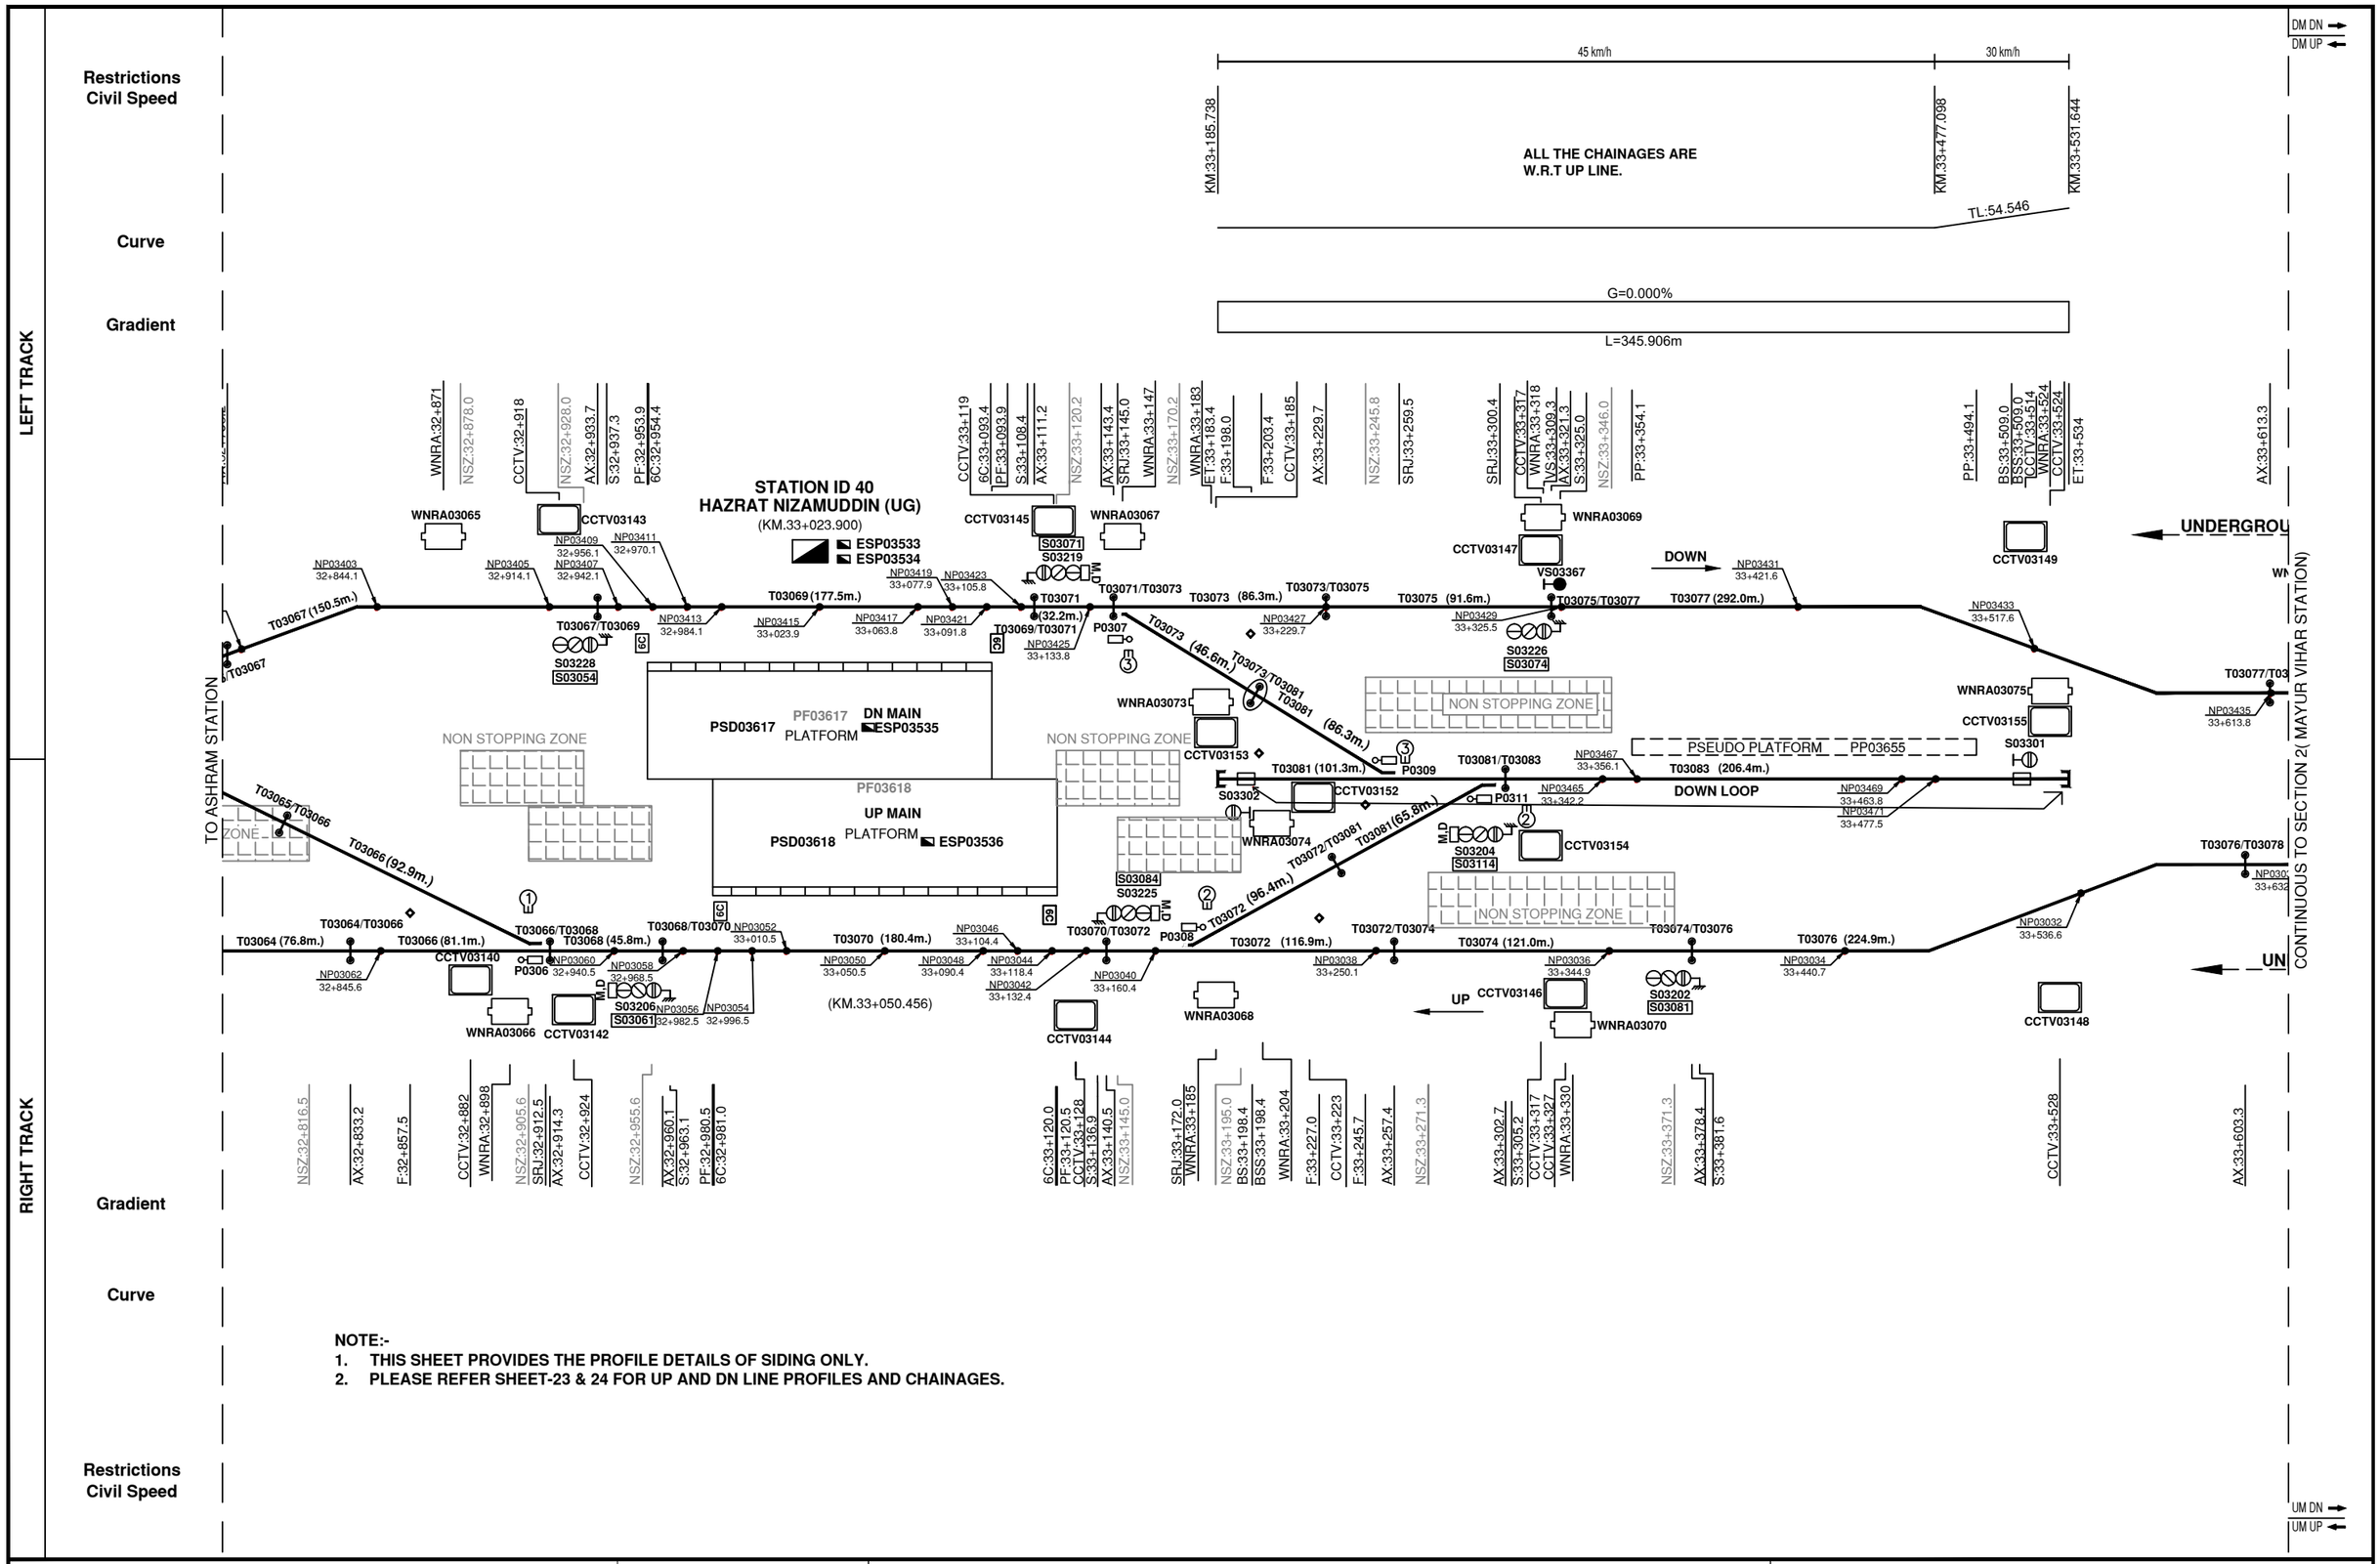

NOTE:-
1. THIS SHEET PROVIDES THE PROFILE DETAILS OF SIDING ONLY.
2. PLEASE REFER SHEET-23 & 24 FOR UP AND DN LINE PROFILES AND CHAINAGES.

DELHI METRO RAIL CORPORATION LTD.
Metro Bhawan, Fire Brigade Lane, Barakhamba Road, New Delhi-110001

ORIGINATOR:
BOMBARDIER
the evolution of mobility

© 2019, Bombardier Inc. All rights reserved.

AS-BUILT DRAWING

REV	DATE	DESCRIPTION
8.0	26-JUN-19	AS-BUILT DRAWING

	NAME	DATE
DESIGNED	IRSHAD A.	25-JUN-19
CHECKED	ASHOK K.	26-JUN-19
APPROVED	ROHIT T.	26-JUN-19

DRAWING TITLE: DELHI MRTS PROJECT PHASE III LINE 7
TRAIN CONTROL & SIGNALLING SYSTEM CONTRACT CS03
TRACK AND SIGNALLING PLAN LINE 7
SIR VISHWESHWARAIAH MOTI BAGH STATION TO HAZRAT NIZAMUDDIN STATION
NIZAMUDDIN SIDING TRACK

DRAWING No:	COST CENTRE:	SCALE	SHEET	CONT.	REV.
100241842	A PRELIMINARIES AND GENERAL REQUIREMENTS	N/S	28	29	8.0

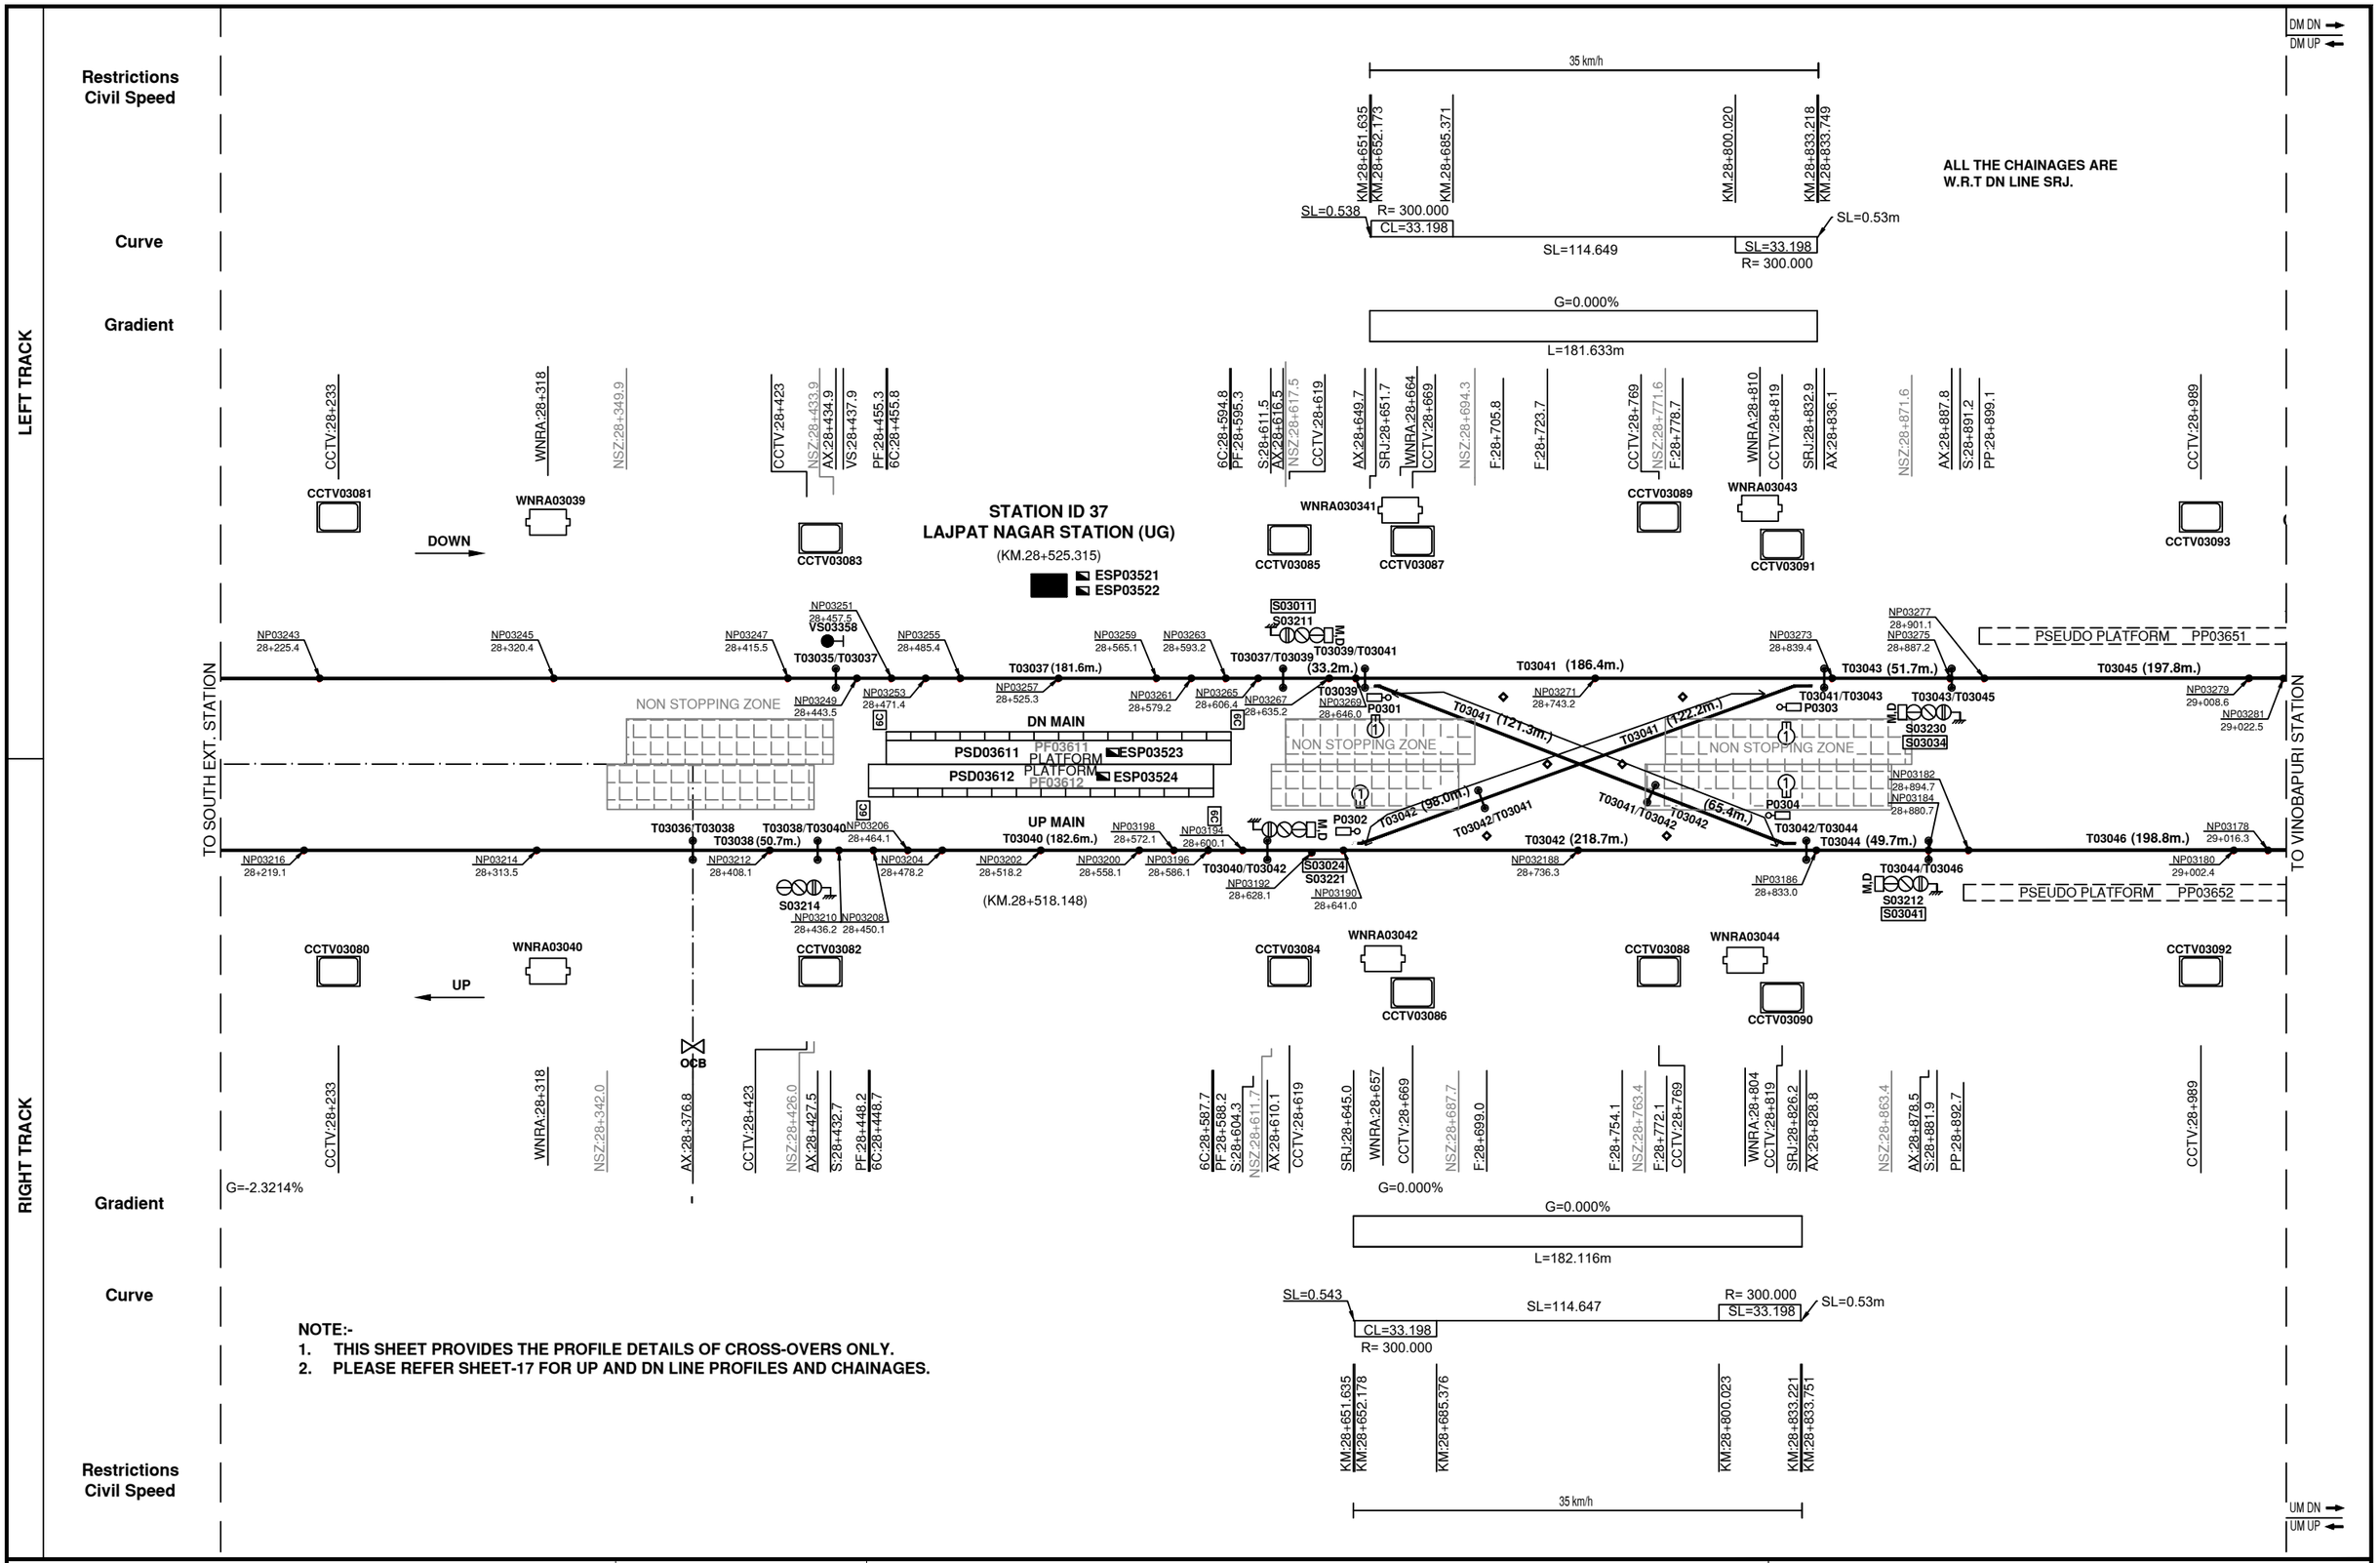

NOTE:-

1. THIS SHEET PROVIDES THE PROFILE DETAILS OF CROSS-OVERS ONLY.
2. PLEASE REFER SHEET-17 FOR UP AND DN LINE PROFILES AND CHAINAGES.

DELHI METRO RAIL CORPORATION LTD.
Metro Bhawan, Fire Brigade Lane, Barakhamba Road, New Delhi-110001

ORIGINATOR:
BOMBARDIER
the evolution of mobility

© 2019, Bombardier Inc. All rights reserved.

AS-BUILT DRAWING

REV	DATE	DESCRIPTION
8.0	26-JUN-19	AS-BUILT DRAWING

	NAME	DATE
DESIGNED	IRSHAD A.	25-JUN-19
CHECKED	ASHOK K.	26-JUN-19
APPROVED	ROHIT T.	26-JUN-19

DRAWING TITLE: DELHI MRTS PROJECT PHASE III LINE 7
TRAIN CONTROL & SIGNALLING SYSTEM CONTRACT CS03
TRACK AND SIGNALLING PLAN LINE 7
SIR VISHWESHWARAIAH MOTI BAGH STATION TO HAZRAT NIZAMUDDIN STATION
LAJPAT NAGAR CROSSOVER PROFILES

DRAWING No:	COST CENTRE:	SCALE	SHEET	CONT.	REV.
100241842	A PRELIMINARIES AND GENERAL REQUIREMENTS	N/S	29	-	8.0

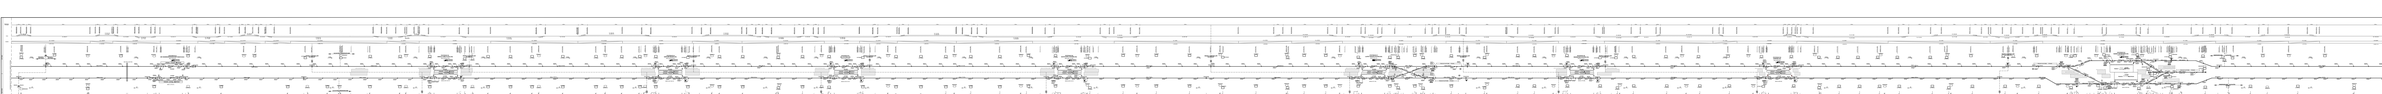

1	1
2	2
3	3
1493	1493
1494