DELHI MRTS PROJECT PHASE III LINE 7

TRAIN CONTROL & SIGNALLING SYSTEM CONTRACT CS03

TRACK AND SIGNALLING PLAN LINE 7

MAYUR VIHAR TO MANDAWALI - WEST VINOD NAGAR STATION

SECTION-HI

DELHI METRO RAIL CORPORATION LTD.
Metro Bhawan, Fire Brigade Lane, Barakhamba Road, New Delhi-110001

ORIGINATOR:
BOMBARDIER
the evolution of mobility

© 2019, Bombardier Inc.
All rights reserved.

AS-BUILT DRAWING

REV	DATE	DESCRIPTION
7.0	03-JUL-19	AS-BUILT DRAWING

	NAME	DATE
DESIGNED	SONAM R.	03-JUL-19
CHECKED	ASHOK K.	03-JUL-19
APPROVED	ROHIT T.	03-JUL-19

DRAWING TITLE: DELHI MRTS PROJECT PHASE III LINE 7
TRAIN CONTROL & SIGNALLING SYSTEM CONTRACT CS03
TRACK AND SIGNALLING PLAN LINE 7
MAYUR VIHAR TO MANDAWALI - WEST VINOD NAGAR STATION
SECTION-HI

DRAWING No:	COST CENTRE:	SCALE	SHEET	CONT.	REV.
100228105	B DETAILED DESIGN	N/S	1	2	7.0

REV.	REVISION INFORMATION	DESIGNED	CHECKED	DATE
7.0	AS-BUILT RELEASED	SONAM R.	ASHOK K.	03-JUL-2019
6.4	-UPDATED AS PER THE REVIEWER'S COMMENTS AS PER MoR DATED 03-JUL-19.	SONAM R.	ASHOK K.	03-JUL-2019
	UPDATED STATION NAME IN TITLE BLOCK			
6.3	-ADDED WNRA & CCTV DETAILS AS PER RF SCHEMATIC REGION 4	SONAM R.	ASHOK K.	02-JUL-2019
	-REMOVED NOTE NO. 1,2 & 3 AT SHEET 1 OF 1			
	-ADDED NOTES AT SHEET 1 OF 1			
6.2	-UPDATED AS PER THE REVIEWER'S COMMENTS AS PER MoR DATED 22-JAN-19.	KULDEEP M.	ASHOK K.	24-JAN-2019
6.1	-UPDATED FOLLOWING AS PER THE NCR bkk_067#2027	KULDEEP M.	ASHOK K.	03-JAN-2018
	UPDATED THE STATION NAME OF 'VINOD NAGAR' TO 'MANDAWALI - WEST VINOD NAGAR'.			
	UPDATED THE STATION NAME OF 'VINOD NAGAR EAST' TO 'EAST VINOD NAGAR - MAYUR VIHAR-II'.			
	UPDATED THE STATION NAME OF 'TRILOKPURI' TO 'TRILOKPURI-SANJAY LAKE'.			
	-UPDATED FOLLOWING AS PER THE CBTC MAP SURVEY REPORT.			
	ADDED NORMING POINT DATA INTO THE SIGNALLING PLAN			
	UPDATED CHAINAGES OF SIGNALS, AX COUNTERS, PLATFORM CENTER, BUFFER STOP AND TRACK SECTION LENGTHS.			

REVISION INFORMATION

DELHI METRO RAIL CORPORATION LTD.
Metro Bhawan, Fire Brigade Lane, Barakhamba Road, New Delhi-110001

ORIGINATOR:
BOMBARDIER
the evolution of mobility

© 2019, Bombardier Inc.
All rights reserved.

AS-BUILT DRAWING

REV	DATE	DESCRIPTION
7.0	03-JUL-19	AS-BUILT DRAWING

	NAME	DATE
DESIGNED	SONAM R.	03-JUL-19
CHECKED	ASHOK K.	03-JUL-19
APPROVED	ROHIT T.	03-JUL-19

DRAWING TITLE:
DELHI MRTS PROJECT PHASE III LINE 7
TRAIN CONTROL & SIGNALLING SYSTEM CONTRACT CS03
TRACK AND SIGNALLING PLAN LINE 7
MAYUR VIHAR TO MANDAWALI - WEST VINOD NAGAR STATION
SECTION-HI

DRAWING No:	COST CENTRE:	SCALE	SHEET	CONT.	REV.
100228105	B DETAILED DESIGN	N/S	2	3	7.0

REV.	REVISION INFORMATION	DESIGNED	CHECKED	DATE
6.0	RELEASED	KULDEEP M.	ASHOK K.	03-AUG-2018
5.2	UPDATED AS PER REVIEWER'S COMMENTS BASED ON MoR DATED 3-AUG-2018.	KULDEEP M.	ASHOK K.	03-AUG-2018
	UPDATED THE CHAINAGES OF BUFFER & EOT AS PER TRACK AS-BUILT.			
	UPDATED THE CHAINAGES OF FIXED LED LIGHTS AS PER FCO-DL7-2018-073			
5.1	AS PER NCR bkk_067#1853 :-	KULDEEP M.	ASHOK K.	27-JUL-2018
	- UPDATED THE SPEED, GRADE AND CURVE PROFILES FOR MAINLINE MVPI TO VNNR AS PER TRACK AS-BUILT			
	RECEIVED ON 11-JUL-18 (REFER SHEET 3, S.NO. 6)			
	- ADDED THE SPEED ,GRADE & CURVE PROFILES IN MAYUR VIHAR PKT-1 CROSS-OVER.			
	AS PER NCR bkk_067#1143 :-			
	UPDATED SPEED FOR STRAIGHT LINE AS 95 KM/H BEFORE MVPI STATION.			
5.0	- RELEASED	KULDEEP M.	ASHOK K.	10-APR-2018
4.1	- UPDATED AS PER NCR bkk_067#1609.	KULDEEP M.	ASHOK K.	03-APR-2018
	- ADDED A NEW VIRTUAL SIGNAL VS04362 AT TRACK T04014 IN UP DIRECTION.			
4.0	-RELEASED	KULDEEP M.	JAYA S.	29-NOV-2017
3.4	-UPDATED AS PER REVIEWER'S COMMENTS DATED 29-11-2017	KULDEEP M.	JAYA S.	29-NOV-2017
3.3	-UPDATED AS PER REVIEWER'S COMMENTS DATED 27-11-2017	KULDEEP M.	JAYA S.	28-NOV-2017
	-AX ADJUSTED NEAR POINT AREA IN MVPO TO PROVIDE CLEARANCE FROM FM.			
	-ALL CHANGES DONE IN LAYER "REVISION 3.2" & MARKED INSIDE CLOUD			
3.2	-UPDATED AS PER IMPACT ANALYSIS REPORT FOR PART COMMISSIONING OF SECTION-HI	KULDEEP M.	JAYA S.	23-NOV-2017
	DOCUMENT NO.-TBD, DATED-21-08-2017 Rev 0.1			
	-ADDED FIXED RED LIGHT AT THE END OF TRACK AVAILABLE BETWEEN MVPO & TKPR STATION FOR UP & DN LINE			
	-ADDED VIRTUAL SIGNAL AT TKPR PF IN REVERSE DIRECTION			
	-UPDATED SIGNAL PLAN AS PER GAD DATED 14 JAN 2016 (REFER SHEET 3)			
3.1	-UPDATED MVPI NEUTRAL SECTION CHAINAGE AS PER LETTER DMRC/134/14/RS9/INTERFACE/250 DATED 13.04.2015	JAYA S.	VARUN C.	17-NOV-2015
	-UPDATED CAD ERROR OF POINT MACHINE AT P0401, P0402 & P0404			
	-UPDATED AX COUNTER NAME AT BOUNDARY			
3.0	-RELEASED	SELVADASS D.	JAYA S.	19-MAY-2015
2.3	-UPDATED AS PER REVIEWER'S COMMENT DATED 15-APR-15	SELVADASS D.	JAYA S.	17-APR-2015
2.2	-UPDATED AS PER LATEST CIVIL ALIGNMENT DRAWINGS DATED: 04-03-15	SELVADASS D.	JAYA S.	10-APR-2015
2.1	-UPDATED AS PER LATEST CIVIL ALIGNMENT DRAWINGS DATED: 08-12-14	SANTOSH N.	VARUN C.	28-JAN-2015
2.0	-RELEASED	ARNUT S.	WICHIT I.	02-SEP-2014
1.2	-UPDATED AS PER WICHIT'S COMMENTS IN MOR SIGNALLING PLAN SECTION 1 REV1.1	ARNUT S.	WICHIT I.	01-SEP-2014
1.1	-UPDATED ACCORDING TO CUSTOMER FEEDBACK SIGNALLING PLAN SECTION1 REV2.0	ARNUT S.	WICHIT I.	22-AUG-2014
1.0	-RELEASED	ARNUT S.	WICHIT I.	10-JUN-2014
0.4	-UPDATED ACCORDING TO MOR SIGNALLING PLAN SECTION 2 (TEERAPAT C.)	ARNUT S.	WICHIT I.	09-JUN-2014
0.3	-REDESIGNED AGAINST SIGNALLING PRINCIPLE REV2.0	ARNUT S.	WICHIT I.	04-JUN-2014
	-REDESIGNED AGAINST EQUIPMENT NUMBERING SCHEMATIC REV5.0			
0.2	-UPDATED TRACK BORDERS BETWEEN IPEXTENSION AND VINOD NAGAR DEPOT AND INTERLOCKING BORDER WITH	ARNUT S.	WICHIT I.	28-FEB-2014
	-UPDATED NEW NUMBERING TRACKS			
	-UPDATED TRACKS AT BORDER TO HAZRAD NIZAMUDDIN			
	-ADDED PSEUDO PLATFORMS AND VIRTUAL SIGNALS			
0.1	-FIRST DRAFT	ARNUT S.	WICHIT I.	23-DEC-2013

REVISION INFORMATION

DELHI METRO RAIL CORPORATION LTD.
Metro Bhawan, Fire Brigade Lane, Barakhamba Road, New Delhi-110001

ORIGINATOR:
BOMBARDIER
the evolution of mobility

© 2019, Bombardier Inc.
All rights reserved.

AS-BUILT DRAWING

REV	DATE	DESCRIPTION
7.0	03-JUL-19	AS-BUILT DRAWING

	NAME	DATE
DESIGNED	SONAM R.	03-JUL-19
CHECKED	ASHOK K.	03-JUL-19
APPROVED	ROHIT T.	03-JUL-19

DRAWING TITLE: DELHI MRTS PROJECT PHASE III LINE 7
TRAIN CONTROL & SIGNALLING SYSTEM CONTRACT CS03
TRACK AND SIGNALLING PLAN LINE 7
MAYUR VIHAR TO MANDAWALI - WEST VINOD NAGAR STATION
SECTION-HI

DRAWING No:	COST CENTRE:	SCALE	SHEET	CONT.	REV.
100228105	B DETAILED DESIGN	N/S	3	4	7.0

SHEET NO.	FILE NAME	DOCUMENT TITLE/NUMBER	REV.	COMMENT
09	RF SCHEMATIC REGION 4	100238977	4.0	FOR WNRA & CCTV LOCATION
08	CBTC DATA SUMMARY SITE SURVEY REGION-4 (MVPI-IPE), 100341160		4.0	SITE SURVEY REPORT REGION-4
07	DMRC\S&T\CS03\PH-II\BT\561\II\2054		-	RENAMING OF METRO STATIONS OF LINE-7
06	24-04-2018 AS-BUILTGAD LAJPAT NAGAR TO SHIV VIHAR.dwg		-	DETAILS OF PROFILES FROM GOKULPURI TO SHIV VIHAR (UP LINE-2 AND DOWN LINE-2) (RECEIVED 11-07-2018)
05	EMAIL FROM PE DATED 28.11.2017		-	REGARDING THE FOULING MARK CHAINAGES
04	H.NIZAMUDDIN TO SHIV VIHAR 14.01.16.dwg		R3	GENERAL ALIGNMENT PLAN H. NIZAMUDDIN TO SHIV VIHAR (DOWN LINE)
03	H.NIZAMUDDIN TO SHIV VIHAR 14.01.16.dwg	H.Y./MP-SV/ELEV/GA/0001 (SHEET NO. 001 TO 009)	R3	GENERAL ALIGNMENT PLAN H. NIZAMUDDIN TO SHIV VIHAR (UP LINE)
02	EMAIL FROM PE DATED-22-08-2017		-	REGARDING THE NUMBERING OF VIRTUAL SIGNAL
01	IMPACT ANALYSIS PART COMMISSIONING OF SECTION HI	TBD	0.1	

REFERENCE DOCUMENT

DELHI METRO RAIL CORPORATION LTD.
Metro Bhawan, Fire Brigade Lane, Barakhamba Road, New Delhi-110001

ORIGINATOR:
BOMBARDIER
the evolution of mobility

© 2019, Bombardier Inc.
All rights reserved.

AS-BUILT DRAWING

REV	DATE	DESCRIPTION
7.0	03-JUL-19	AS-BUILT DRAWING

	NAME	DATE
DESIGNED	SONAM R.	03-JUL-19
CHECKED	ASHOK K.	03-JUL-19
APPROVED	ROHIT T.	03-JUL-19

DRAWING TITLE:
DELHI MRTS PROJECT PHASE III LINE 7
TRAIN CONTROL & SIGNALLING SYSTEM CONTRACT CS03
TRACK AND SIGNALLING PLAN LINE 7
MAYUR VIHAR TO MANDAWALI - WEST VINOD NAGAR STATION
SECTION-HI

DRAWING No:	COST CENTRE:	SCALE	SHEET	CONT.	REV.
100228105	B DETAILED DESIGN	N/S	4	5	7.0

SYMBOLS USED IN THE TRACK AND SIGNALLING PLAN

SYMBOL	DESCRIPTION
1 SXXYYY M.D.S.T FOR ELEVATED SXXYYY SXXYYY M.D.S.T FOR UNDERGROUND (WALL MOUNT) SXXYYY	ROUTE INDICATOR — M FOR MAIN LINE GREEN ASPECT — D FOR FIRST DIVERSION VIOLET ASPECT — S FOR SECOND DIVERSION RED ASPECT — T FOR THIRD DIVERSION 3 – ASPECT SIGNAL "XX" = REGION NO. "YYY" = OBJECT NUMBERING (201–300)
2 SXXXXY SAABBB M.D.S.T	POINT PROTECTION SIGNAL "XXXX" = POINT NO. "Y" = DIRECTION OF TRAVEL "AA" = REGION NO. "BBB" = OBJECT NUMBERING (201–300)
3 SXXYYY	SHUNT SIGNAL "XX" = REGION NO. "YYY" = OBJECT NUMBERING (201–300)
4 SXXYYY	DEPENDENT SHUNT SIGNAL "XX" = REGION NO. "YYY" = OBJECT NUMBERING (201–300)
5 SXXYYY FOR ELEVATED SXXYYY FOR UNDERGROUND (WALL MOUNT)	BUFFER STOP SIGNAL "XX" = REGION NO. "YYY" = OBJECT NUMBERING (301–350)
6 VSXXYYY	VIRTUAL SIGNAL "XX" = REGION NO. "YYY" = OBJECT NUMBERING (351–400)
7 PXXYY	POINT MACHINE "XX" = REGION NO. "YY" = OBJECT NUMBERING (01–99) = EEA–5 (MAIN LINE) = RDL2 (DEPOT)
8	FOULING POINT (POSITION SHALL BE CONFIRMED AT SITE)
9	ELECTRICAL KEY TRANSMITTER "X" = EKT GROUP NUMBER (I.E. EKT#1 FOR GROUP NO.1) NOTE: STARTING NUMBER "1" IN EVERY STATION
10 TXXYYY	AXLE COUNTER SECTION "XX" = REGION NO. "YYY" = OBJECT NUMBERING (001–200)
11 TXXYYY / TXXYYY	AXLE COUNTER AXLE COUNTER LOCATED WITHIN FOULING AREA

SYMBOL	DESCRIPTION
12	NEUTRAL SECTION
13	BUFFER STOP AND END OF TRACK
14 85 km/h CIVIL SPEED	FROM CIVIL ENGINEERING POINT OF VIEW THE LIMITATION SPEED IS 85 km/h
15 1.500% L=100m	GRADIENT 1.5 GRADIENT LENGTH IS 100 (m)
16 R= 400.000 m L= 800.000 m	CURVE RADIUS IS 400 m CURVE LENGTH IS 800 m
17 KM. 9+911	MILEAGE IS 9911 (m)
18 ITI & OCB	ITI : INTERLOCKING TO INTERLOCKING BORDER (REGION BORDER) & OBJECT CONTROLLER TO OBJECT CONTROLLER BOUNDARY
19 DOWN UP	NORMAL DIRECTION OF TRAFFIC
20	STATION WITH CBI AND OC
21	STATION WITH OC
22 ESPXXYYY	EMERGENCY STOP PLUNGER (ESP) "XX" = REGION NO. "YYY" = OBJECT NUMBERING (501–600)
23 PLATFORM PSDXXYYY PFXXYYY	PLATFORM SCREEN DOOR & PLATFORM "XX" = REGION NO. "YYY" = OBJECT NUMBERING (601–650)
24 PSEUDO PPXXYYY	PSEUDO PLATFORM "XX" = REGION NO. "YYY" = OBJECT NUMBERING (651–700)

SYMBOL	DESCRIPTION
25 NPXXYYY	NORMING POINT "XX" = REGION No. "YYY" = OBJECT NUMBERING (001–999)
26 WNRAXXYYY	PAIR OF WAYSIDE NETWORK RADIO ASSEMBLY (WNRA) "XX" = REGION NO. "YYY" = OBJECT NUMBERING (001–200)
27 CCTVXXYYY	PAIR OF CLOSED CIRCUIT TELEVISION (CCTV) "XX" = REGION NO. "YYY" = OBJECT NUMBERING (001–200)
28	SINGLE OF LINE–OF–SIGHT (LOS) ANTENNA
29	PAIR OF LINE–OF–SIGHT (LOS) ANTENNA
30	LEAKY FEEDER CABLE
31 AE	ATC ENDS MARKER BOARD
32 AB	ATC BEGINS MARKER BOARD
33 XC	NORMAL STOPPING MARKER BOARD XC = NUMBER OF CAR
34 SR XC FOR MAINLINE	SR = STOPPING REVERSE MARKER BOARD XC = NUMBER OF CAR
35 STOP	STOP BOARD
36	TRAP POINT
37 OCB	OCB : OBJECT CONTROLLER TO OBJECT CONTROLLER (BOUNDARY)
38 PSDXXYYY FOR MAINLINE PSDXXYYY FOR DEPOT	PLATFORM SCREEN DOOR "XX" = REGION NO. "YYY" = OBJECT NUMBERING (601–650) FOR MAINLINE "YYY" = OBJECT NUMBERING (801–850) FOR DEPOT

DELHI METRO RAIL CORPORATION LTD.
Metro Bhawan, Fire Brigade Lane, Barakhamba Road, New Delhi-110001

ORIGINATOR:
BOMBARDIER
the evolution of mobility

© 2019, Bombardier Inc.
All rights reserved.

AS-BUILT DRAWING

REV	DATE	DESCRIPTION
7.0	03–JUL–19	AS–BUILT DRAWING

	NAME	DATE
DESIGNED	SONAM R.	03–JUL–19
CHECKED	ASHOK K.	03–JUL–19
APPROVED	ROHIT T.	03–JUL–19

DRAWING TITLE: DELHI MRTS PROJECT PHASE III LINE 7
TRAIN CONTROL & SIGNALLING SYSTEM CONTRACT CS03
TRACK AND SIGNALLING PLAN LINE 7
MAYUR VIHAR TO MANDAWALI - WEST VINOD NAGAR STATION
SECTION-HI

DRAWING No:	COST CENTRE:	SCALE	SHEET	CONT.	REV.
100228105	B DETAILED DESIGN	N/S	5	6	7.0

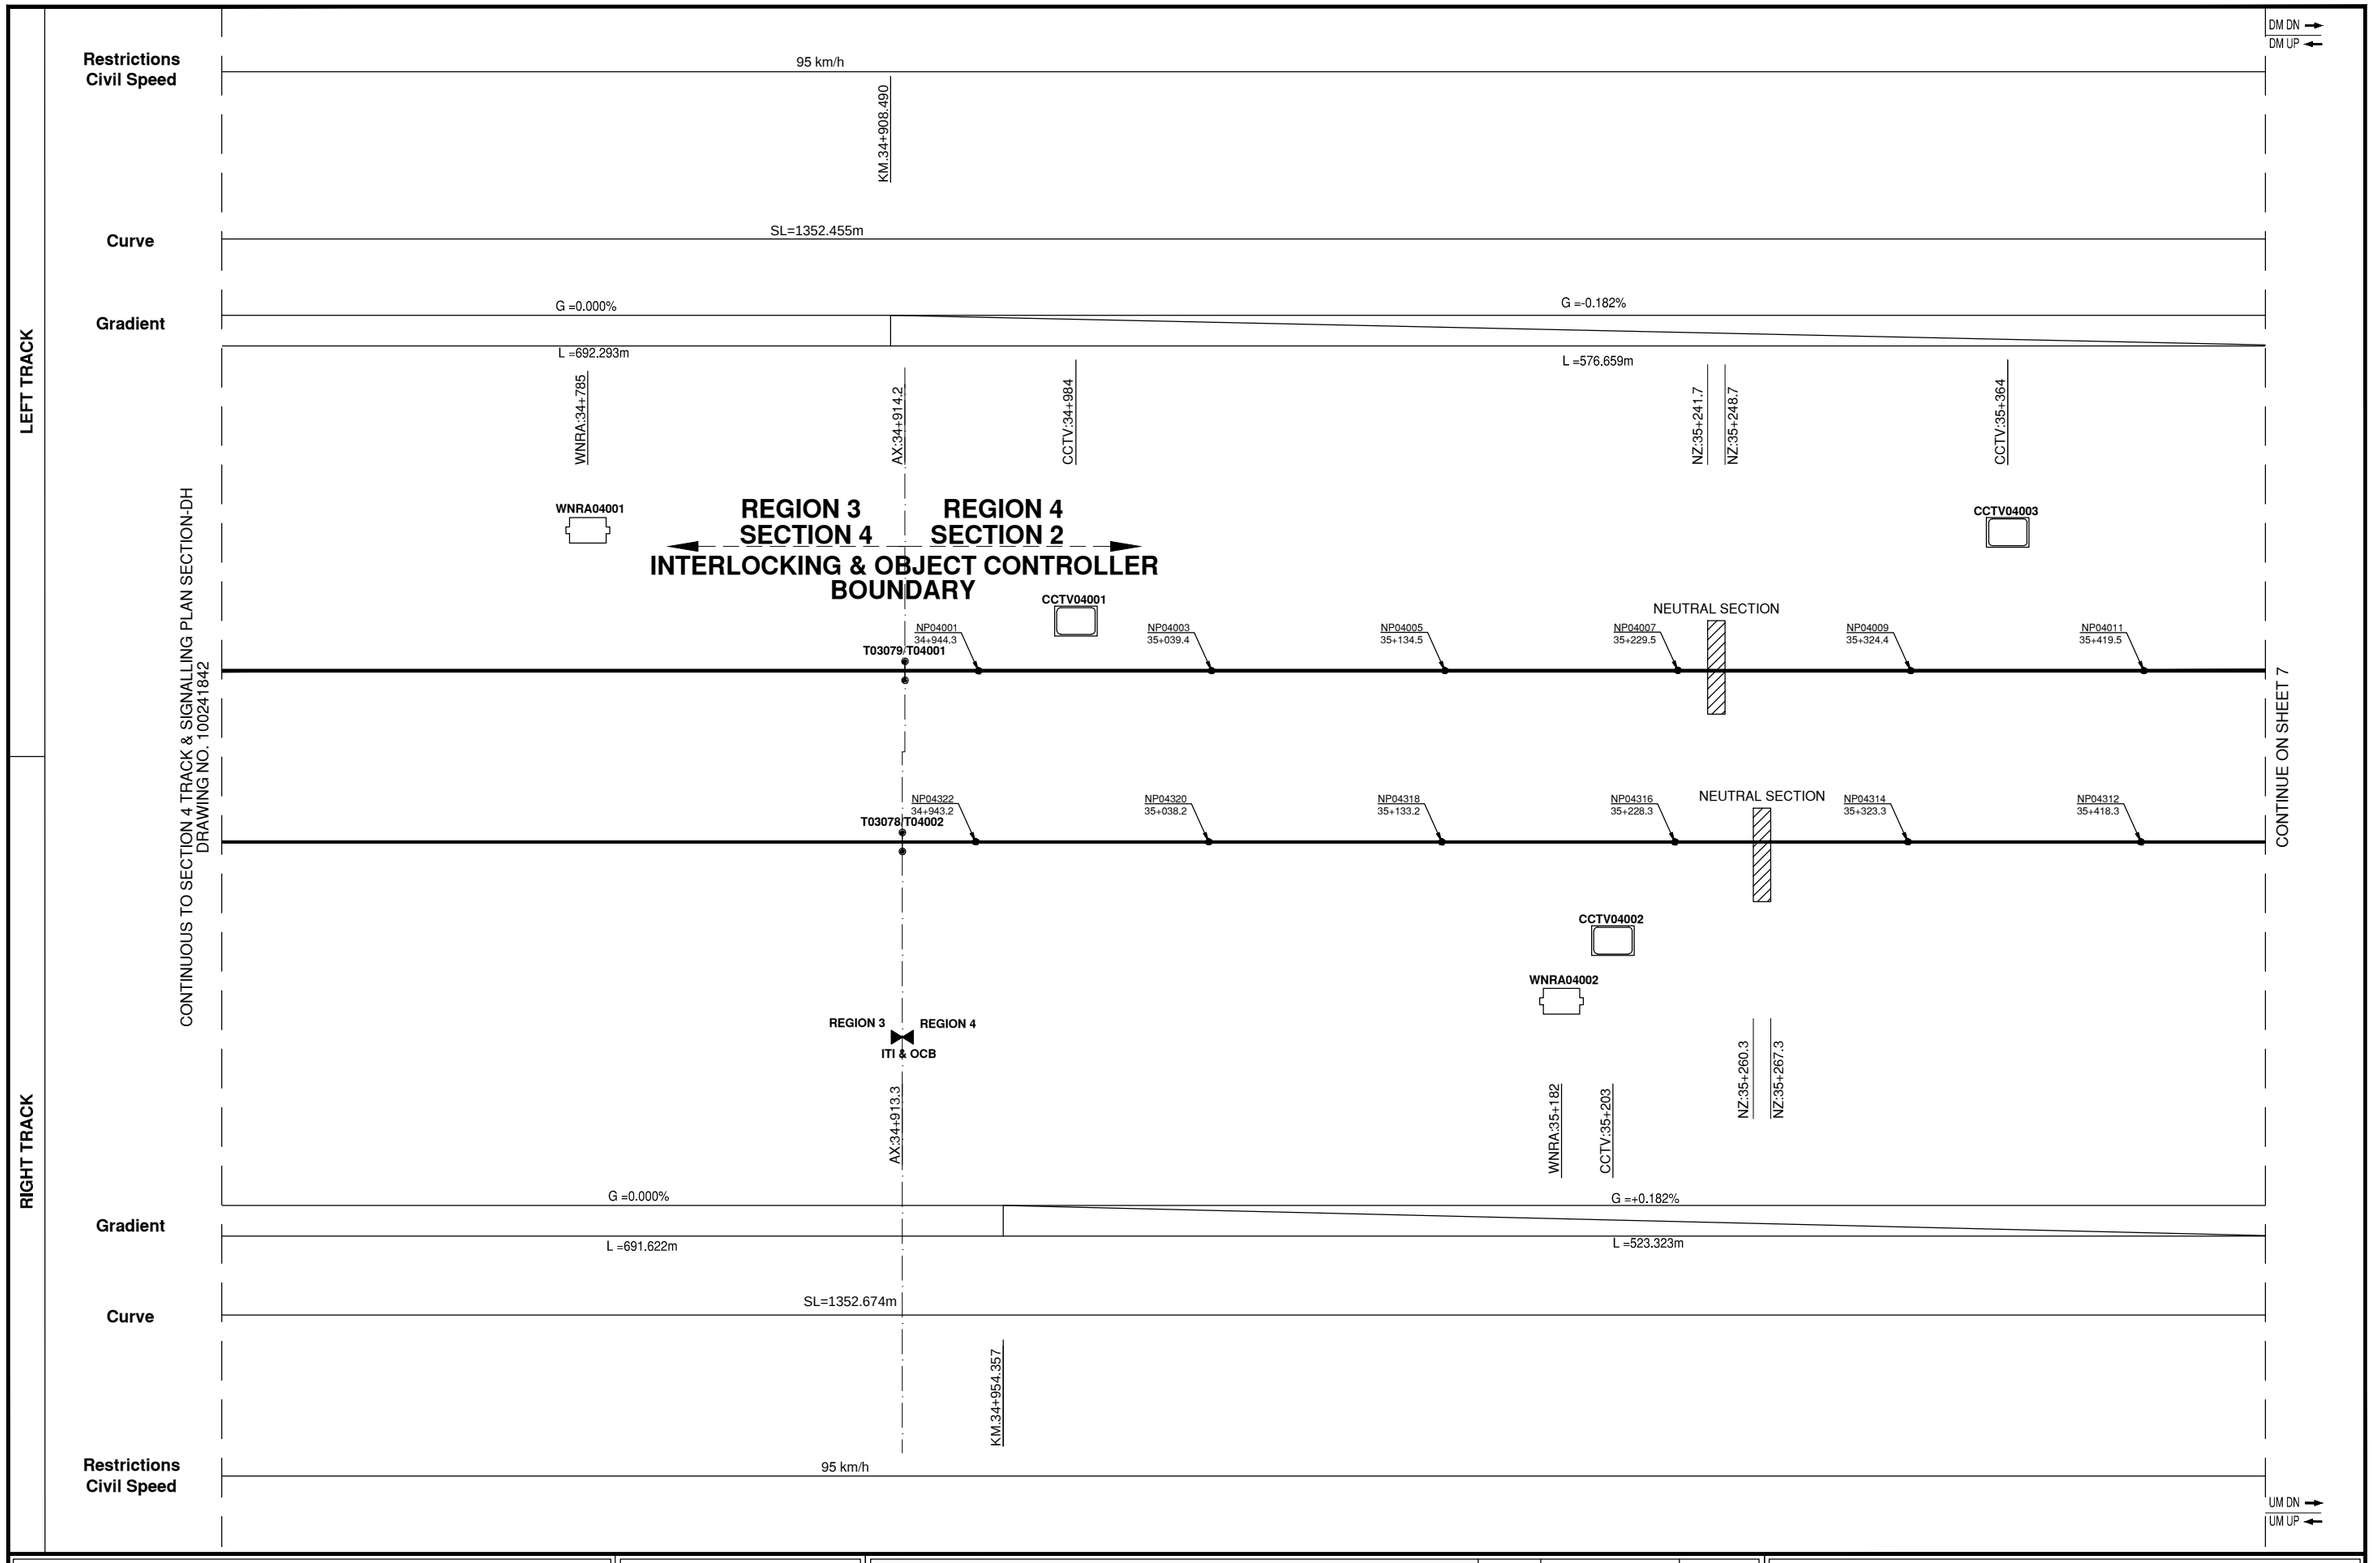

DELHI METRO RAIL CORPORATION LTD.
Metro Bhawan, Fire Brigade Lane, Barakhamba Road, New Delhi-110001

ORIGINATOR:
BOMBARDIER
the evolution of mobility

© 2019, Bombardier Inc.
All rights reserved.

AS-BUILT DRAWING

REV	DATE	DESCRIPTION
7.0	03-JUL-19	AS-BUILT DRAWING

	NAME	DATE
DESIGNED	SONAM R.	03-JUL-19
CHECKED	ASHOK K.	03-JUL-19
APPROVED	ROHIT T.	03-JUL-19

DRAWING TITLE: DELHI MRTS PROJECT PHASE III LINE 7
TRAIN CONTROL & SIGNALLING SYSTEM CONTRACT CS03
TRACK AND SIGNALLING PLAN LINE 7
MAYUR VIHAR TO MANDAWALI - WEST VINOD NAGAR STATION
SECTION-HI

DRAWING No:	COST CENTRE:	SCALE	SHEET	CONT.	REV.
100228105	B DETAILED DESIGN	N/S	6	7	7.0

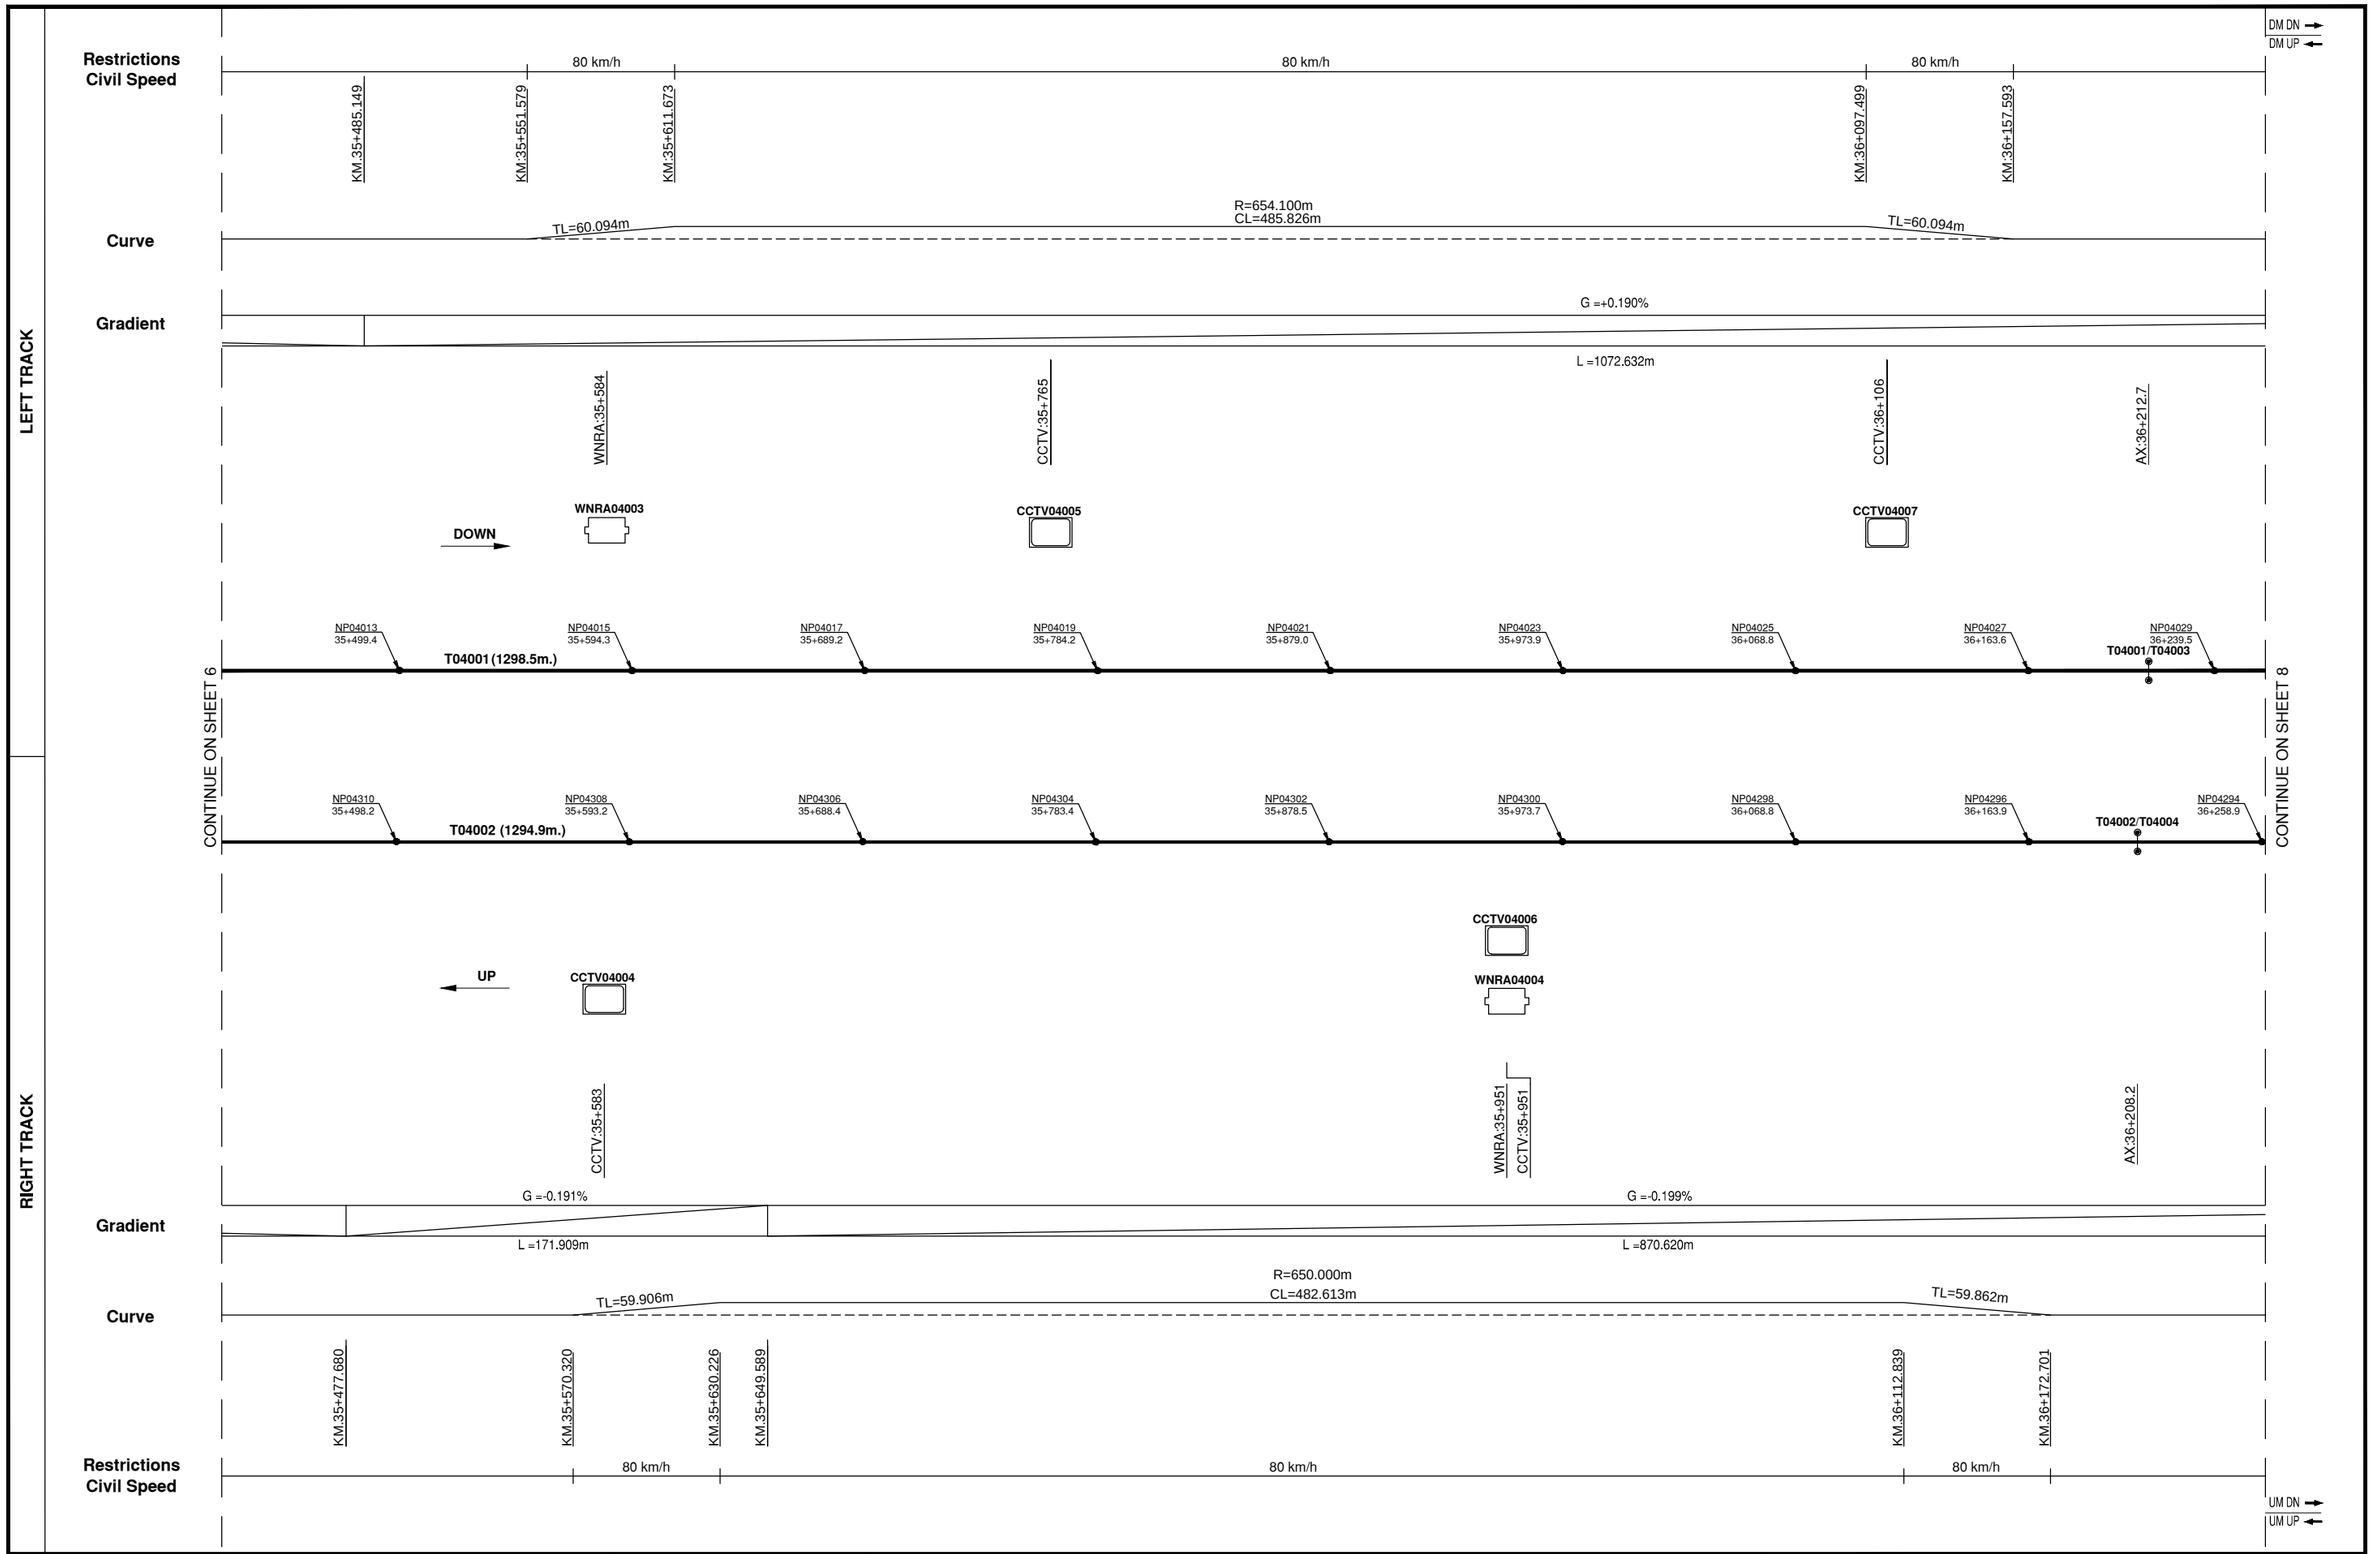

DELHI METRO RAIL CORPORATION LTD.
Metro Bhawan, Fire Brigade Lane, Barakhamba Road, New Delhi-110001

ORIGINATOR:
BOMBARDIER
the evolution of mobility

© 2019, Bombardier Inc.
All rights reserved.

AS-BUILT DRAWING

REV	DATE	DESCRIPTION
7.0	03-JUL-19	AS-BUILT DRAWING

	NAME	DATE
DESIGNED	SONAM R.	03-JUL-19
CHECKED	ASHOK K.	03-JUL-19
APPROVED	ROHIT T.	03-JUL-19

DRAWING TITLE: DELHI MRTS PROJECT PHASE III LINE 7
TRAIN CONTROL & SIGNALLING SYSTEM CONTRACT CS03
TRACK AND SIGNALLING PLAN LINE 7
MAYUR VIHAR TO MANDAWALI - WEST VINOD NAGAR STATION
SECTION-HI

DRAWING No:	COST CENTRE:	SCALE	SHEET	CONT.	REV.
100228105	B DETAILED DESIGN	N/S	7	8	7.0

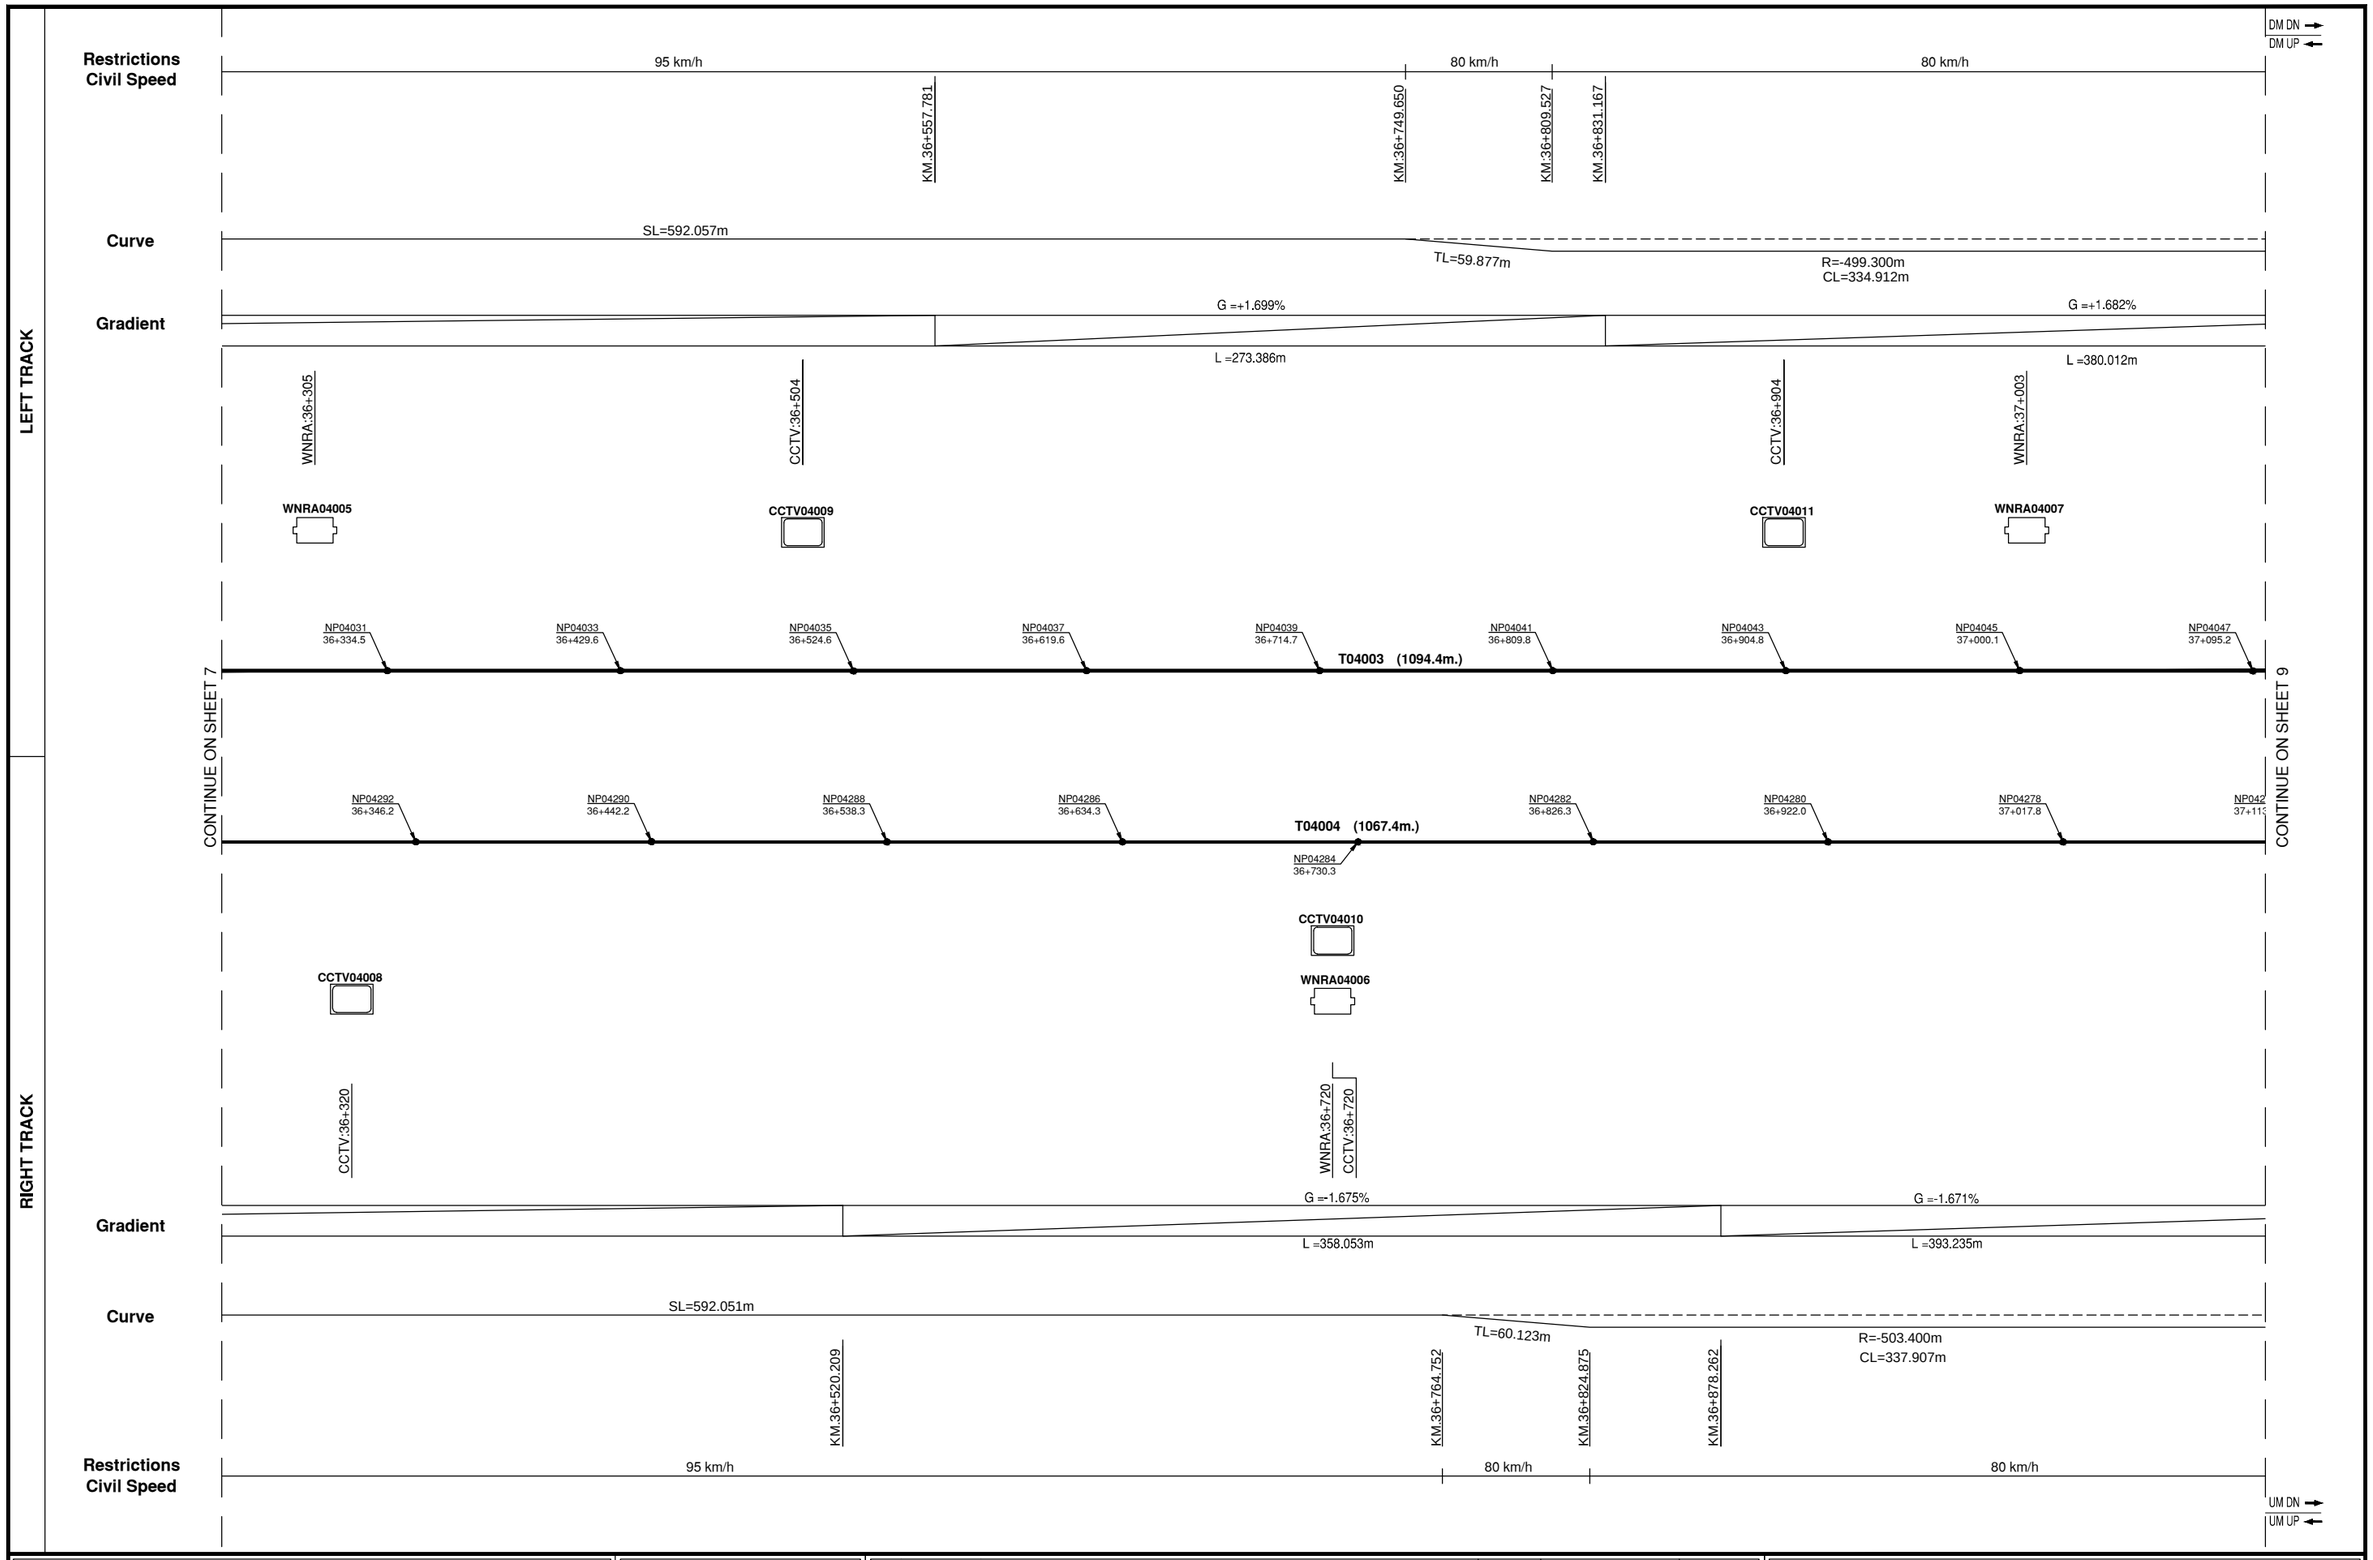

DELHI METRO RAIL CORPORATION LTD.
Metro Bhawan, Fire Brigade Lane, Barakhamba Road, New Delhi-110001

ORIGINATOR:
BOMBARDIER
the evolution of mobility

© 2019, Bombardier Inc.
All rights reserved.

AS-BUILT DRAWING

REV	DATE	DESCRIPTION
7.0	03-JUL-19	AS-BUILT DRAWING

	NAME	DATE
DESIGNED	SONAM R.	03-JUL-19
CHECKED	ASHOK K.	03-JUL-19
APPROVED	ROHIT T.	03-JUL-19

DRAWING TITLE:
DELHI MRTS PROJECT PHASE III LINE 7
TRAIN CONTROL & SIGNALLING SYSTEM CONTRACT CS03
TRACK AND SIGNALLING PLAN LINE 7
MAYUR VIHAR TO MANDAWALI - WEST VINOD NAGAR STATION
SECTION-HI

DRAWING No:	COST CENTRE:	SCALE	SHEET	CONT.	REV.
100228105	B DETAILED DESIGN	N/S	8	9	7.0

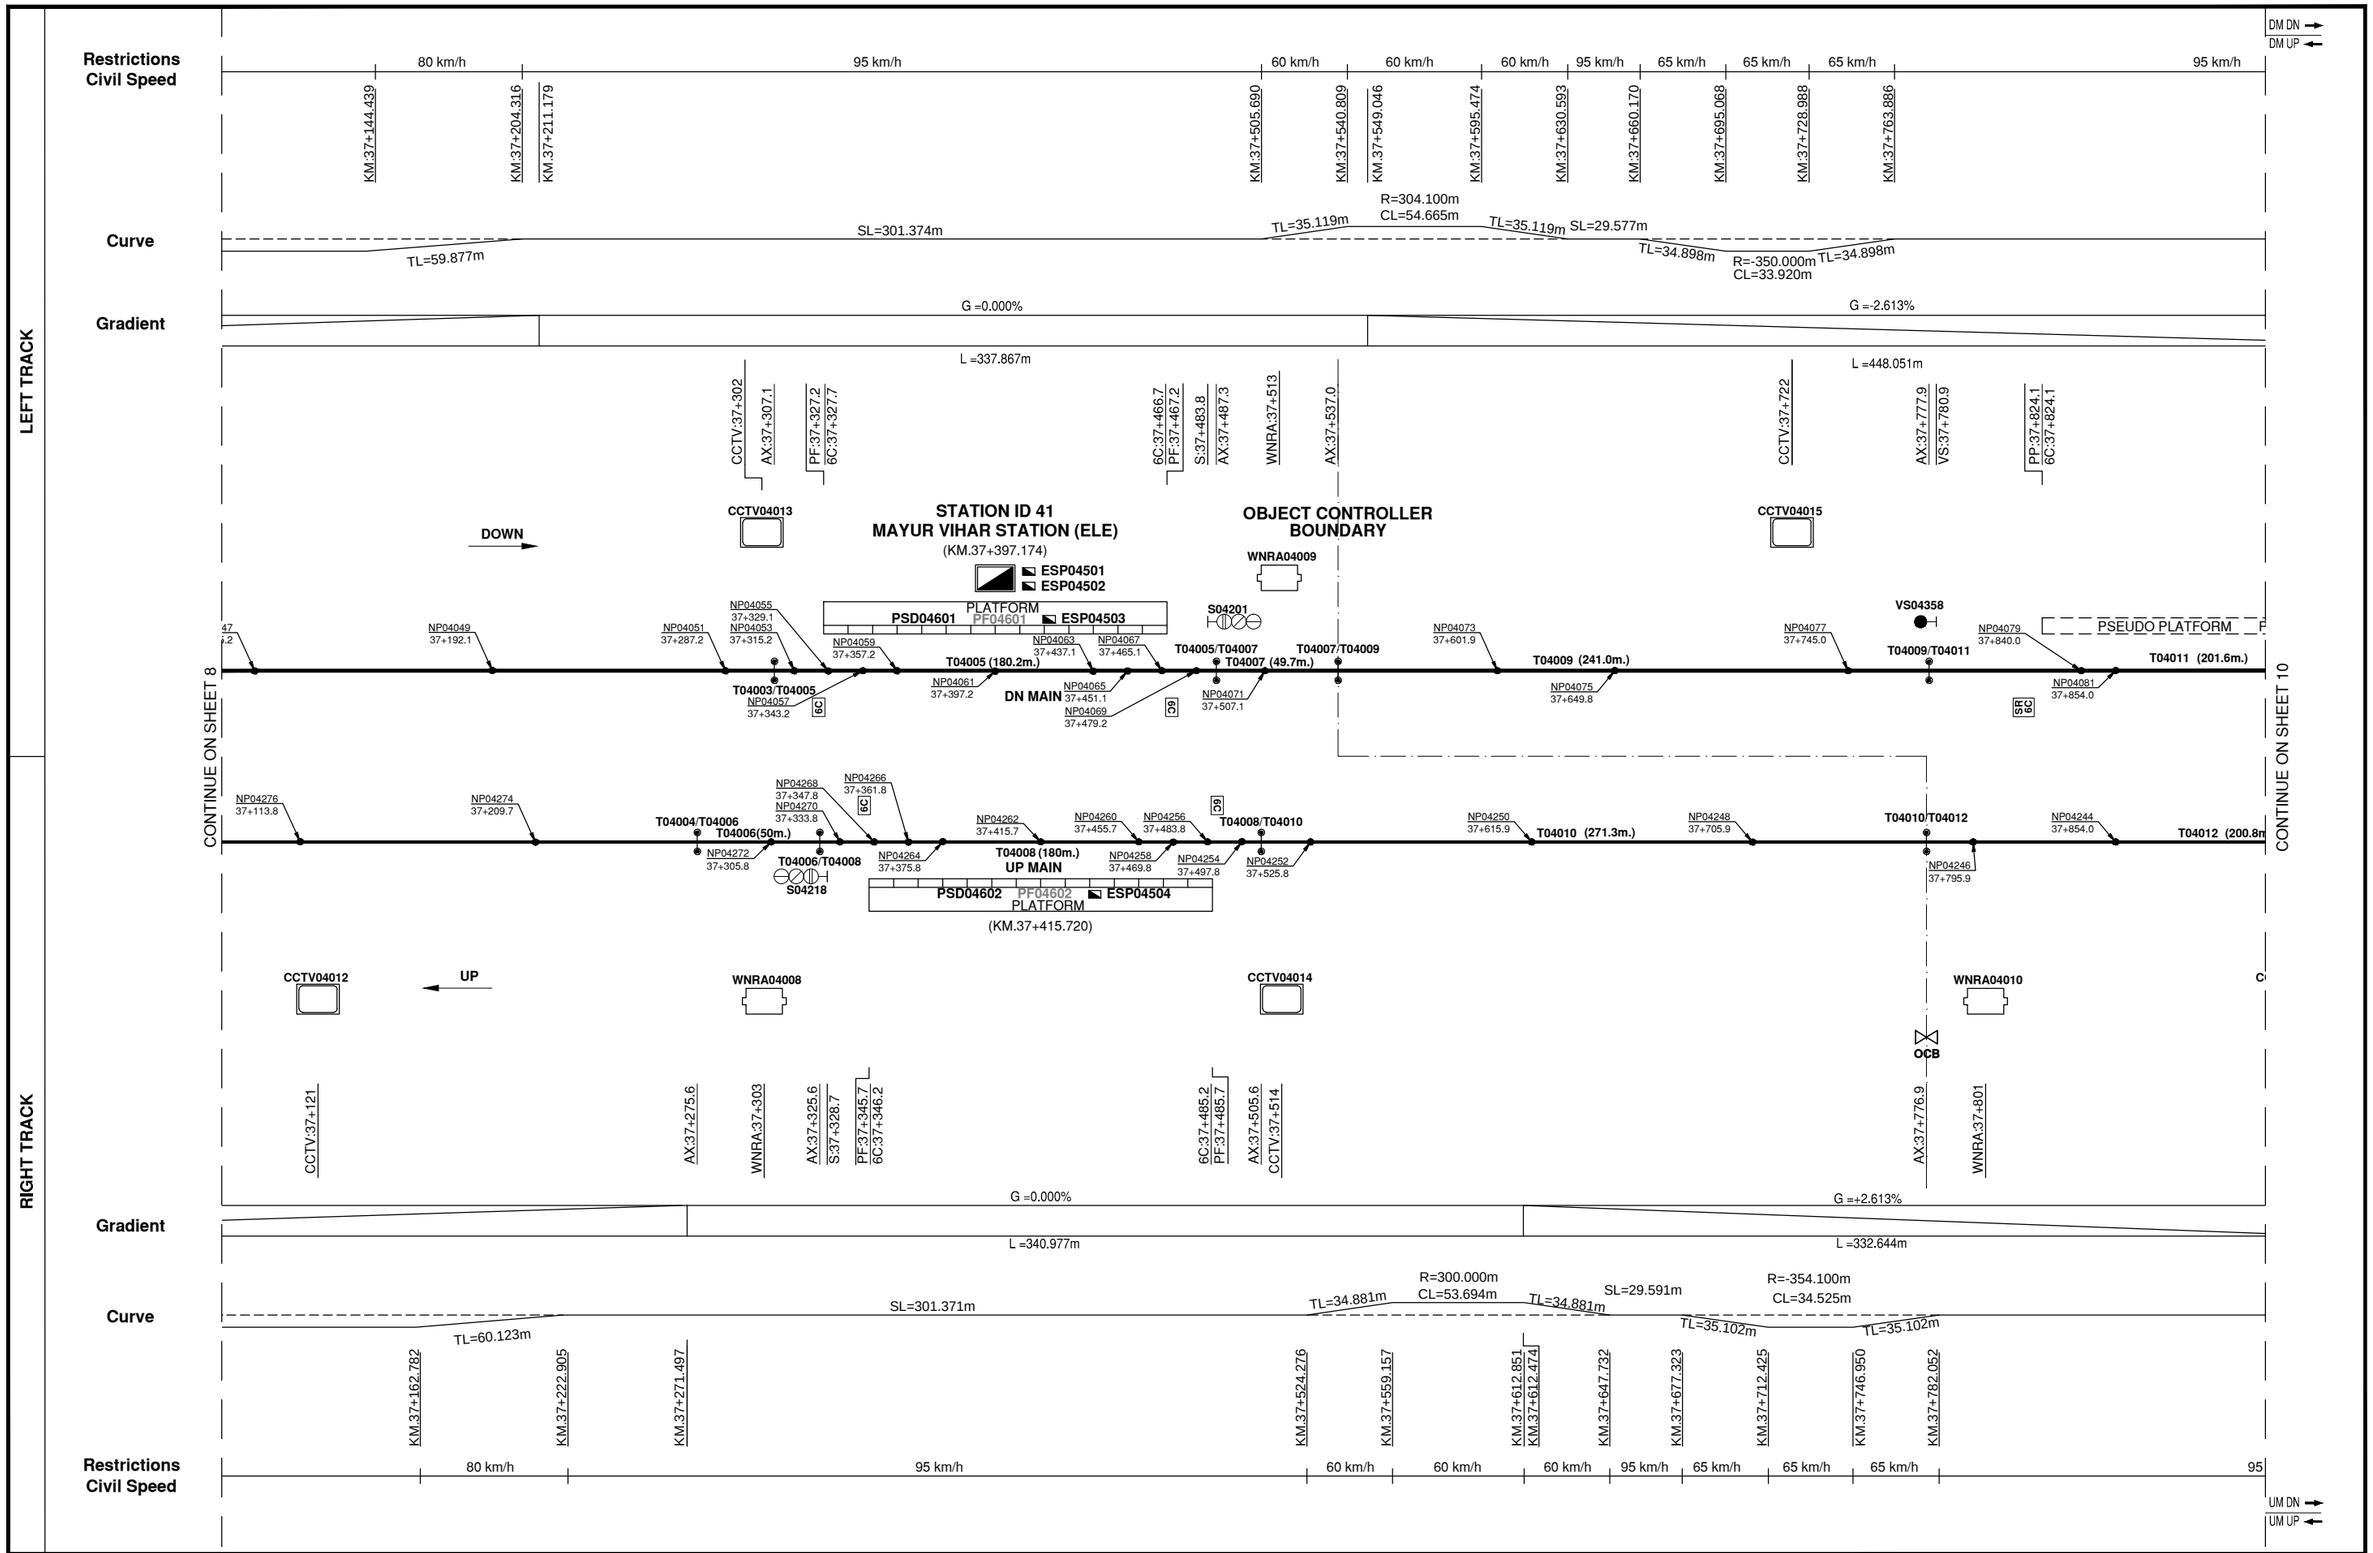

DELHI METRO RAIL CORPORATION LTD.
Metro Bhawan, Fire Brigade Lane, Barakhamba Road, New Delhi-110001

ORIGINATOR:
BOMBARDIER
the evolution of mobility

© 2019, Bombardier Inc.
All rights reserved.

AS-BUILT DRAWING

REV	DATE	DESCRIPTION
7.0	03–JUL–19	AS–BUILT DRAWING

	NAME	DATE
DESIGNED	SONAM R.	03–JUL–19
CHECKED	ASHOK K.	03–JUL–19
APPROVED	ROHIT T.	03–JUL–19

DRAWING TITLE: DELHI MRTS PROJECT PHASE III LINE 7
TRAIN CONTROL & SIGNALLING SYSTEM CONTRACT CS03
TRACK AND SIGNALLING PLAN LINE 7
MAYUR VIHAR TO MANDAWALI - WEST VINOD NAGAR STATION
SECTION-HI

DRAWING No:	COST CENTRE:	SCALE	SHEET	CONT.	REV.
100228105	B DETAILED DESIGN	N/S	9	10	7.0

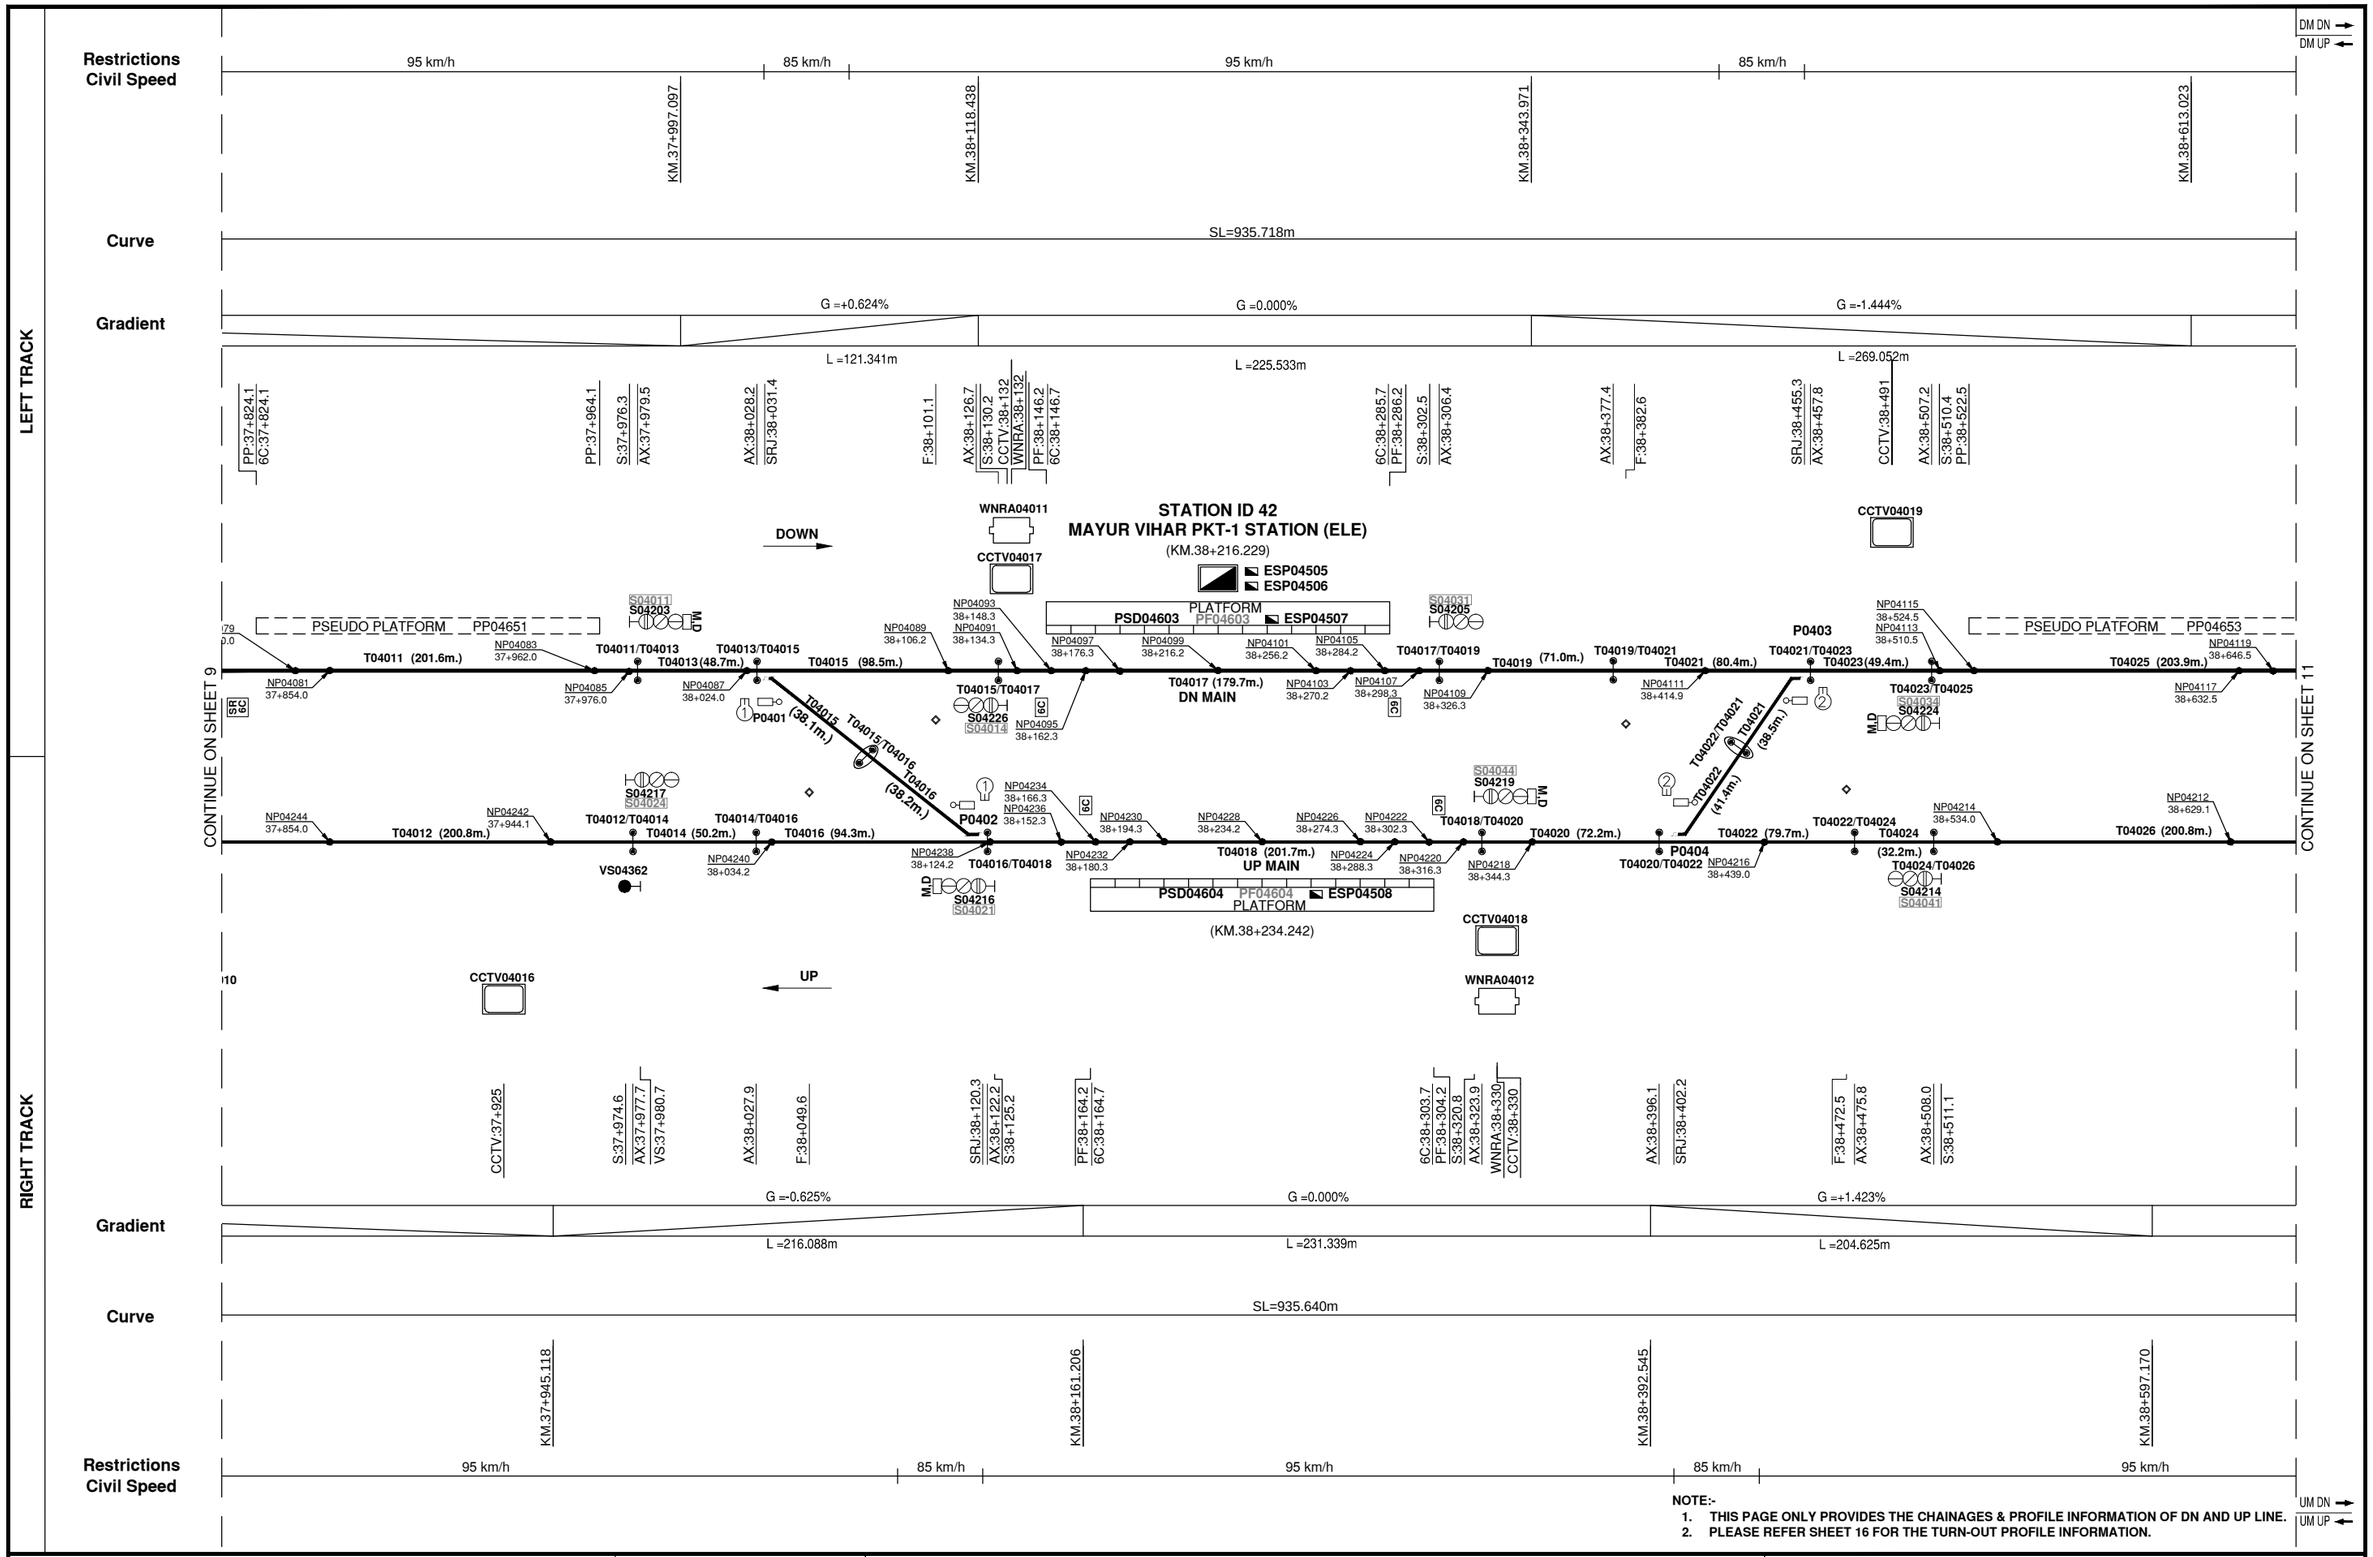

NOTE:-
1. THIS PAGE ONLY PROVIDES THE CHAINAGES & PROFILE INFORMATION OF DN AND UP LINE.
2. PLEASE REFER SHEET 16 FOR THE TURN-OUT PROFILE INFORMATION.

DELHI METRO RAIL CORPORATION LTD.
Metro Bhawan, Fire Brigade Lane, Barakhamba Road, New Delhi-110001

ORIGINATOR:
BOMBARDIER
the evolution of mobility

© 2019, Bombardier Inc.
All rights reserved.

AS-BUILT DRAWING

REV	DATE	DESCRIPTION
7.0	03-JUL-19	AS-BUILT DRAWING

	NAME	DATE
DESIGNED	SONAM R.	03-JUL-19
CHECKED	ASHOK K.	03-JUL-19
APPROVED	ROHIT T.	03-JUL-19

DRAWING TITLE:
DELHI MRTS PROJECT PHASE III LINE 7
TRAIN CONTROL & SIGNALLING SYSTEM CONTRACT CS03
TRACK AND SIGNALLING PLAN LINE 7
MAYUR VIHAR TO MANDAWALI - WEST VINOD NAGAR STATION
SECTION-HI

DRAWING No:	COST CENTRE:	SCALE	SHEET	CONT.	REV.
100228105	B DETAILED DESIGN	N/S	10	11	7.0

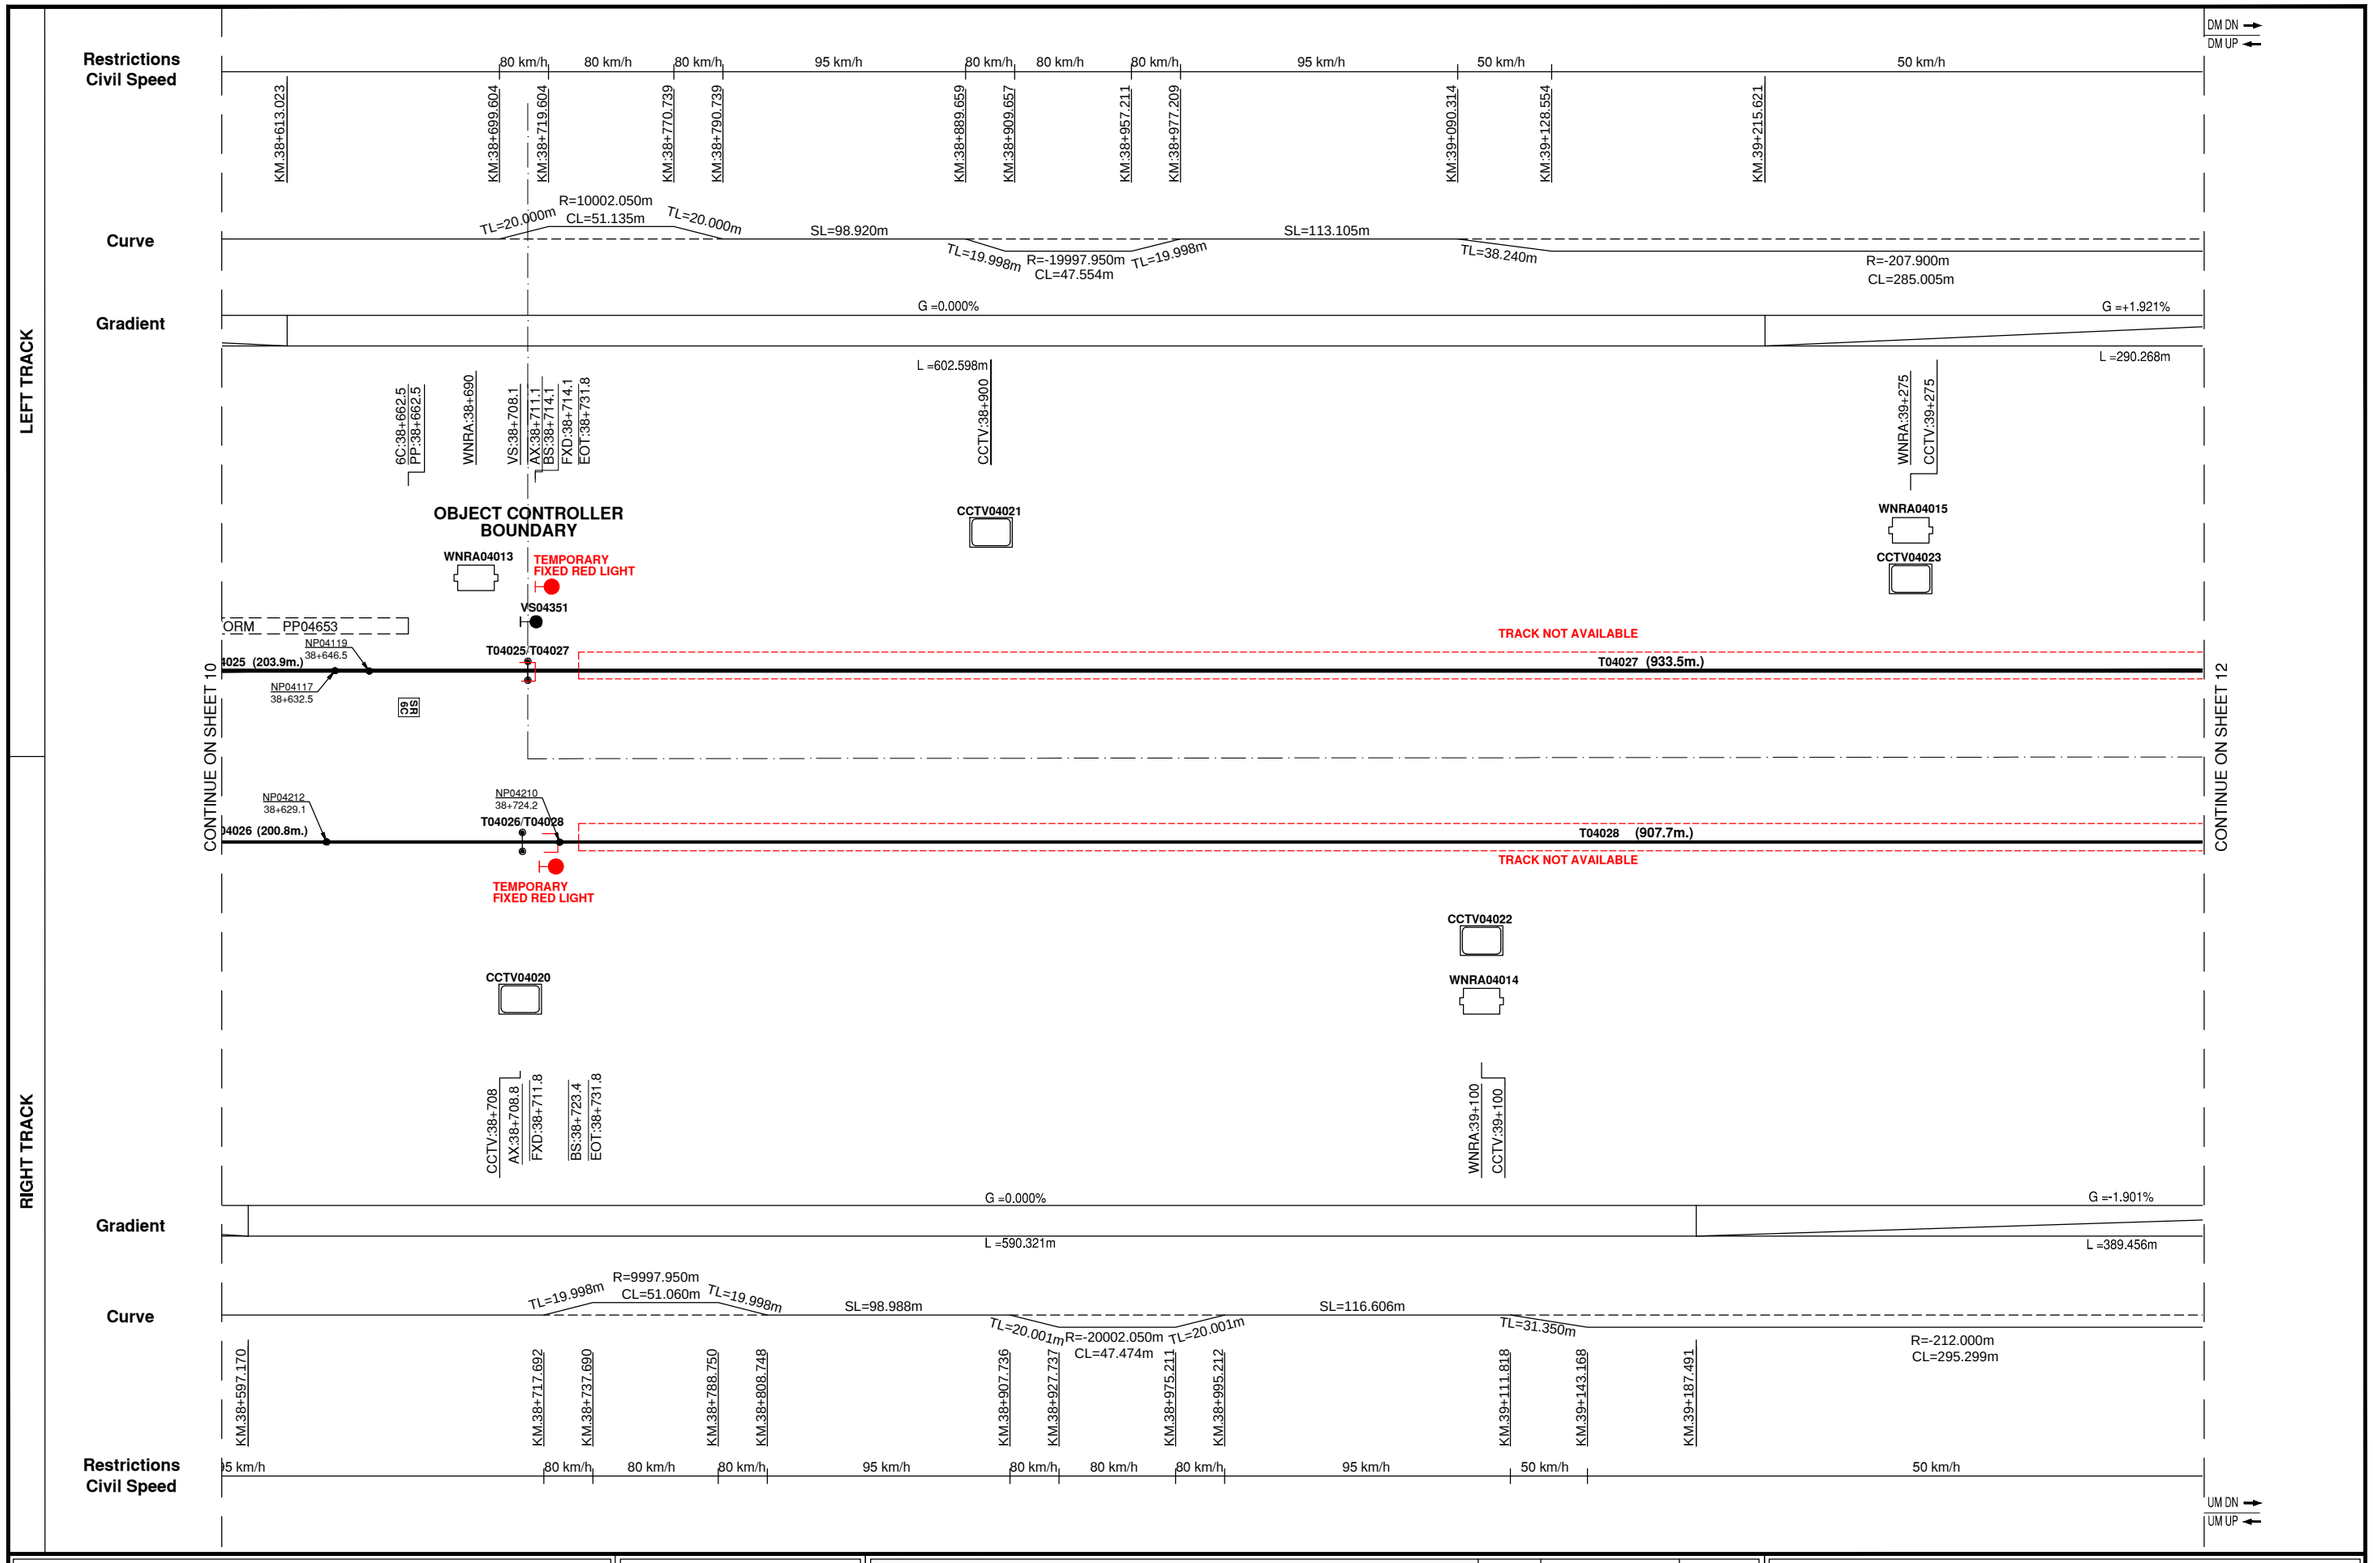

DELHI METRO RAIL CORPORATION LTD.
Metro Bhawan, Fire Brigade Lane, Barakhamba Road, New Delhi-110001

ORIGINATOR:
BOMBARDIER
the evolution of mobility

© 2019, Bombardier Inc.
All rights reserved.

AS-BUILT DRAWING

REV	DATE	DESCRIPTION
7.0	03-JUL-19	AS-BUILT DRAWING

	NAME	DATE
DESIGNED	SONAM R.	03-JUL-19
CHECKED	ASHOK K.	03-JUL-19
APPROVED	ROHIT T.	03-JUL-19

DRAWING TITLE: DELHI MRTS PROJECT PHASE III LINE 7
TRAIN CONTROL & SIGNALLING SYSTEM CONTRACT CS03
TRACK AND SIGNALLING PLAN LINE 7
MAYUR VIHAR TO MANDAWALI - WEST VINOD NAGAR STATION
SECTION-HI

DRAWING No:	COST CENTRE:	SCALE	SHEET	CONT.	REV.
100228105	B DETAILED DESIGN	N/S	11	12	7.0

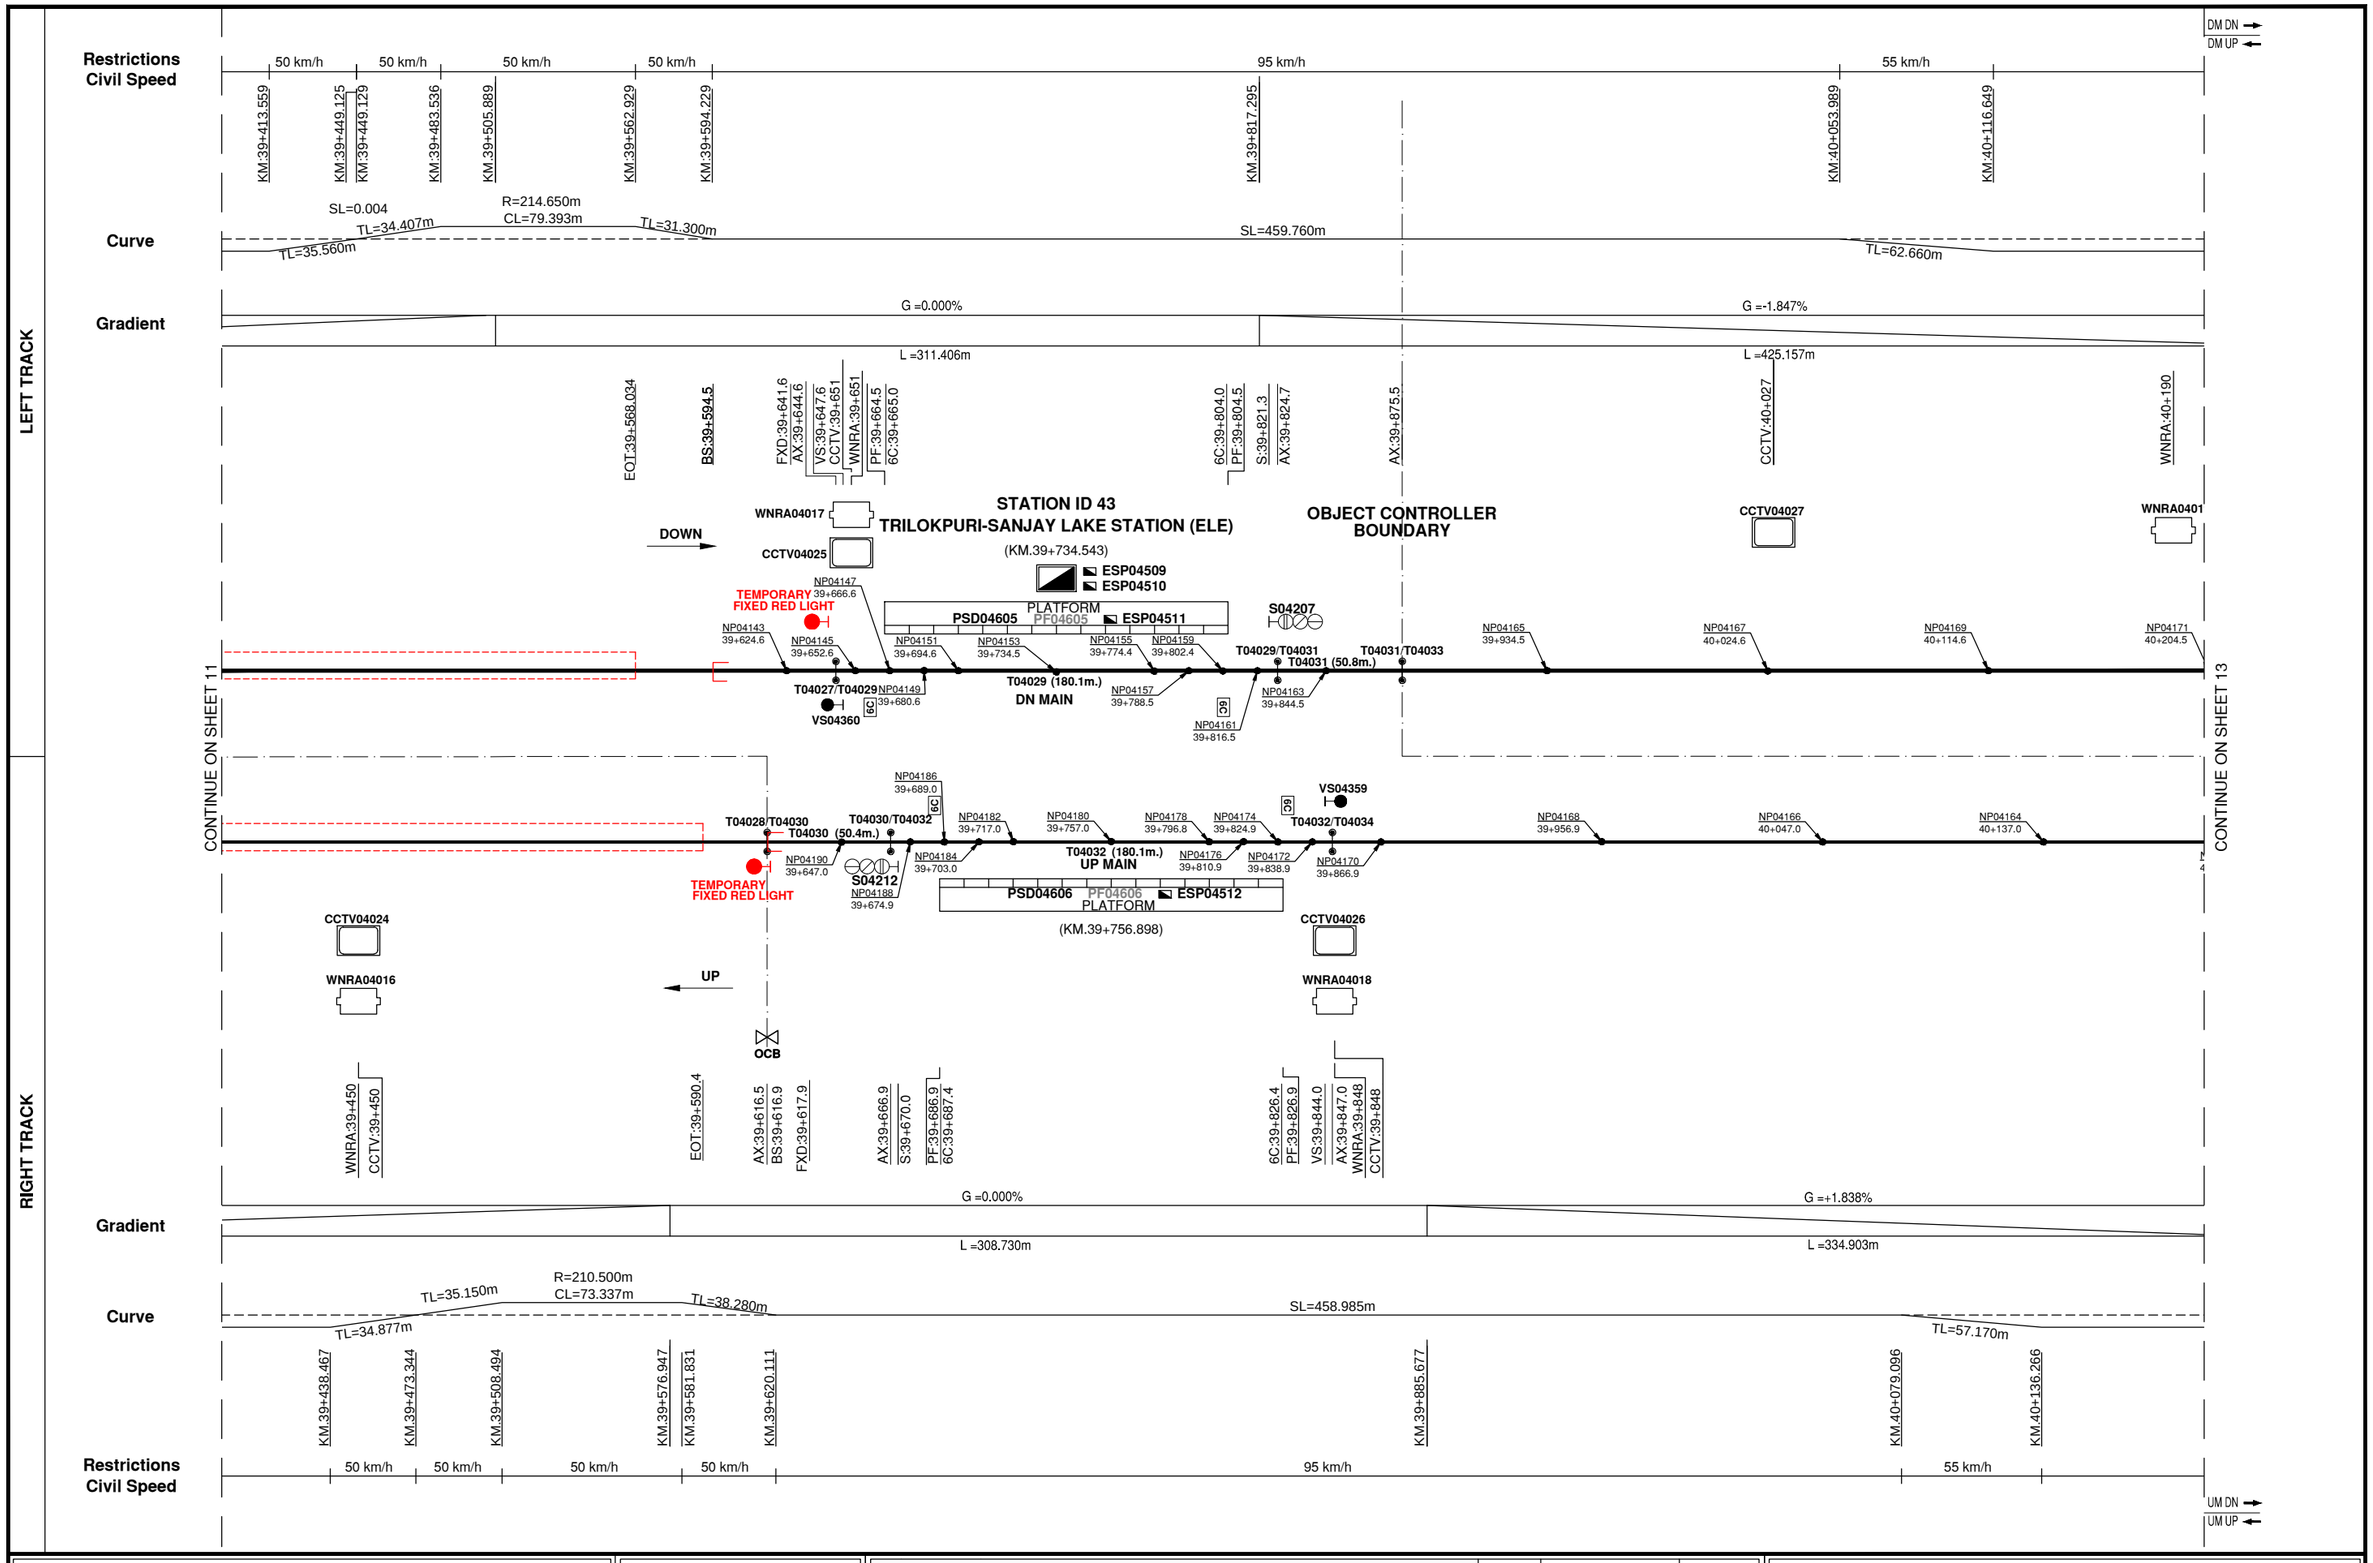

DELHI METRO RAIL CORPORATION LTD.
Metro Bhawan, Fire Brigade Lane, Barakhamba Road, New Delhi-110001

ORIGINATOR:
BOMBARDIER
the evolution of mobility

© 2019, Bombardier Inc.
All rights reserved.

AS-BUILT DRAWING

REV	DATE	DESCRIPTION
7.0	03-JUL-19	AS-BUILT DRAWING

	NAME	DATE
DESIGNED	SONAM R.	03-JUL-19
CHECKED	ASHOK K.	03-JUL-19
APPROVED	ROHIT T.	03-JUL-19

DRAWING TITLE: DELHI MRTS PROJECT PHASE III LINE 7
TRAIN CONTROL & SIGNALLING SYSTEM CONTRACT CS03
TRACK AND SIGNALLING PLAN LINE 7
MAYUR VIHAR TO MANDAWALI - WEST VINOD NAGAR STATION
SECTION-HI

DRAWING No:	COST CENTRE:	SCALE	SHEET	CONT.	REV.
100228105	B DETAILED DESIGN	N/S	12	13	7.0

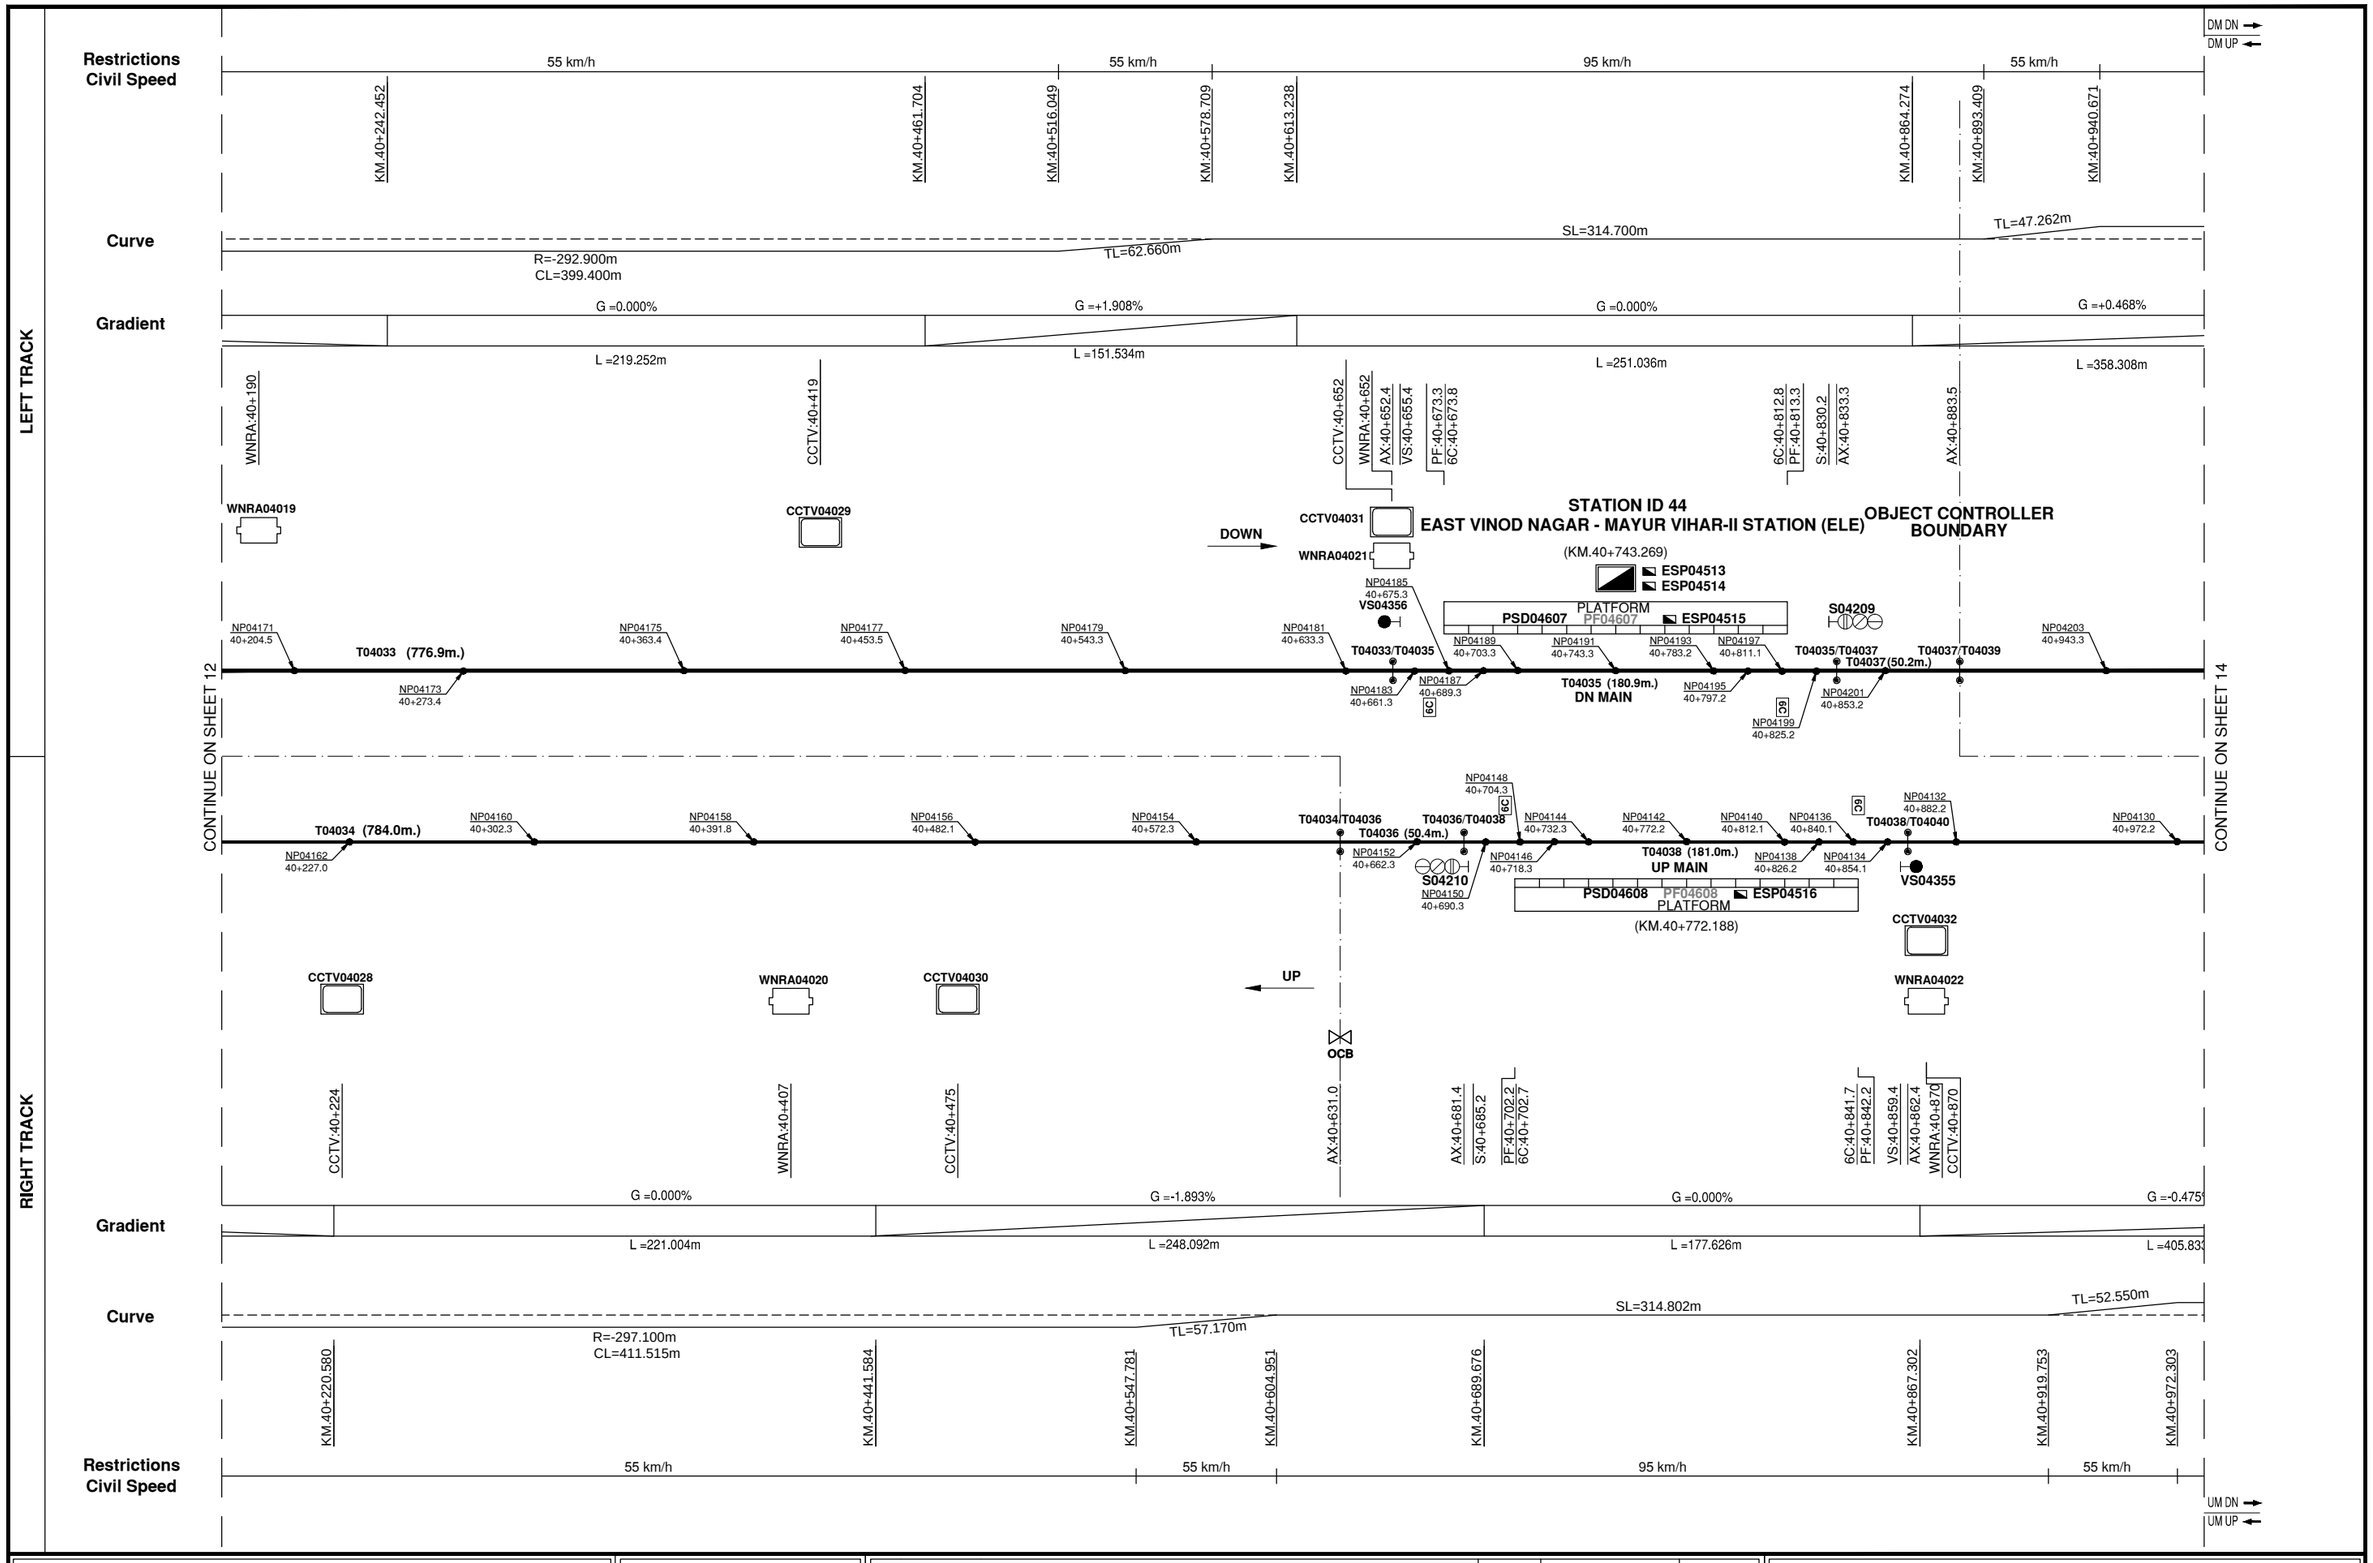

DELHI METRO RAIL CORPORATION LTD.
Metro Bhawan, Fire Brigade Lane, Barakhamba Road, New Delhi-110001

ORIGINATOR:
BOMBARDIER
the evolution of mobility

© 2019, Bombardier Inc.
All rights reserved.

AS-BUILT DRAWING

REV	DATE	DESCRIPTION
7.0	03-JUL-19	AS-BUILT DRAWING

	NAME	DATE
DESIGNED	SONAM R.	03-JUL-19
CHECKED	ASHOK K.	03-JUL-19
APPROVED	ROHIT T.	03-JUL-19

DRAWING TITLE: DELHI MRTS PROJECT PHASE III LINE 7
TRAIN CONTROL & SIGNALLING SYSTEM CONTRACT CS03
TRACK AND SIGNALLING PLAN LINE 7
MAYUR VIHAR TO MANDAWALI - WEST VINOD NAGAR STATION
SECTION-HI

DRAWING No:	COST CENTRE:	SCALE	SHEET	CONT.	REV.
100228105	B DETAILED DESIGN	N/S	13	14	7.0

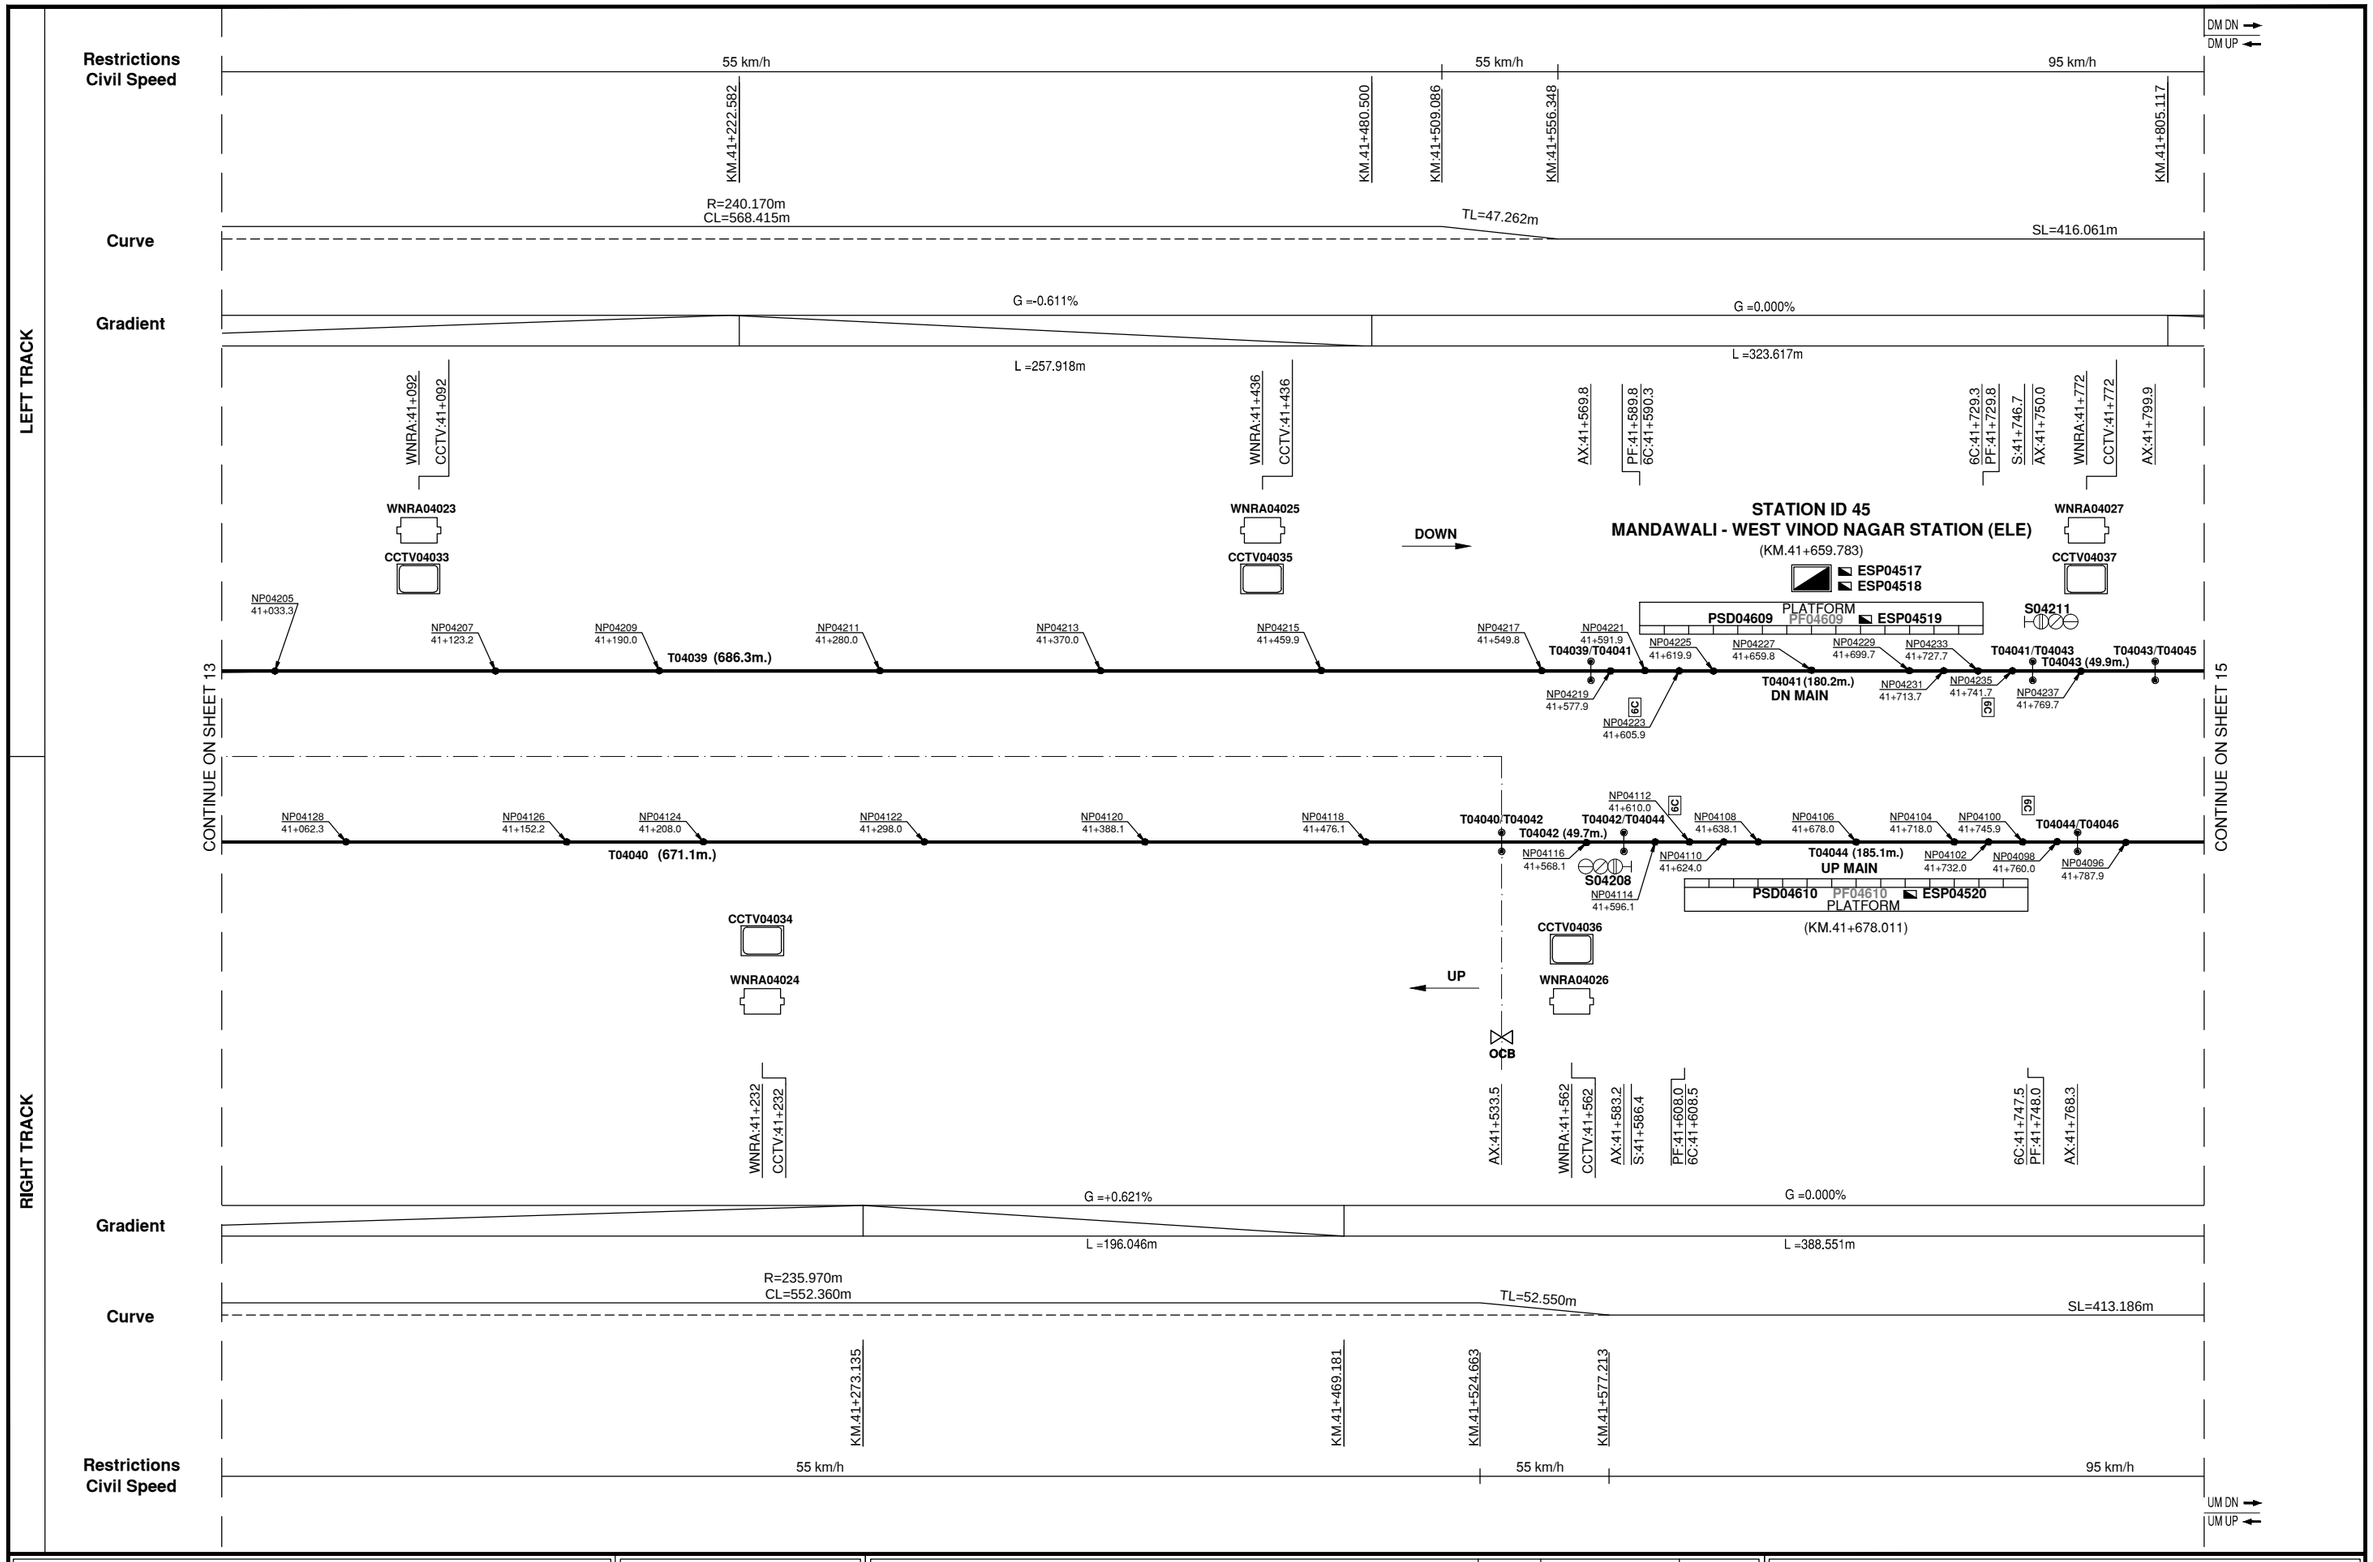

DELHI METRO RAIL CORPORATION LTD.
Metro Bhawan, Fire Brigade Lane, Barakhamba Road, New Delhi-110001

ORIGINATOR:
BOMBARDIER
the evolution of mobility

© 2019, Bombardier Inc.
All rights reserved.

AS-BUILT DRAWING

REV	DATE	DESCRIPTION
7.0	03-JUL-19	AS-BUILT DRAWING

	NAME	DATE
DESIGNED	SONAM R.	03-JUL-19
CHECKED	ASHOK K.	03-JUL-19
APPROVED	ROHIT T.	03-JUL-19

DRAWING TITLE: DELHI MRTS PROJECT PHASE III LINE 7
TRAIN CONTROL & SIGNALLING SYSTEM CONTRACT CS03
TRACK AND SIGNALLING PLAN LINE 7
MAYUR VIHAR TO MANDAWALI - WEST VINOD NAGAR STATION
SECTION-HI

DRAWING No:	COST CENTRE:	SCALE	SHEET	CONT.	REV.
100228105	B DETAILED DESIGN	N/S	14	15	7.0

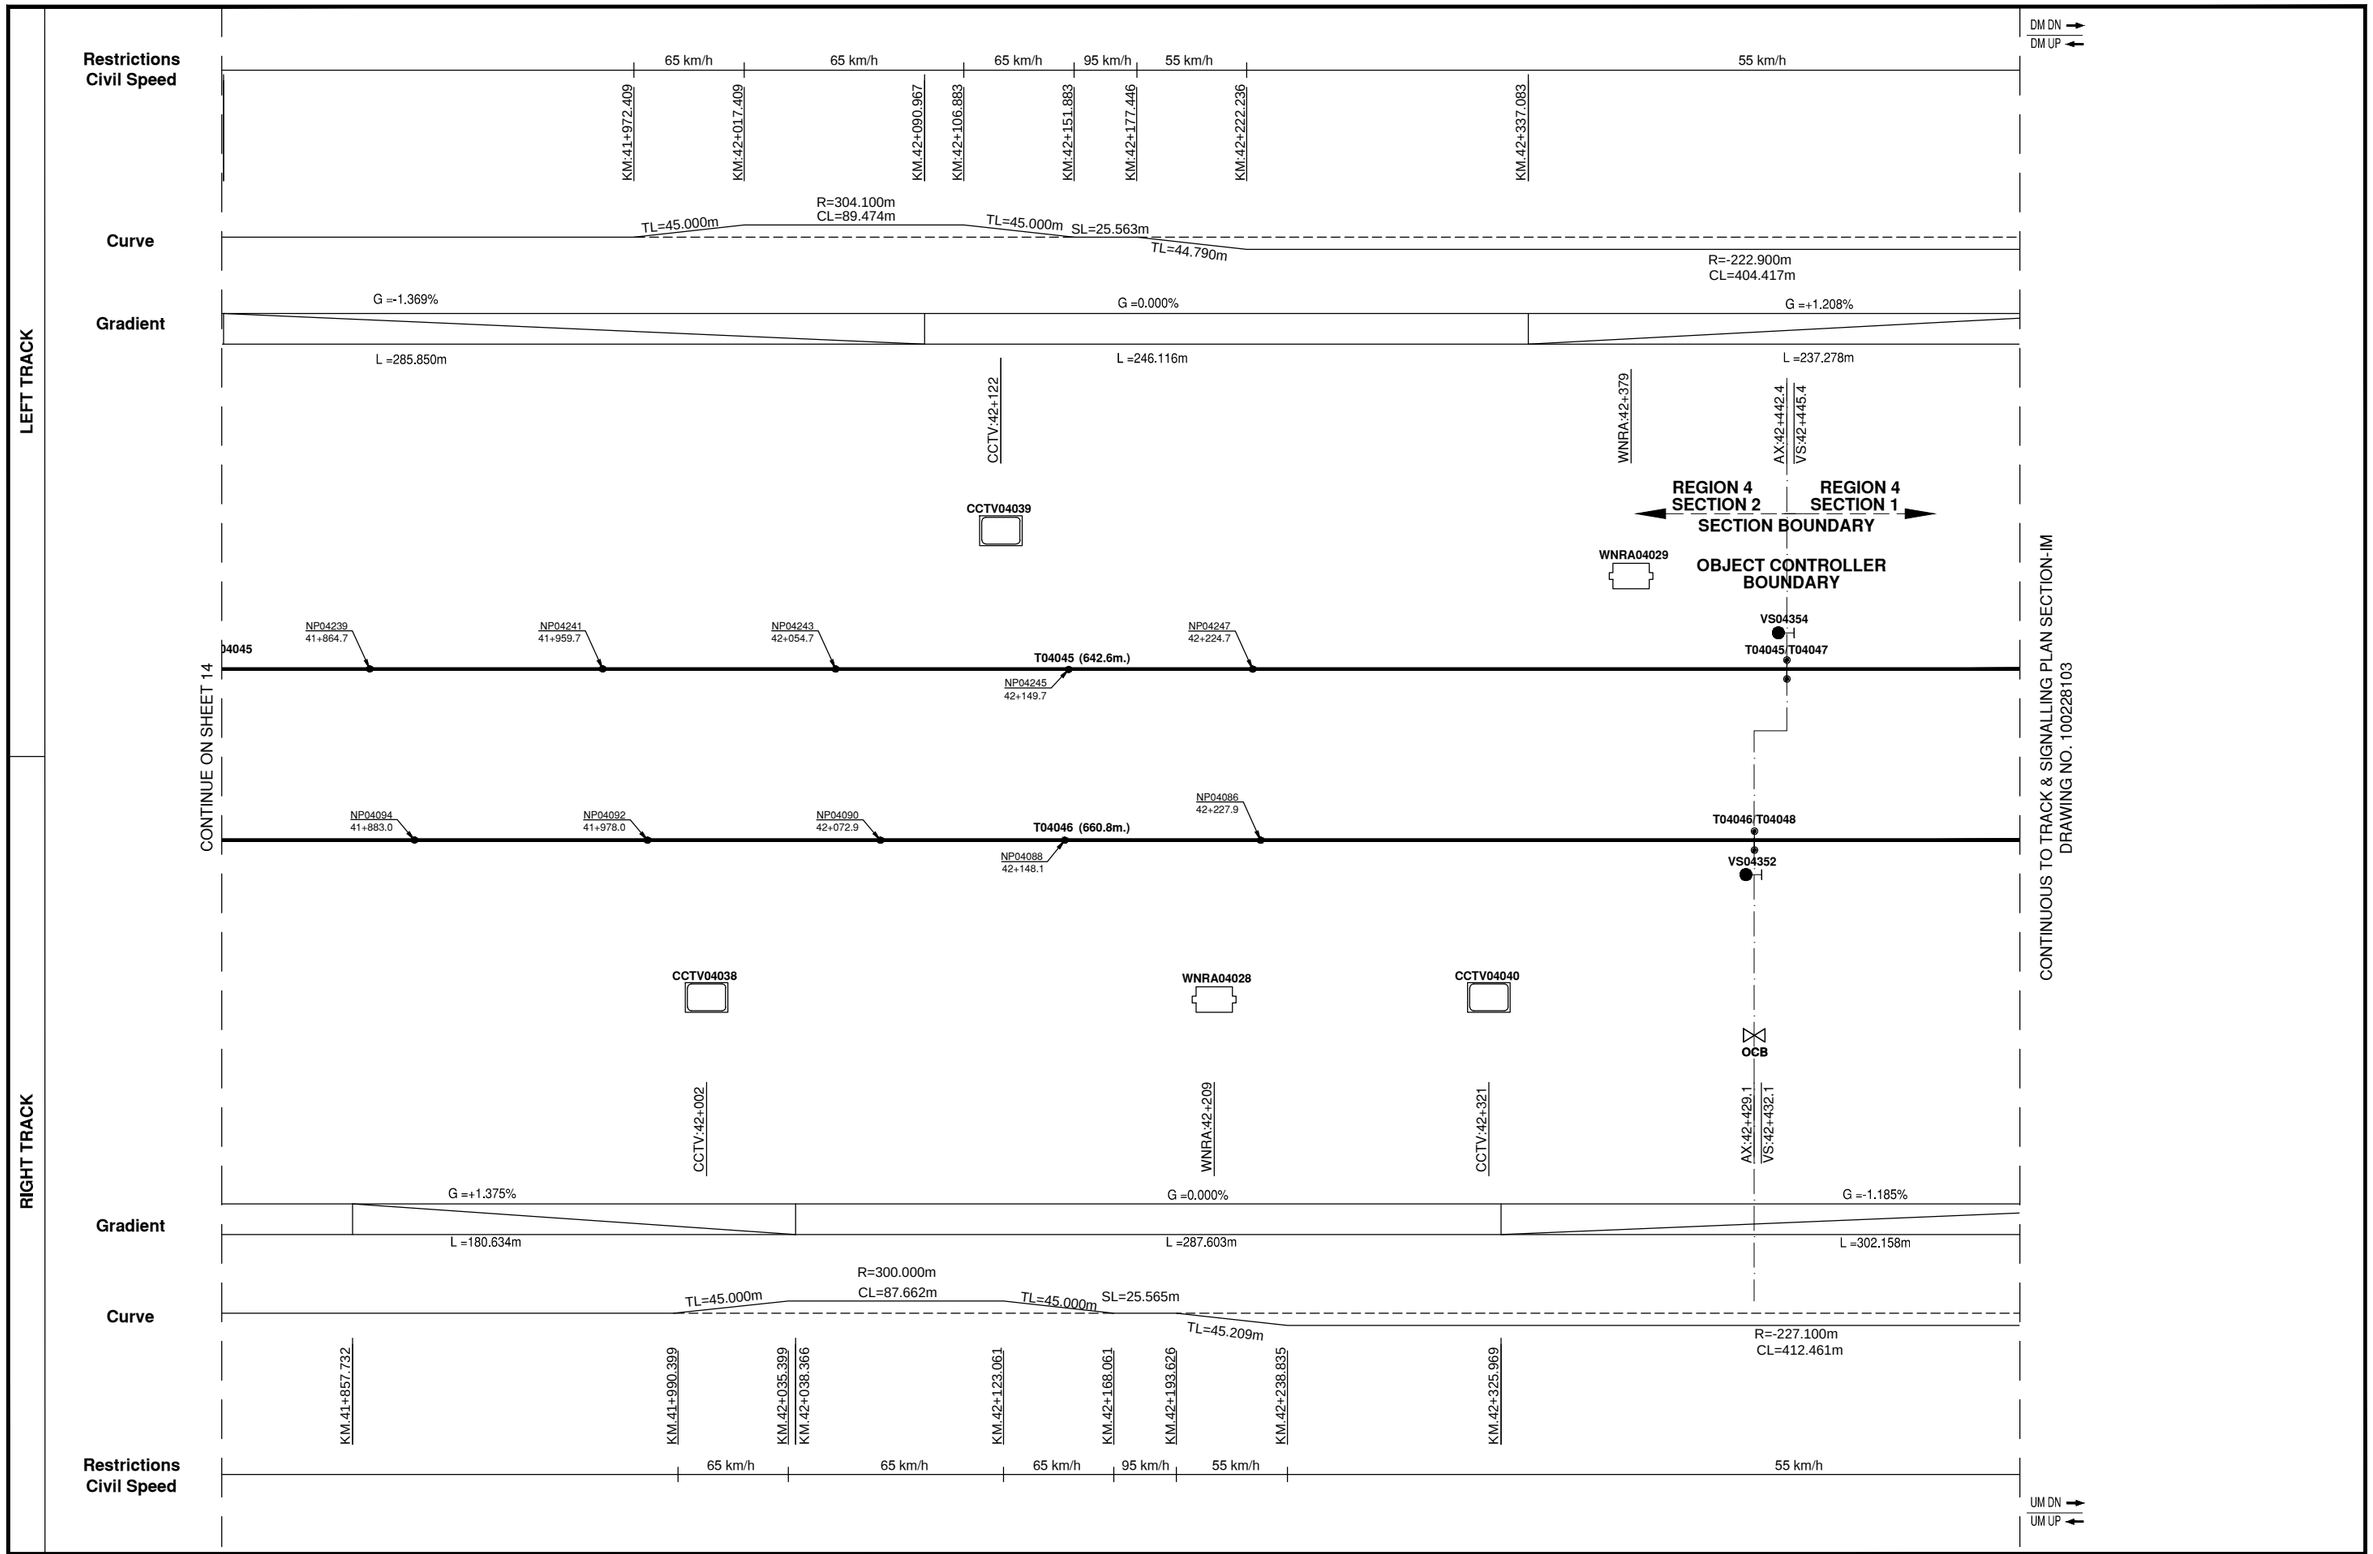

DELHI METRO RAIL CORPORATION LTD.
Metro Bhawan, Fire Brigade Lane, Barakhamba Road, New Delhi-110001

ORIGINATOR:
BOMBARDIER
the evolution of mobility

© 2019, Bombardier Inc. All rights reserved.

AS-BUILT DRAWING

REV	DATE	DESCRIPTION
7.0	03–JUL–19	AS–BUILT DRAWING

	NAME	DATE
DESIGNED	SONAM R.	03–JUL–19
CHECKED	ASHOK K.	03–JUL–19
APPROVED	ROHIT T.	03–JUL–19

DRAWING TITLE:
DELHI MRTS PROJECT PHASE III LINE 7
TRAIN CONTROL & SIGNALLING SYSTEM CONTRACT CS03
TRACK AND SIGNALLING PLAN LINE 7
MAYUR VIHAR TO MANDAWALI - WEST VINOD NAGAR STATION
SECTION-HI

DRAWING No:	COST CENTRE:	SCALE	SHEET	CONT.	REV.
100228105	B DETAILED DESIGN	N/S	15	16	7.0

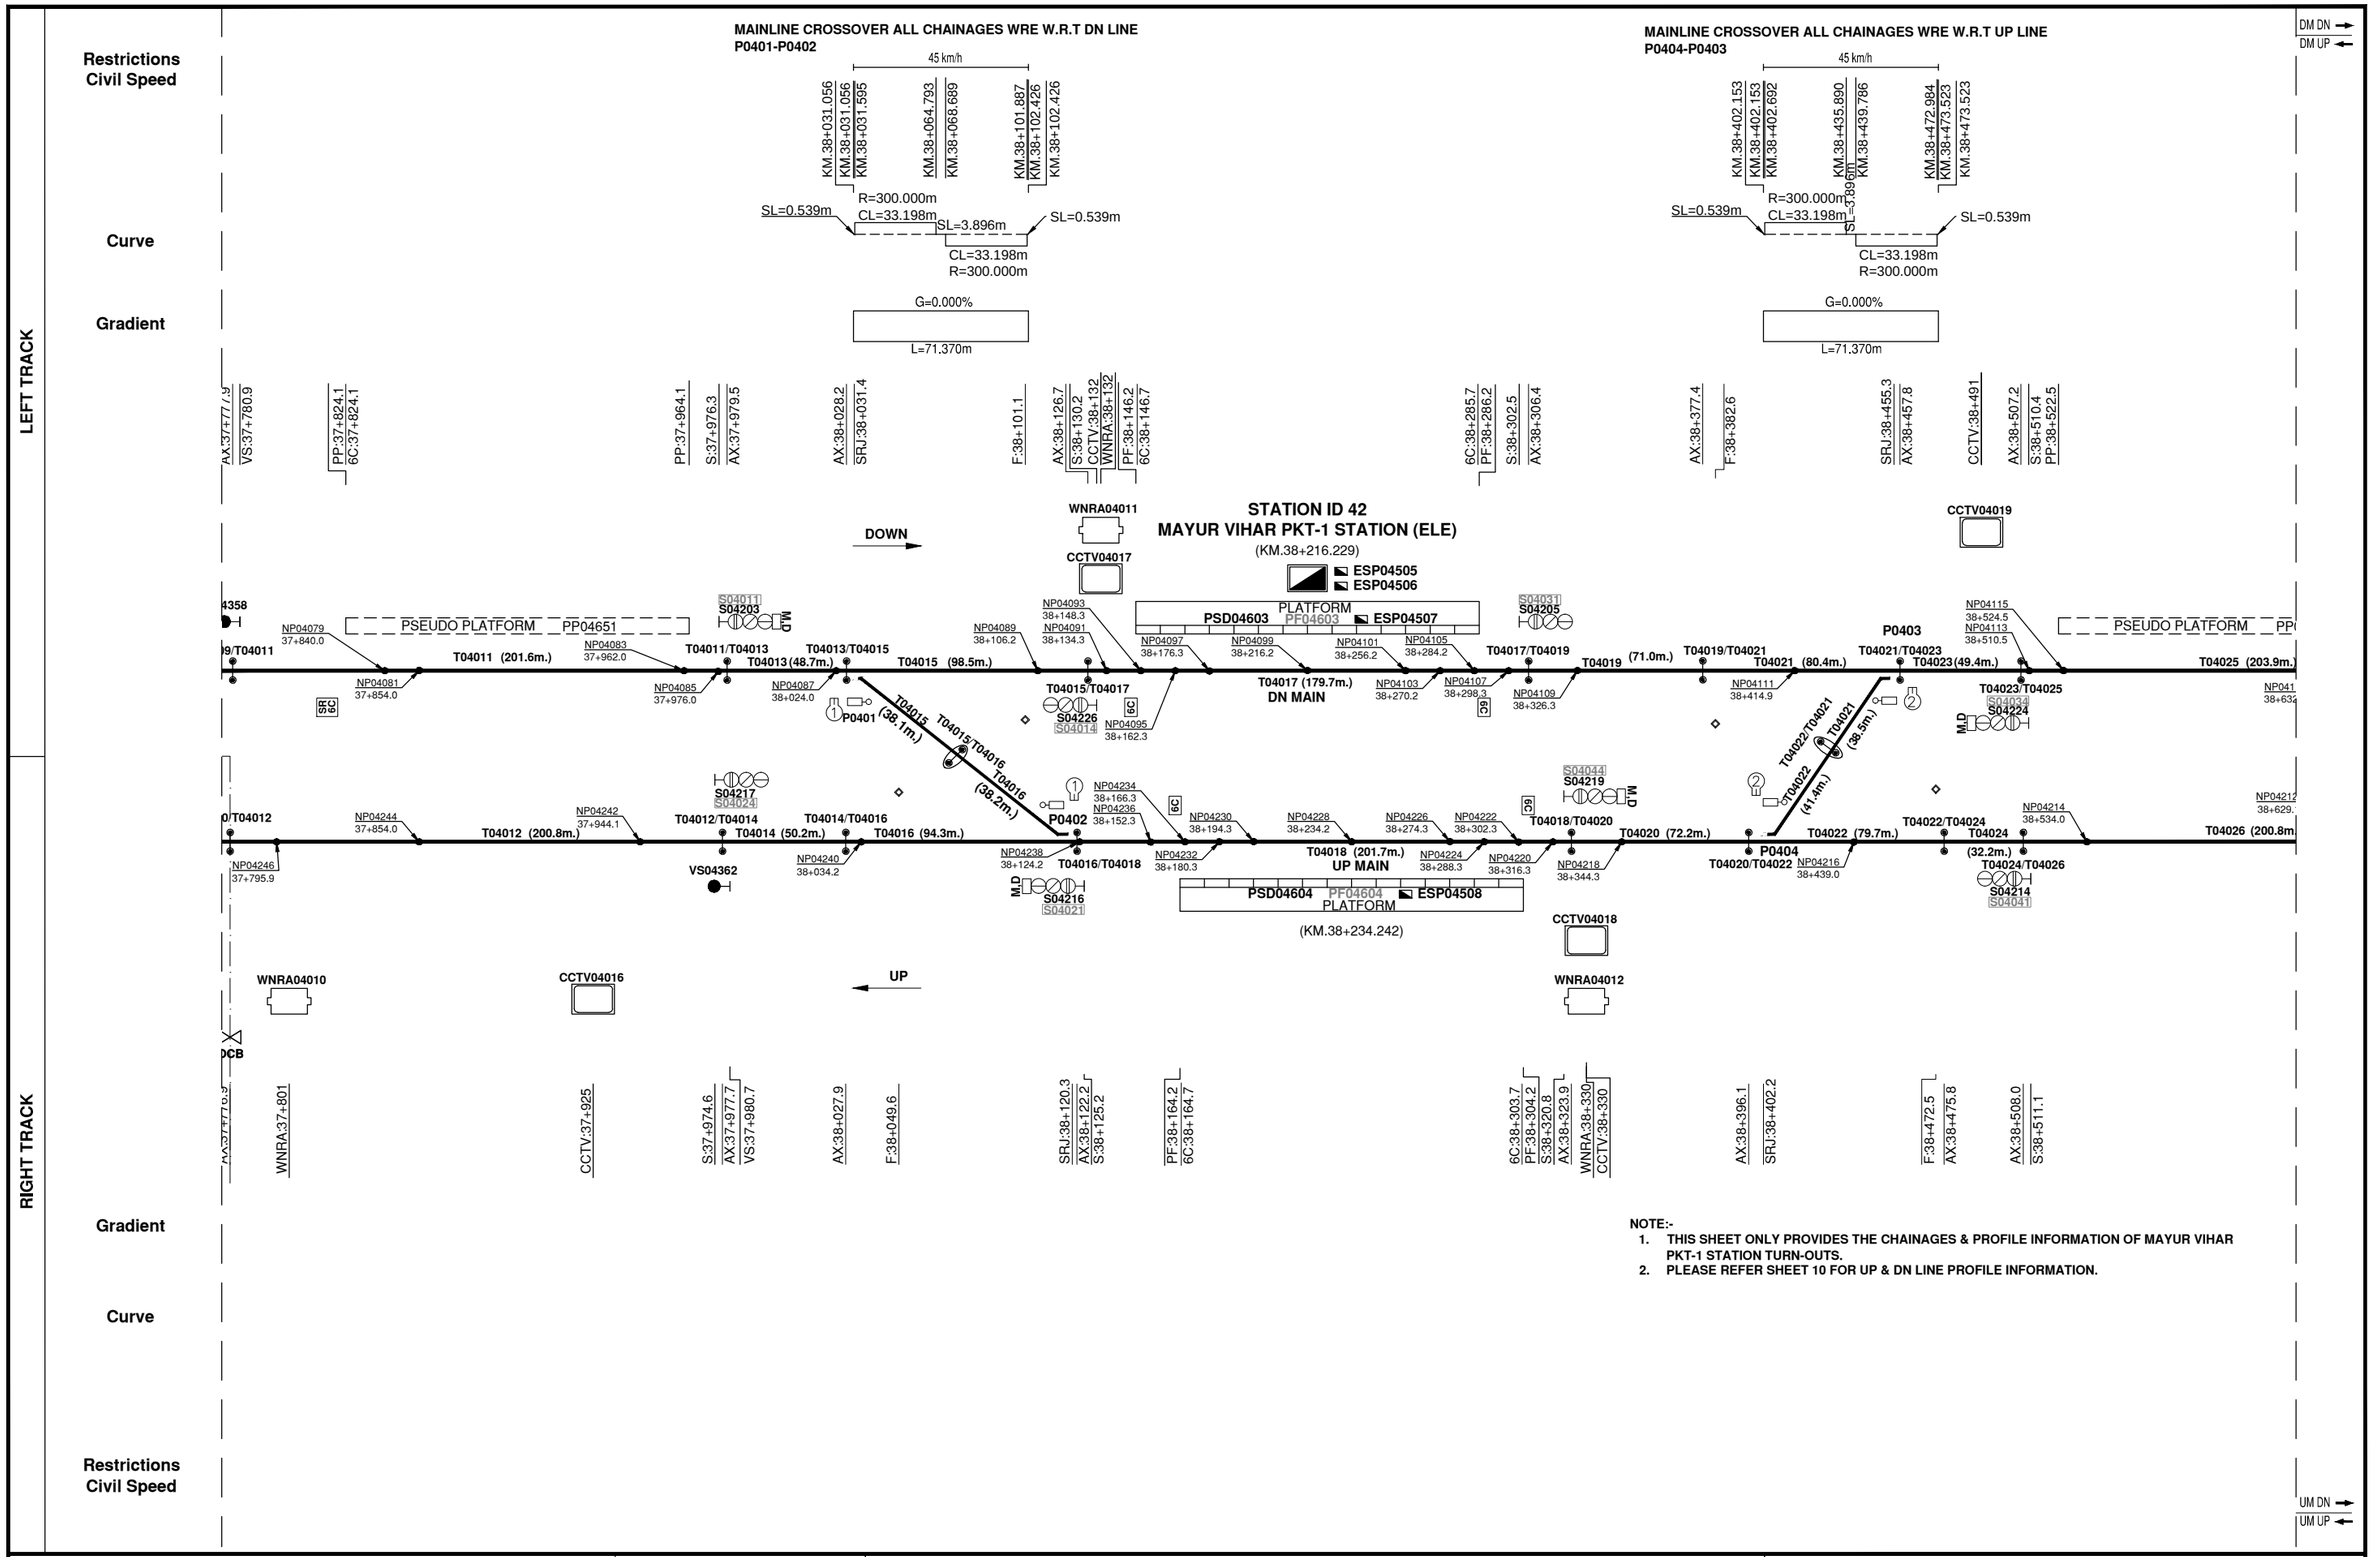

NOTE:-

1. THIS SHEET ONLY PROVIDES THE CHAINAGES & PROFILE INFORMATION OF MAYUR VIHAR PKT-1 STATION TURN-OUTS.
2. PLEASE REFER SHEET 10 FOR UP & DN LINE PROFILE INFORMATION.

DELHI METRO RAIL CORPORATION LTD.
Metro Bhawan, Fire Brigade Lane, Barakhamba Road, New Delhi-110001

ORIGINATOR:
BOMBARDIER
the evolution of mobility

© 2019, Bombardier Inc.
All rights reserved.

AS-BUILT DRAWING

REV	DATE	DESCRIPTION
7.0	03-JUL-19	AS-BUILT DRAWING

	NAME	DATE
DESIGNED	SONAM R.	03-JUL-19
CHECKED	ASHOK K.	03-JUL-19
APPROVED	ROHIT T.	03-JUL-19

DRAWING TITLE:
DELHI MRTS PROJECT PHASE III LINE 7
TRAIN CONTROL & SIGNALLING SYSTEM CONTRACT CS03
TRACK AND SIGNALLING PLAN LINE 7
MAYUR VIHAR TO MANDAWALI - WEST VINOD NAGAR STATION
SECTION-HI

DRAWING No:	COST CENTRE:	SCALE	SHEET	CONT.	REV.
100228105	B DETAILED DESIGN	N/S	16	-	7.0

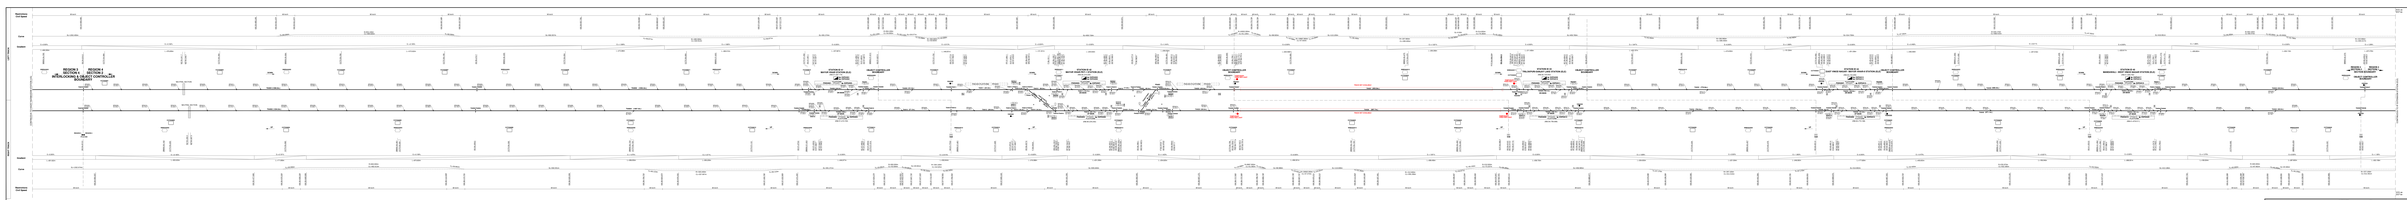
SECTION 1
SECTION 2
SECTION